


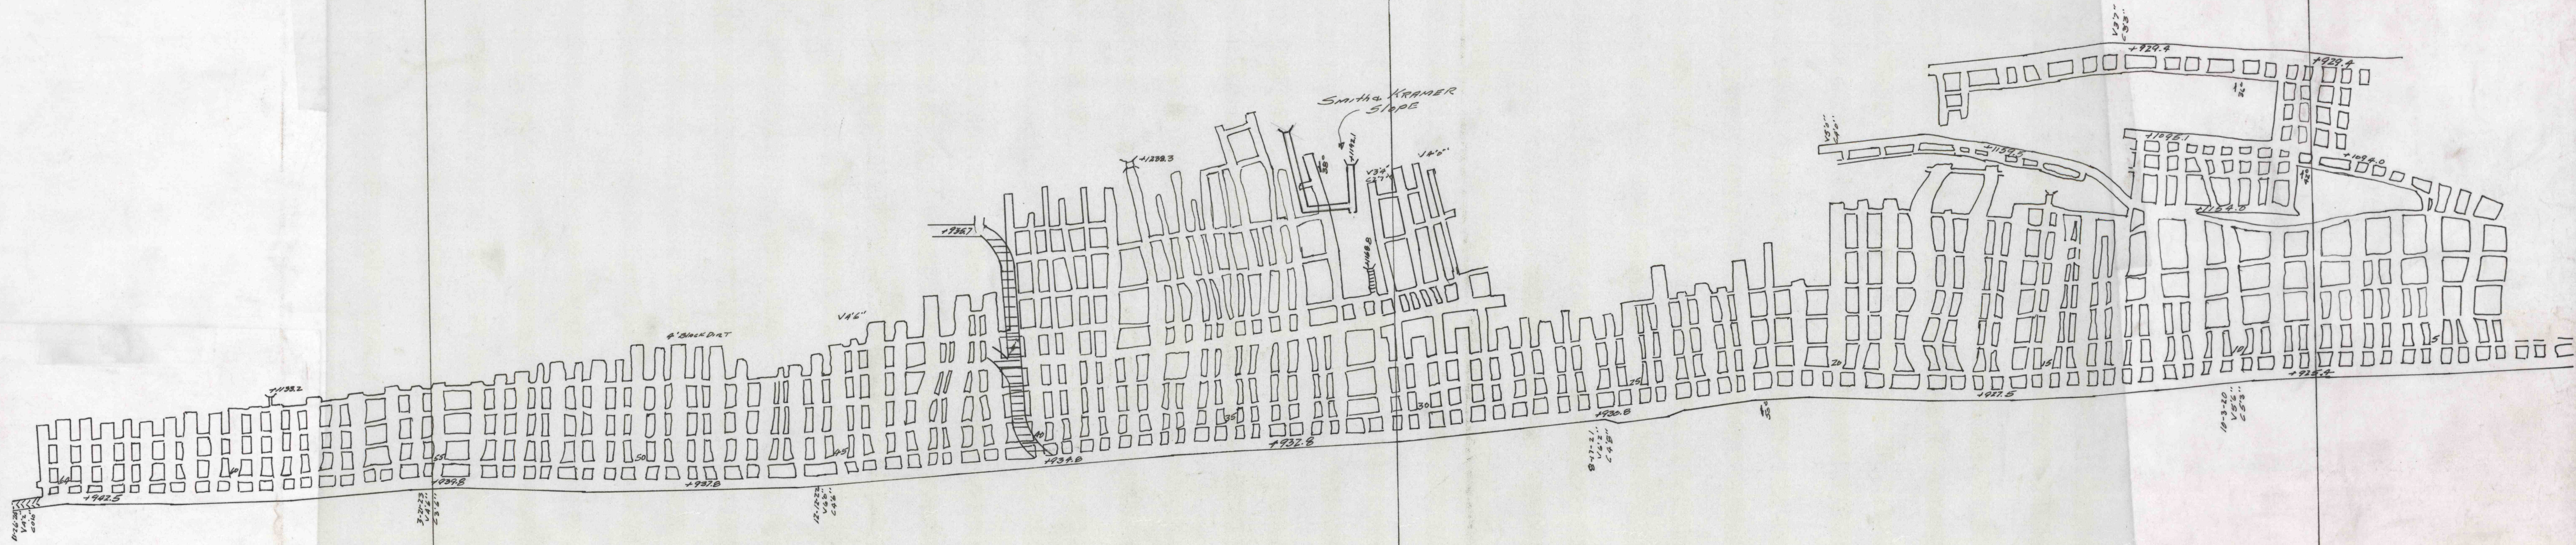

Sept 97

Sect 130