


ST. CLAIR

Cross - Sections


THRU MATTHEWS ESTATE

SCALE - 1" = 100' - POTTSVILLE, PENNA. - MAY 27, 1921


G. A. ROOS, D.E.

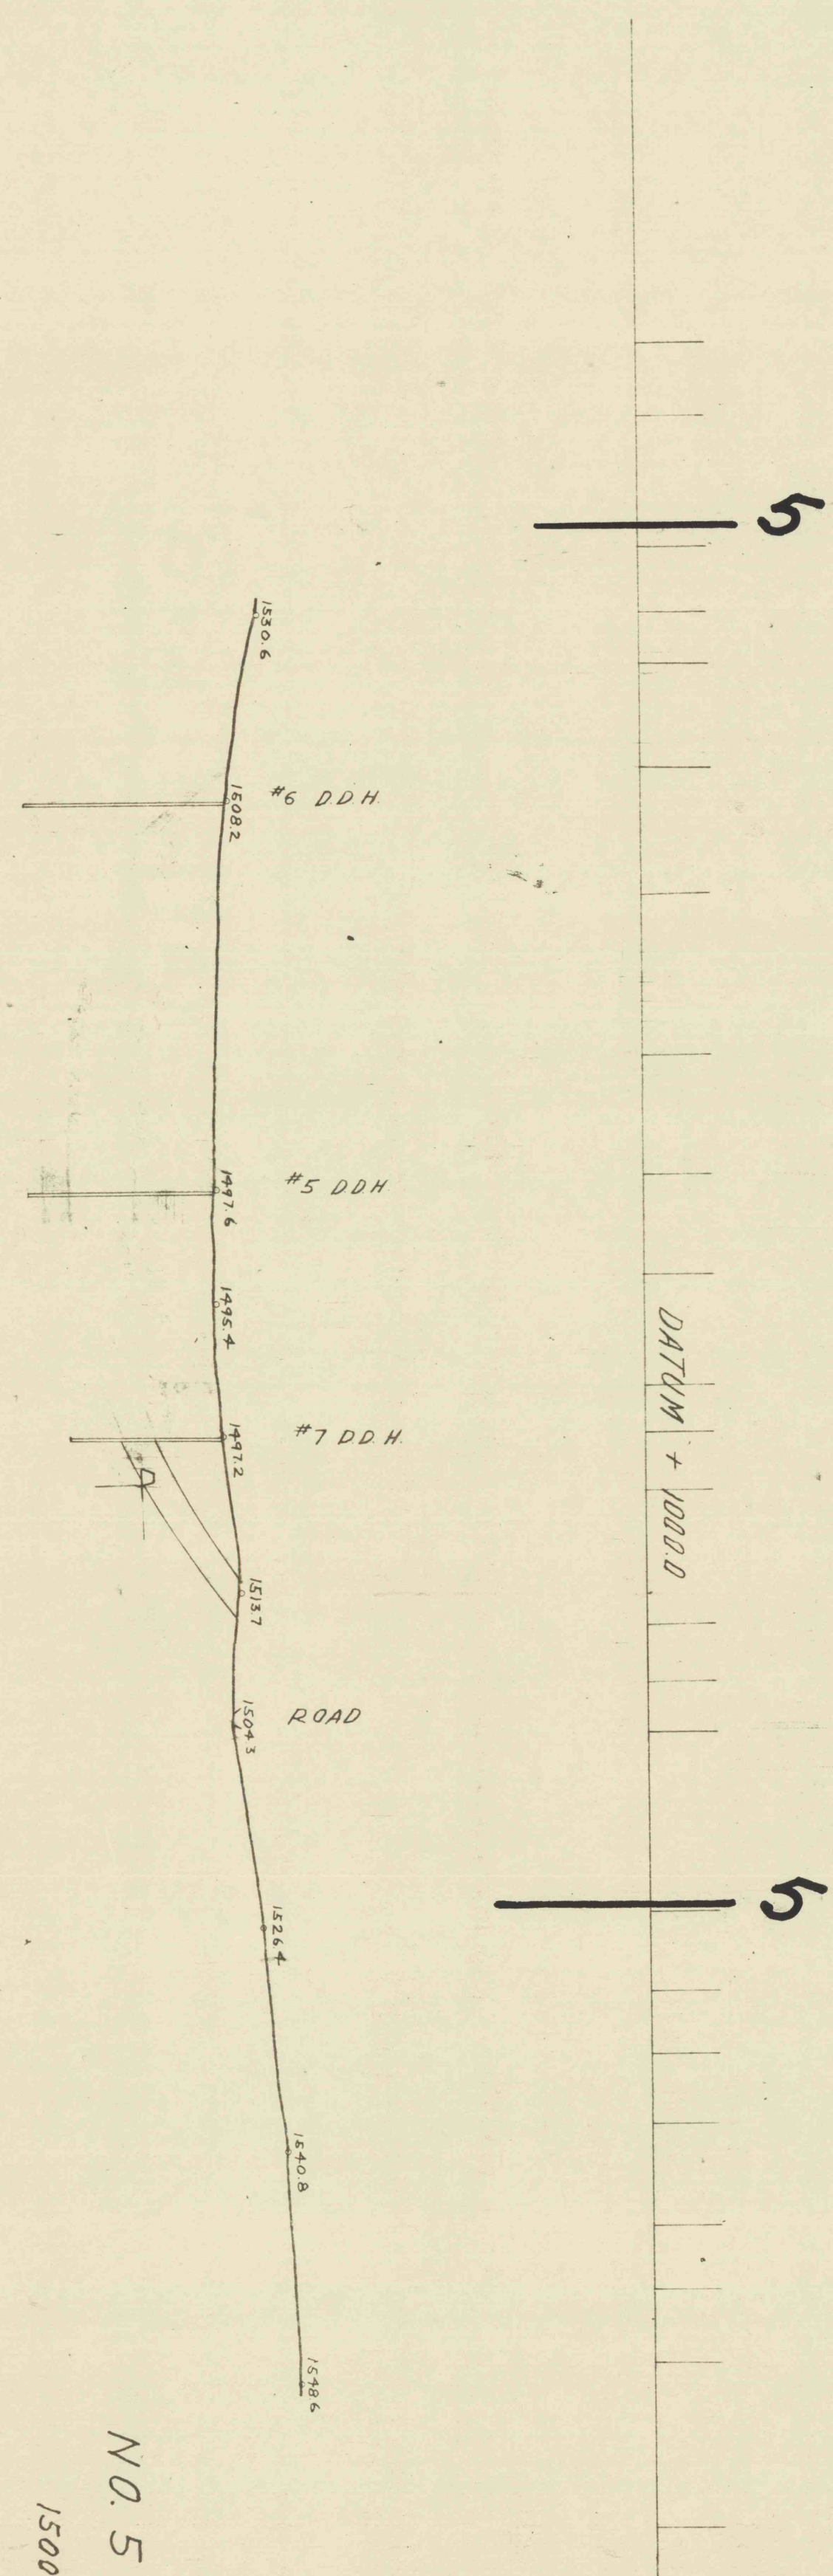


NO. 5 CROSS - SECTION
1500' East of West Land Line.

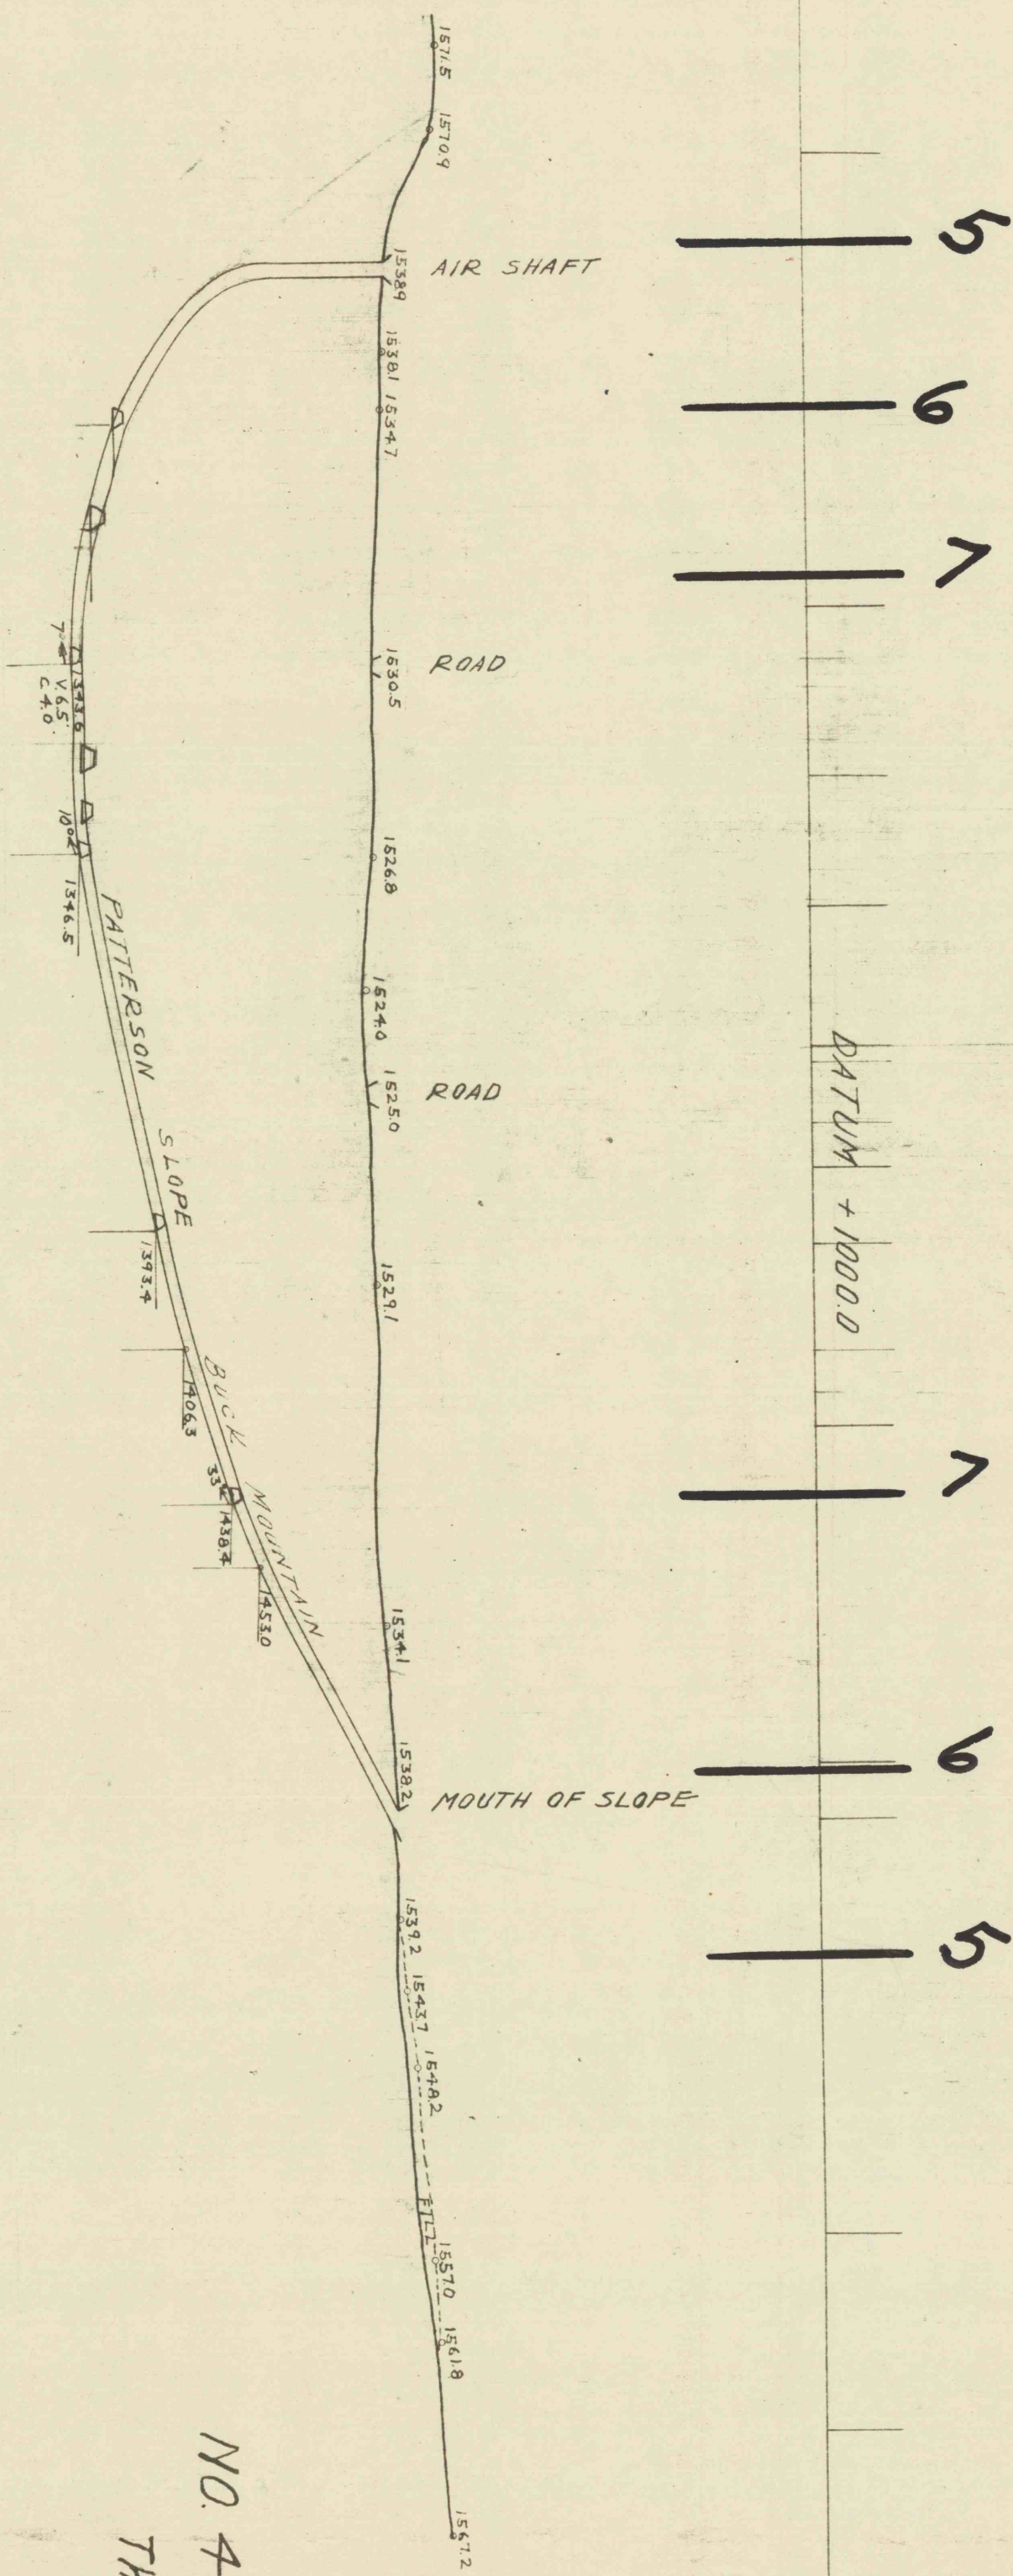


NO. 4 CROSS - SECTION
Through Patterson Slope.

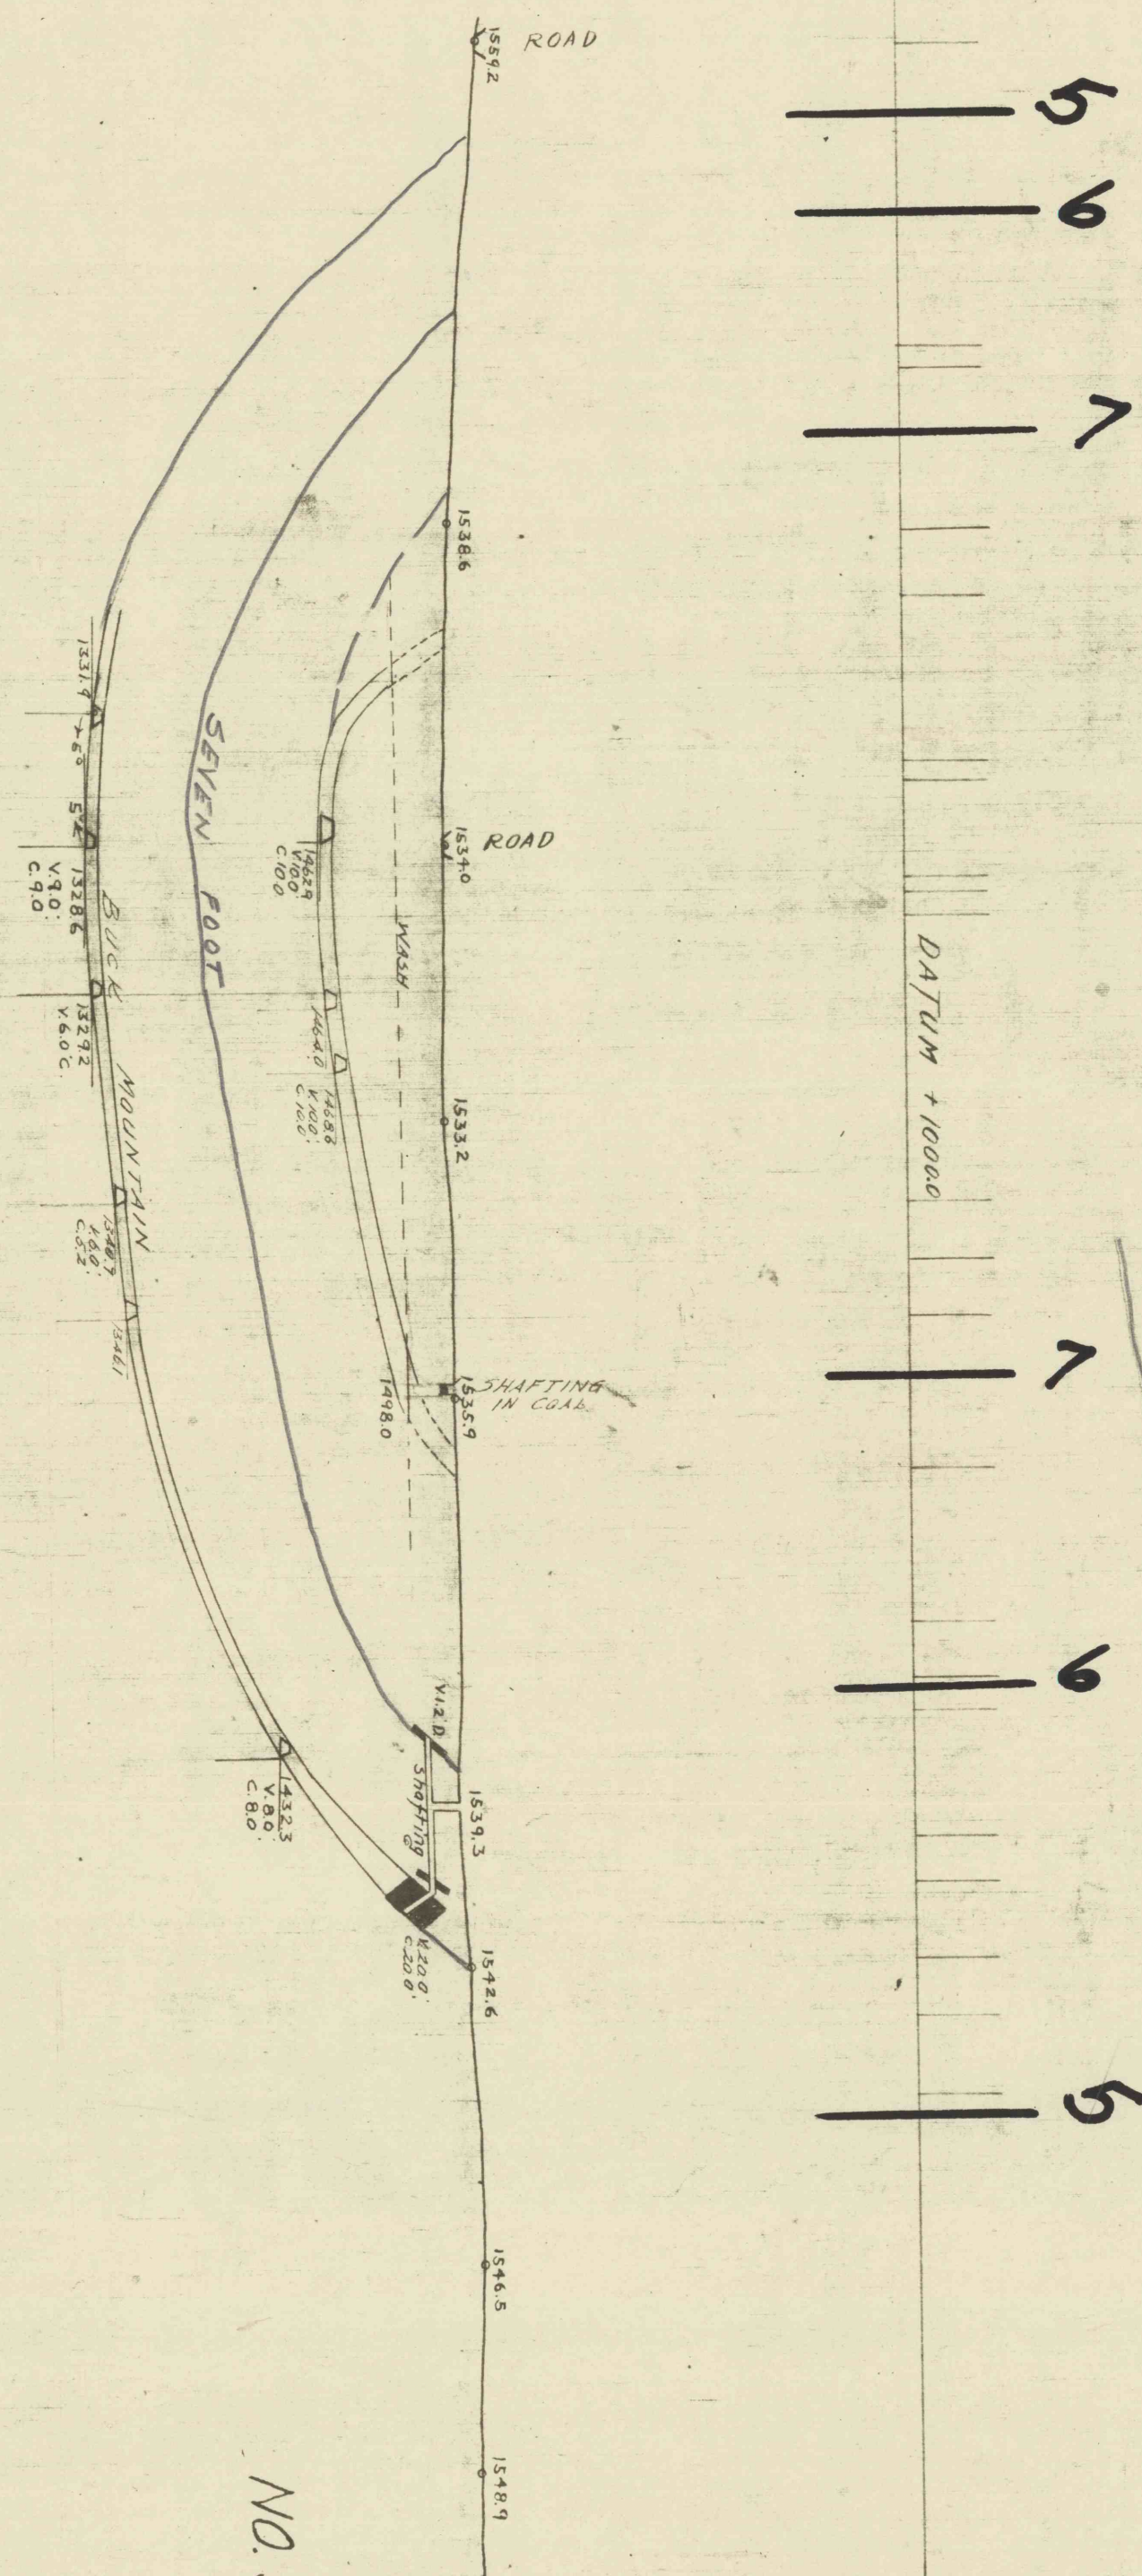

NO. 3 CROSS - SECTION
650' West of Main Slope.

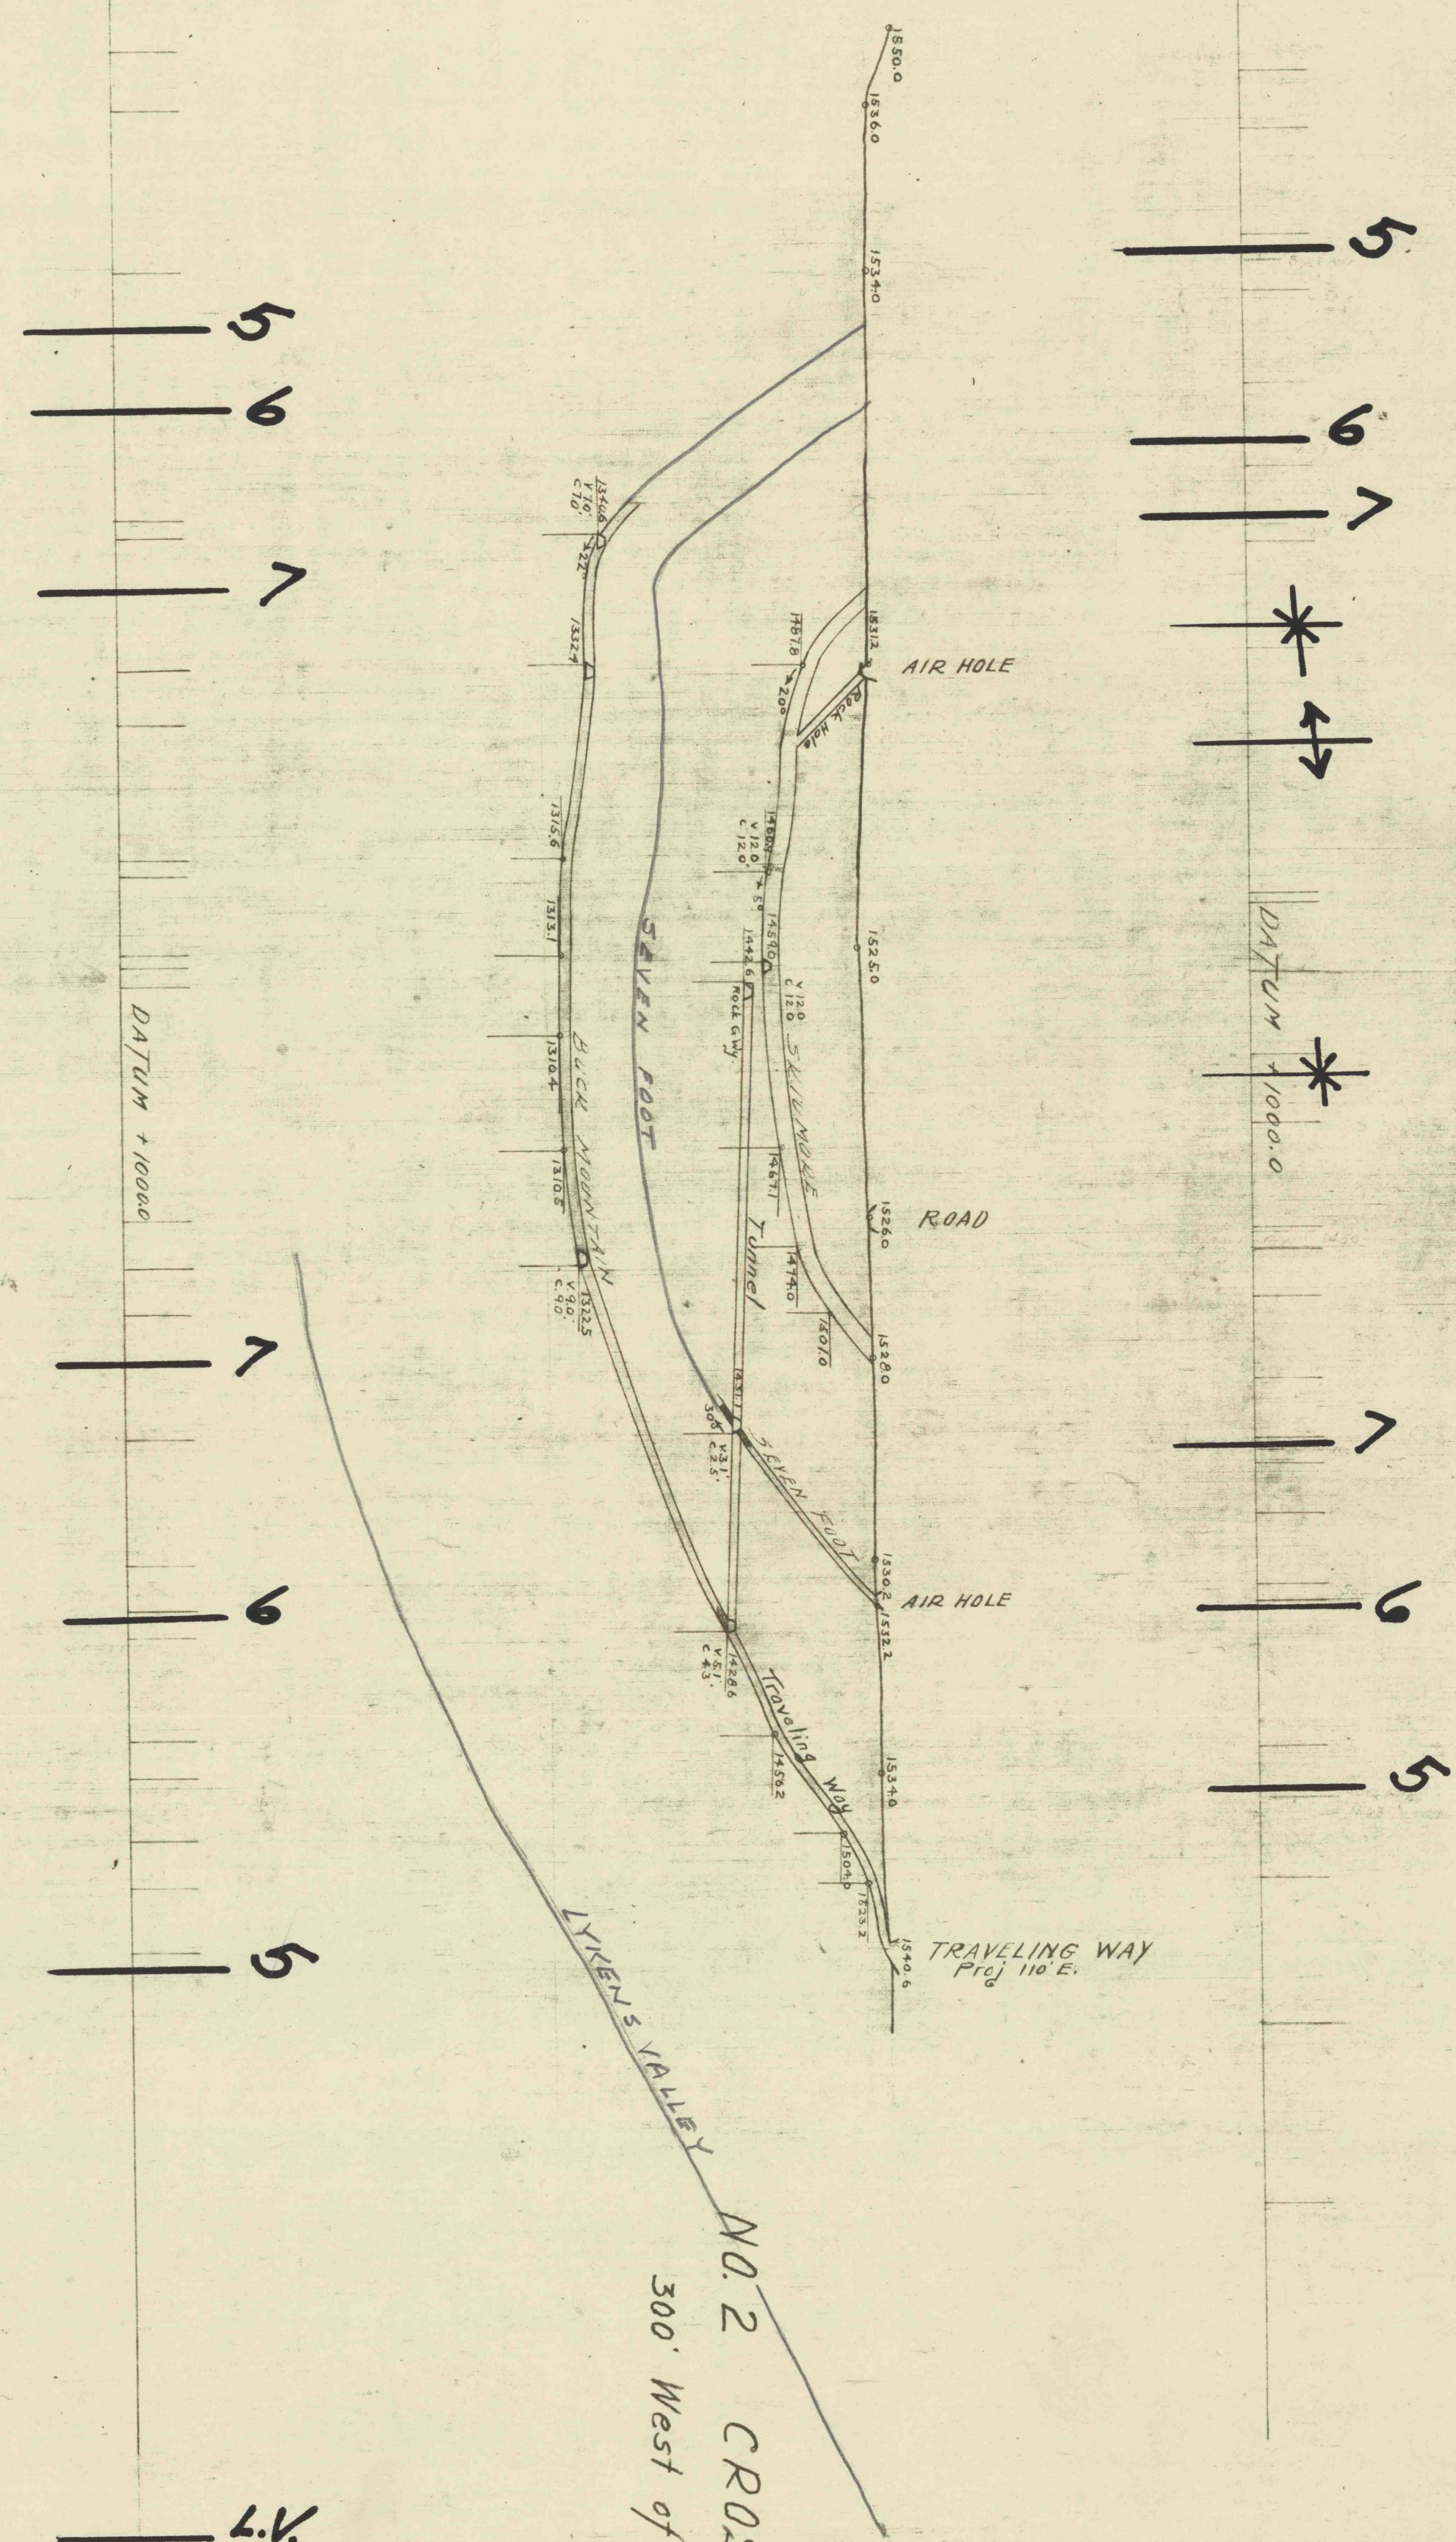

NO. 2 CROSS - SECTION
300' West of Main Slope.

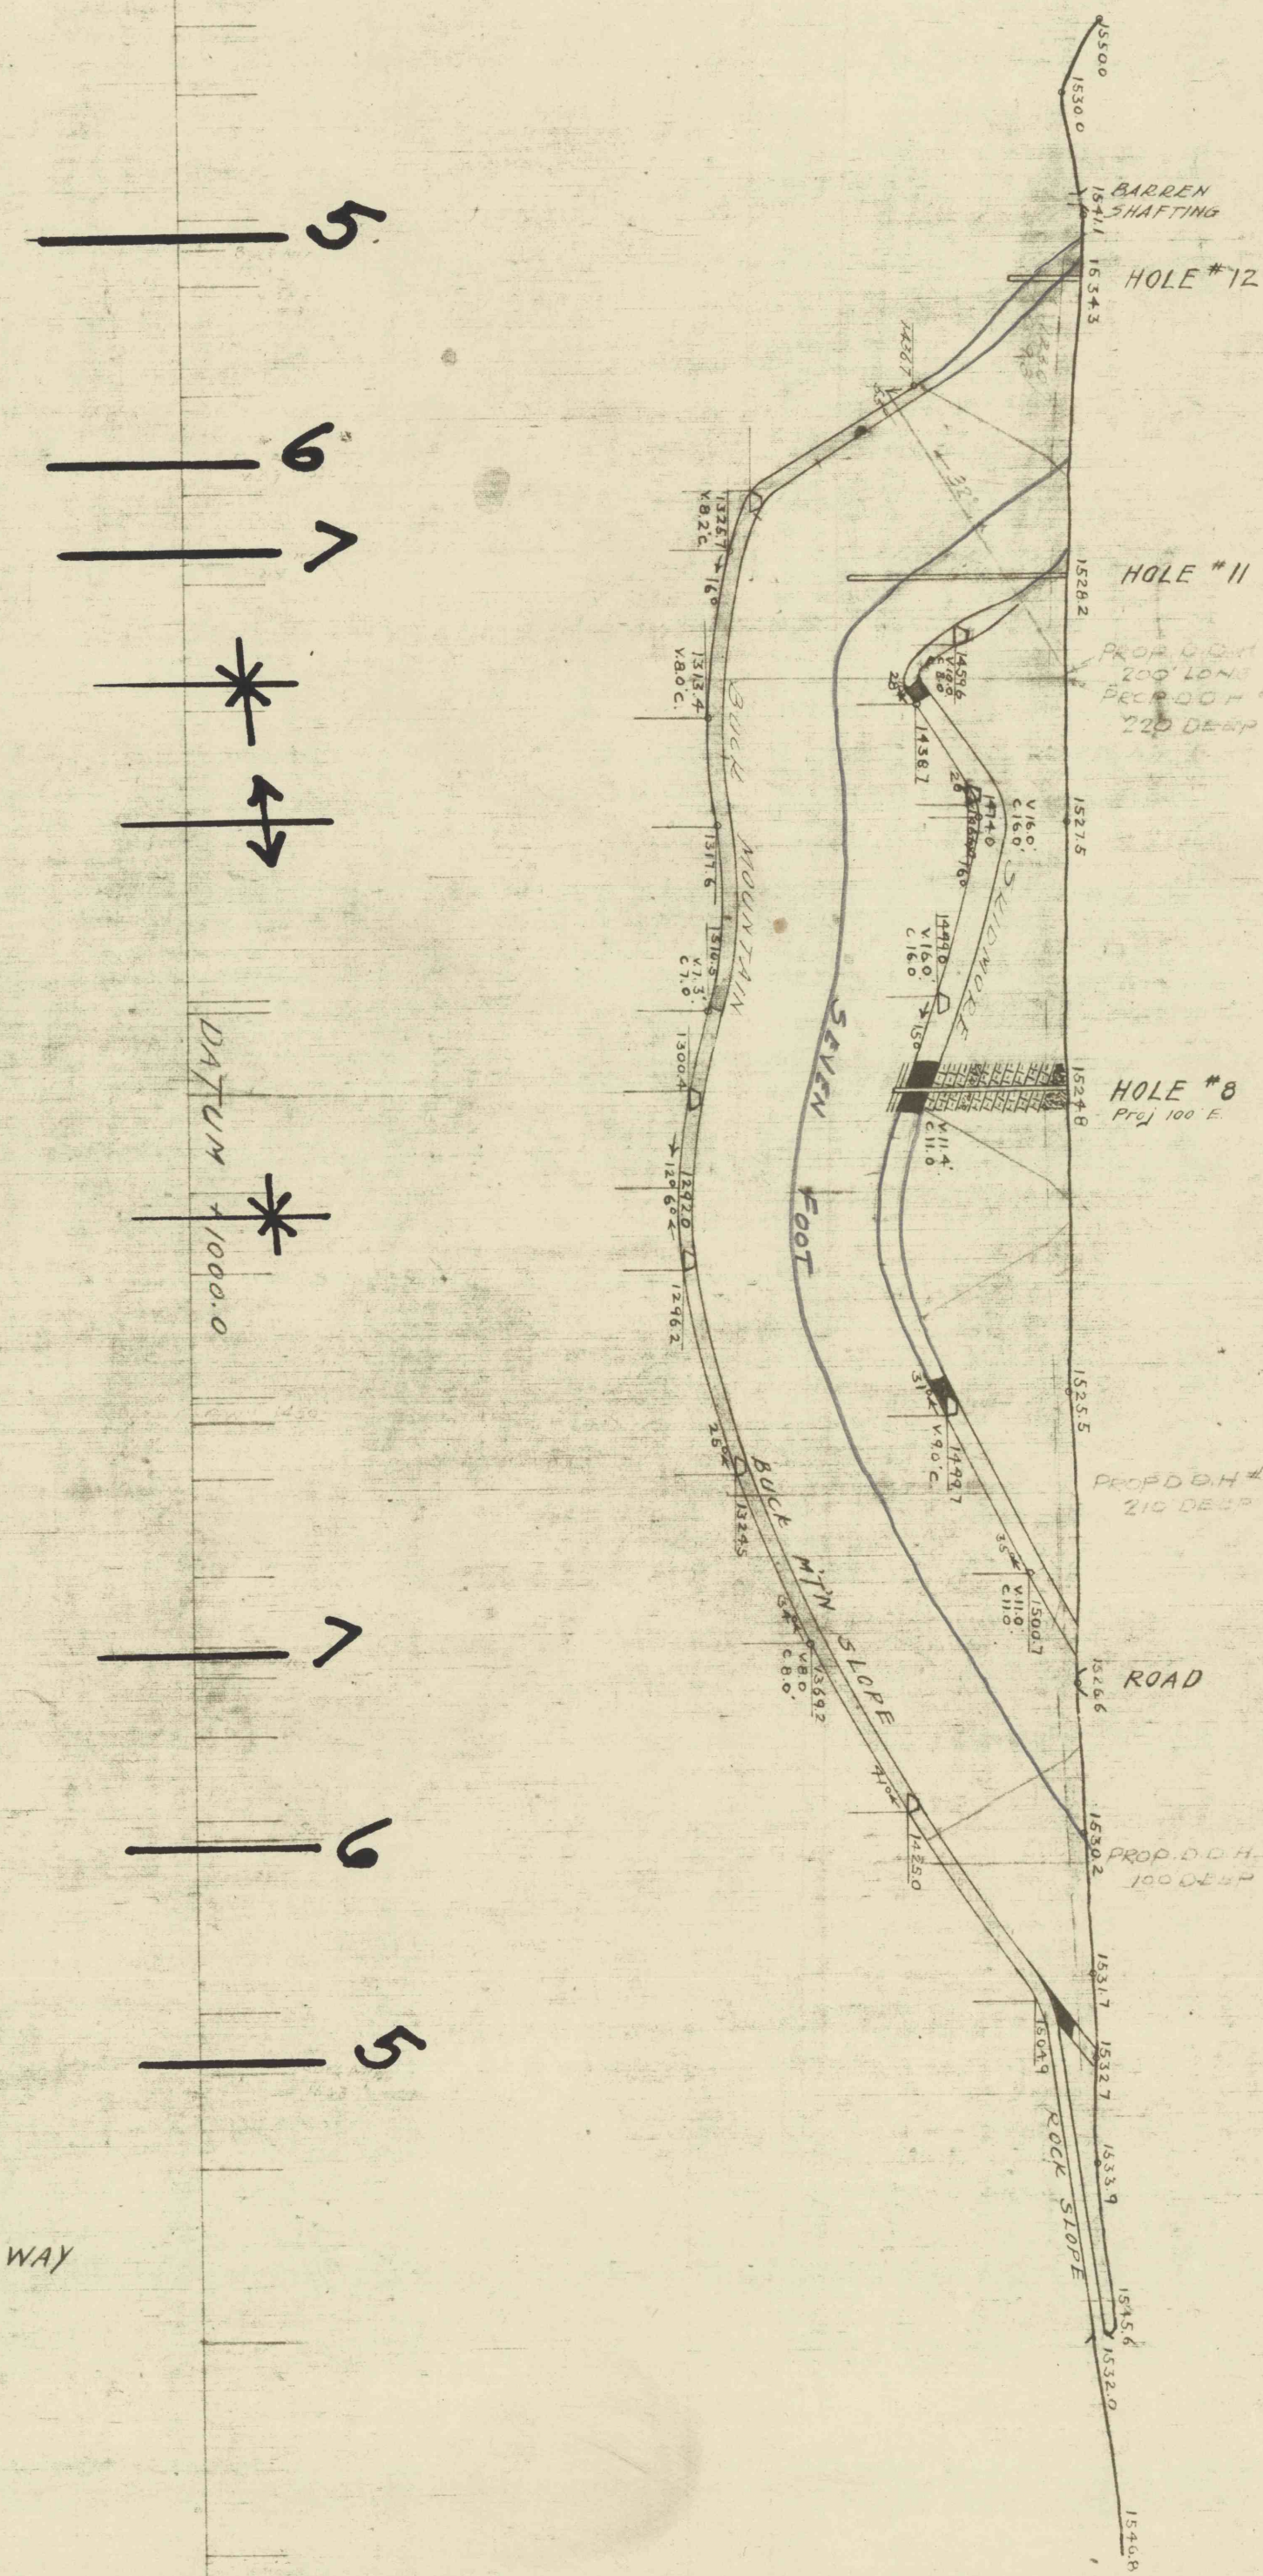

NO. 1 CROSS - SECTION
Through Main Slope.