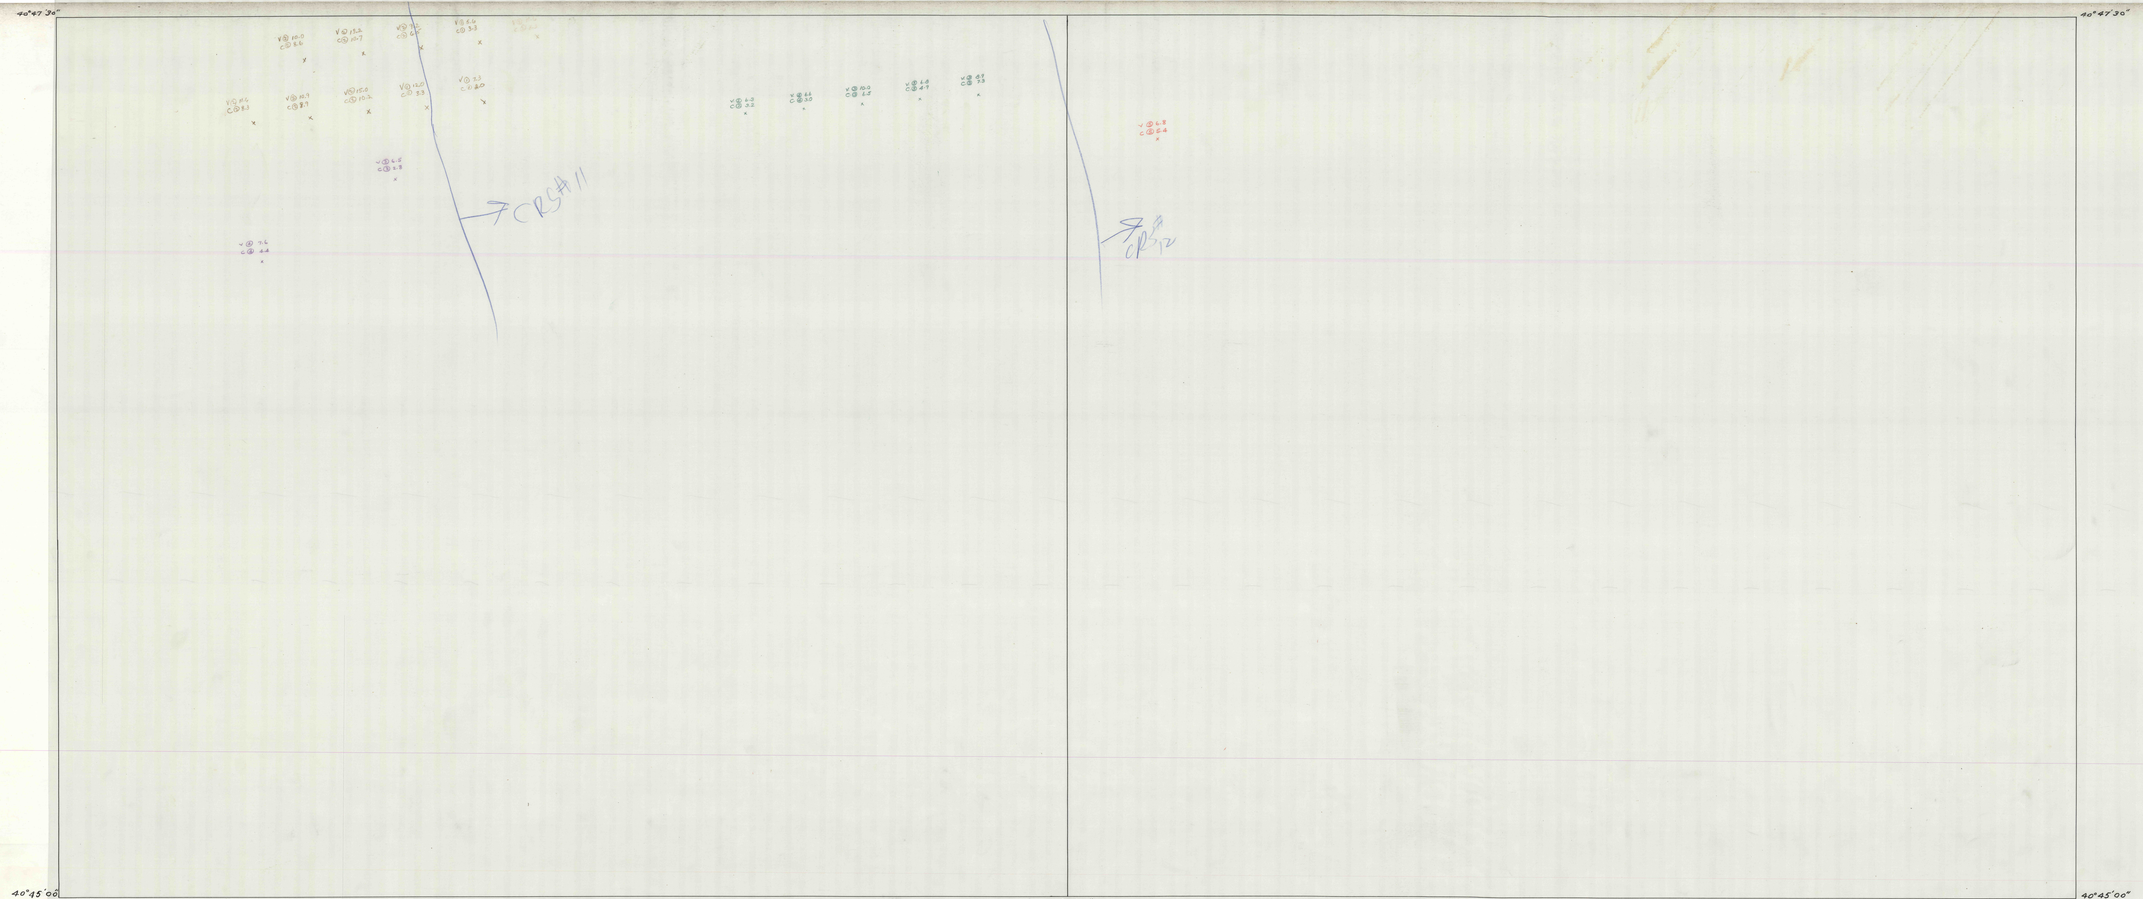

RECAPITULATION

COLLIERY NAME	U.S.G.S. DESIGNATION	COAL CO. DESIGNATION	VEIN RANGE (MIN.-MAX.)	COAL RANGE (MIN.-MAX.)
BAST	12	ORCHARD	6.3-10.0	2.0-7.3
POTTS	12	ORCHARD	6.5-7.6	2.5-4.4
Gymnetown	12	ORCHARD	5.6-15.0	2.0-10.2

No. OF READINGS	AVG. VEIN THICKNESS	AVG. COAL THICKNESS	Vein Range	Coal Range
39	7.9	5.5	5.6-15.0	2.0-10.2

RECAPITULATION

COLLIERY NAME	U.S.G.S. DESIGNATION	COAL CO. DESIGNATION	VEIN RANGE (MIN.-MAX.)	COAL RANGE (MIN.-MAX.)
PRESTON No. 3	12	ORCHARD	6.5-6.8	5.4-5.4

No. OF READINGS	AVG. VEIN THICKNESS	AVG. COAL THICKNESS
5	6.5	5.4

COAL THICKNESS SHEET FOR ORCHARD VEIN
ASHLAND QUADRANGLE (S.W. & S.E. PARTS

BAST COLLIERY
POTTS COLLIERY
PRESTON No. 3 (TUNNEL)