

HARRY E
FOUR FOOT VEIN

GEORGE SHOEMAKER ET AL

GEORGE

SHOEMAKER

ISAAC TRIPP

WEST SIDE COAL CO.
HARRY E COAL CO.

GEORGE PECK

EDWIN MCNEILL


HEIRS OF W HANCOCK

EBENEZER

PETTEBONE

PETTEBONE

BLACK DIAMOND COLLIERY

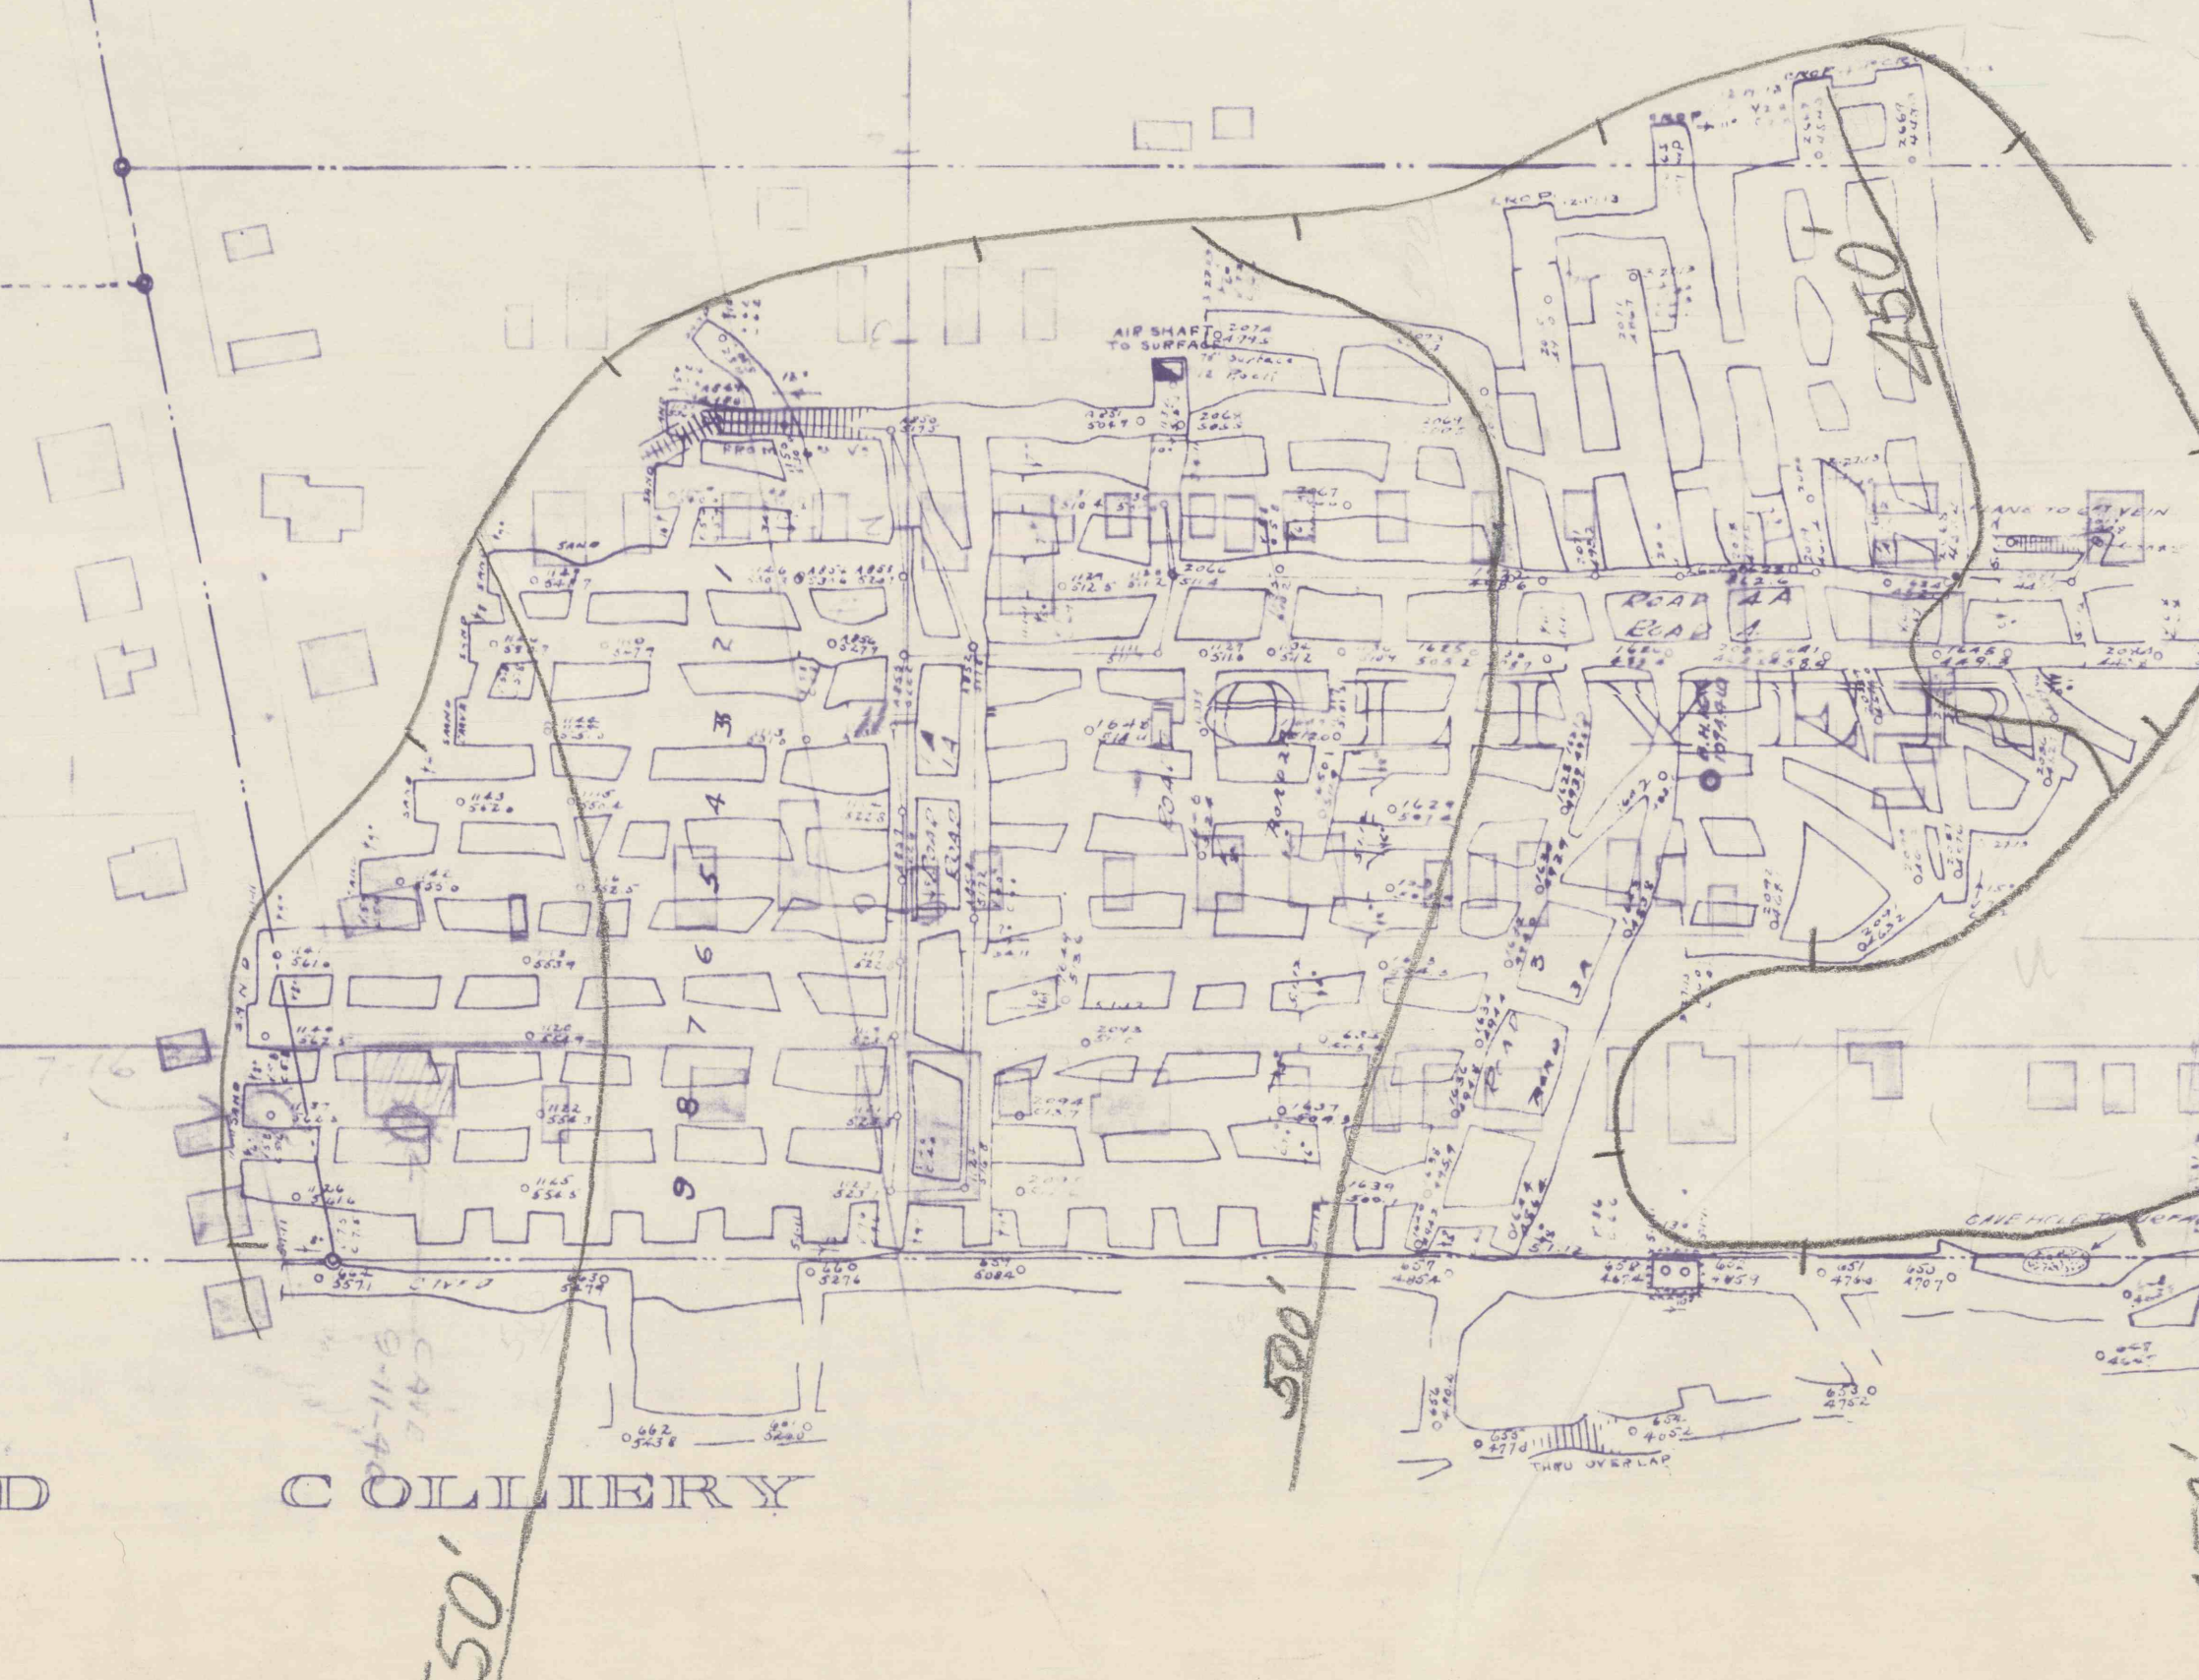

072P
SIX FOOT

SIX FOOT

072P
FOUR FOOT