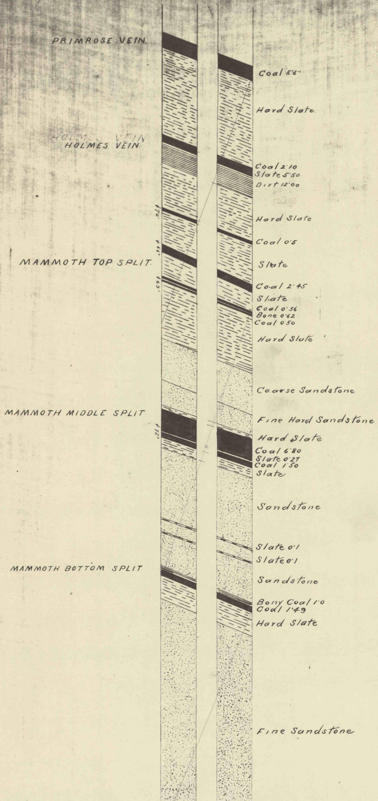
PRIMROSE VEIN
Coal 5'6"
Hard Slate
HOLMES VEIN
Coal 2'10
Slate 5'50
Dirt 12'00
70°
Hard Slate
66°
Coal 0'5
MAMMOTH TOP SPLIT
Slate
63°
Coal 2'45
Slate
Coal 0'56
Bone 0'62
Coal 0'50
Hard Slate
Coarse Sandstone
MAMMOTH MIDDLE SPLIT
Fine Hard Sandstone
72°
Hard Slate
Coal 6'80
Slate 0'27
Coal 1'50
Slate
Sandstone
Slate 0'1
Slate 0'1
MAMMOTH BOTTOM SPLIT
Sandstone
Bony Coal 1'0
Coal 1'49
Hard Slate
Fine Sandstone

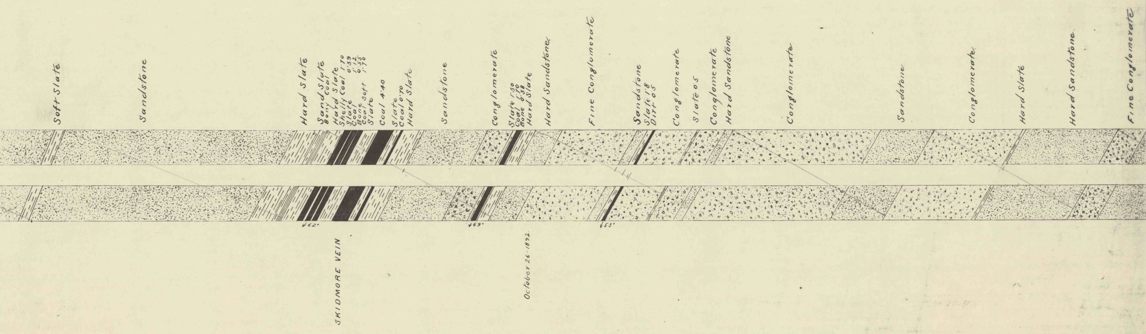
Soft Slate
Sandstone
Hard Slate
Sand Slate
Bony Coal
Hard Slate
Shelly Coal 1'70
Slate 0'39
Coal 1'12
Bone 0'55
Coal soft 1'70
Slate
Coal 4'40
Slate
Coal 0'70
Hard Slate
Sandstone
Conglomerate
Slate 1'30
Coal 1'70
Bone 0'38
Hard Slate
Hard Sandstone
Fine Conglomerate
Sandstone
Slate 1'8
Dirt 0'5
Conglomerate
Slate 0'5
Conglomerate
Hard Sandstone
Conglomerate
Sandstone
Conglomerate
Hard Slate
Hard Sandstone
Fine Conglomerate
62°
69°
55°
SKIDMORE VEIN
October 26-1892.

SECTION of LONG TUNN

BEAR VALLEY SHAFT

Scale 20' = 1"

October 19-93.

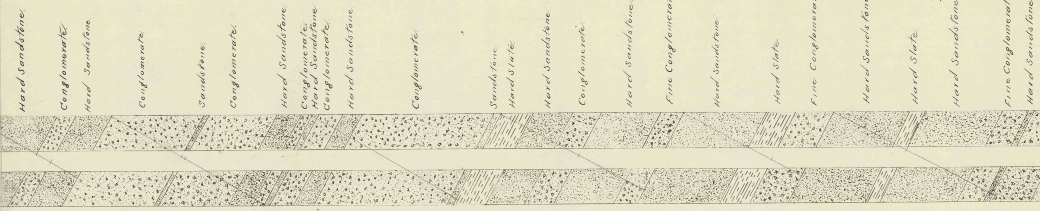
Hard Sandstone.
Conglomerate.
Hard Sandstone
Conglomerate.
Sandstone.
Conglomerate.
Hard Sandstone.
Conglomerate.
Hard Sandstone
Conglomerate.
Hard Sandstone.
Conglomerate.
Sandstone
Hard Slate.
Hard Sandstone
Conglomerate.
Hard Sandstone.
Fine Conglomerate.
Hard Sandstone
Hard Slate.
Fine Conglomerate.
Hard Sandstone.
Hard Slate.
Hard Sandstone.
Fine Conglomerate.
Hard Sandstone.

EL

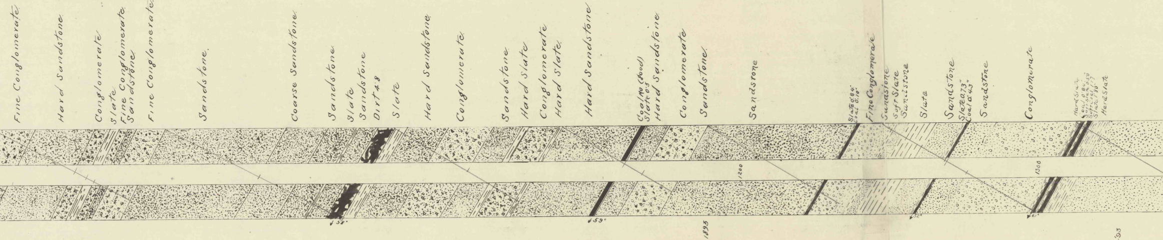

Fine Conglomerate
Hard Sandstone
Conglomerate
Slate
Fine Conglomerate
Sandstone
Fine Conglomerate
Sandstone
Coarse Sandstone
Sandstone
Slate
Sandstone
Dirt 4'8
Slate
Hard Sandstone
Conglomerate
Sandstone
Hard Slate
Conglomerate
Hard Slate
Hard Sandstone
Coal 1'10 (Good)
Slate 0'5
Hard Sandstone
Conglomerate
Sandstone
Sandstone
Slate 0'84
Coal 0'10
Fine Conglomerate
Sandstone
Soft Slate
Sandstone
Slate
Sandstone
Slate 0'73"
Coal 0'43"
Sandstone
Conglomerate
Hard Slate
Coal 0'84
Soft Slate 0'50
Soft Coal 1'17
Slate 1'80"
Hard Slate
1200
1300
58°
59°
52°
61°

October 17-1893

Dec. 18-'93

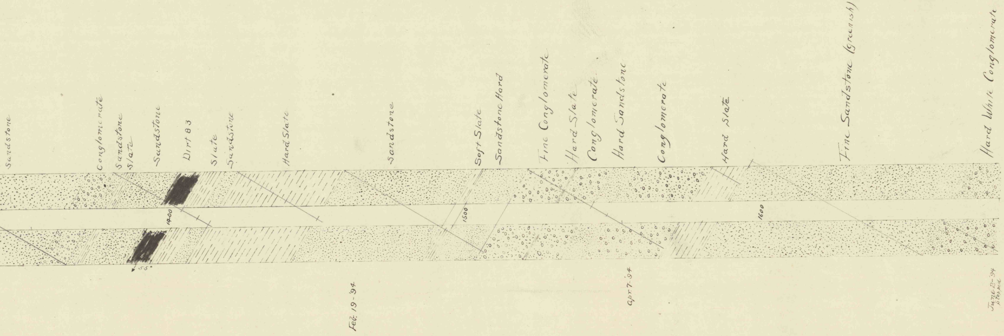
Sandstone
Conglomerate
Sandstone
Slate
Sandstone
Dirt 83
Slate
Sandstone
Hard Slate
Sandstone
Soft Slate
Sandstone Hard
Fine Conglomerate
Hard Slate
Conglomerate
Hard Sandstone
Conglomerate
Hard Slate
Fine Sandstone (greenish)
Hard White Conglomerate
1400
1500
1600
55°
Feb. 19-94
Apr. 7-94
June 2-94
Stopped

1730

TUBE N
&
SHEET NO. ---