


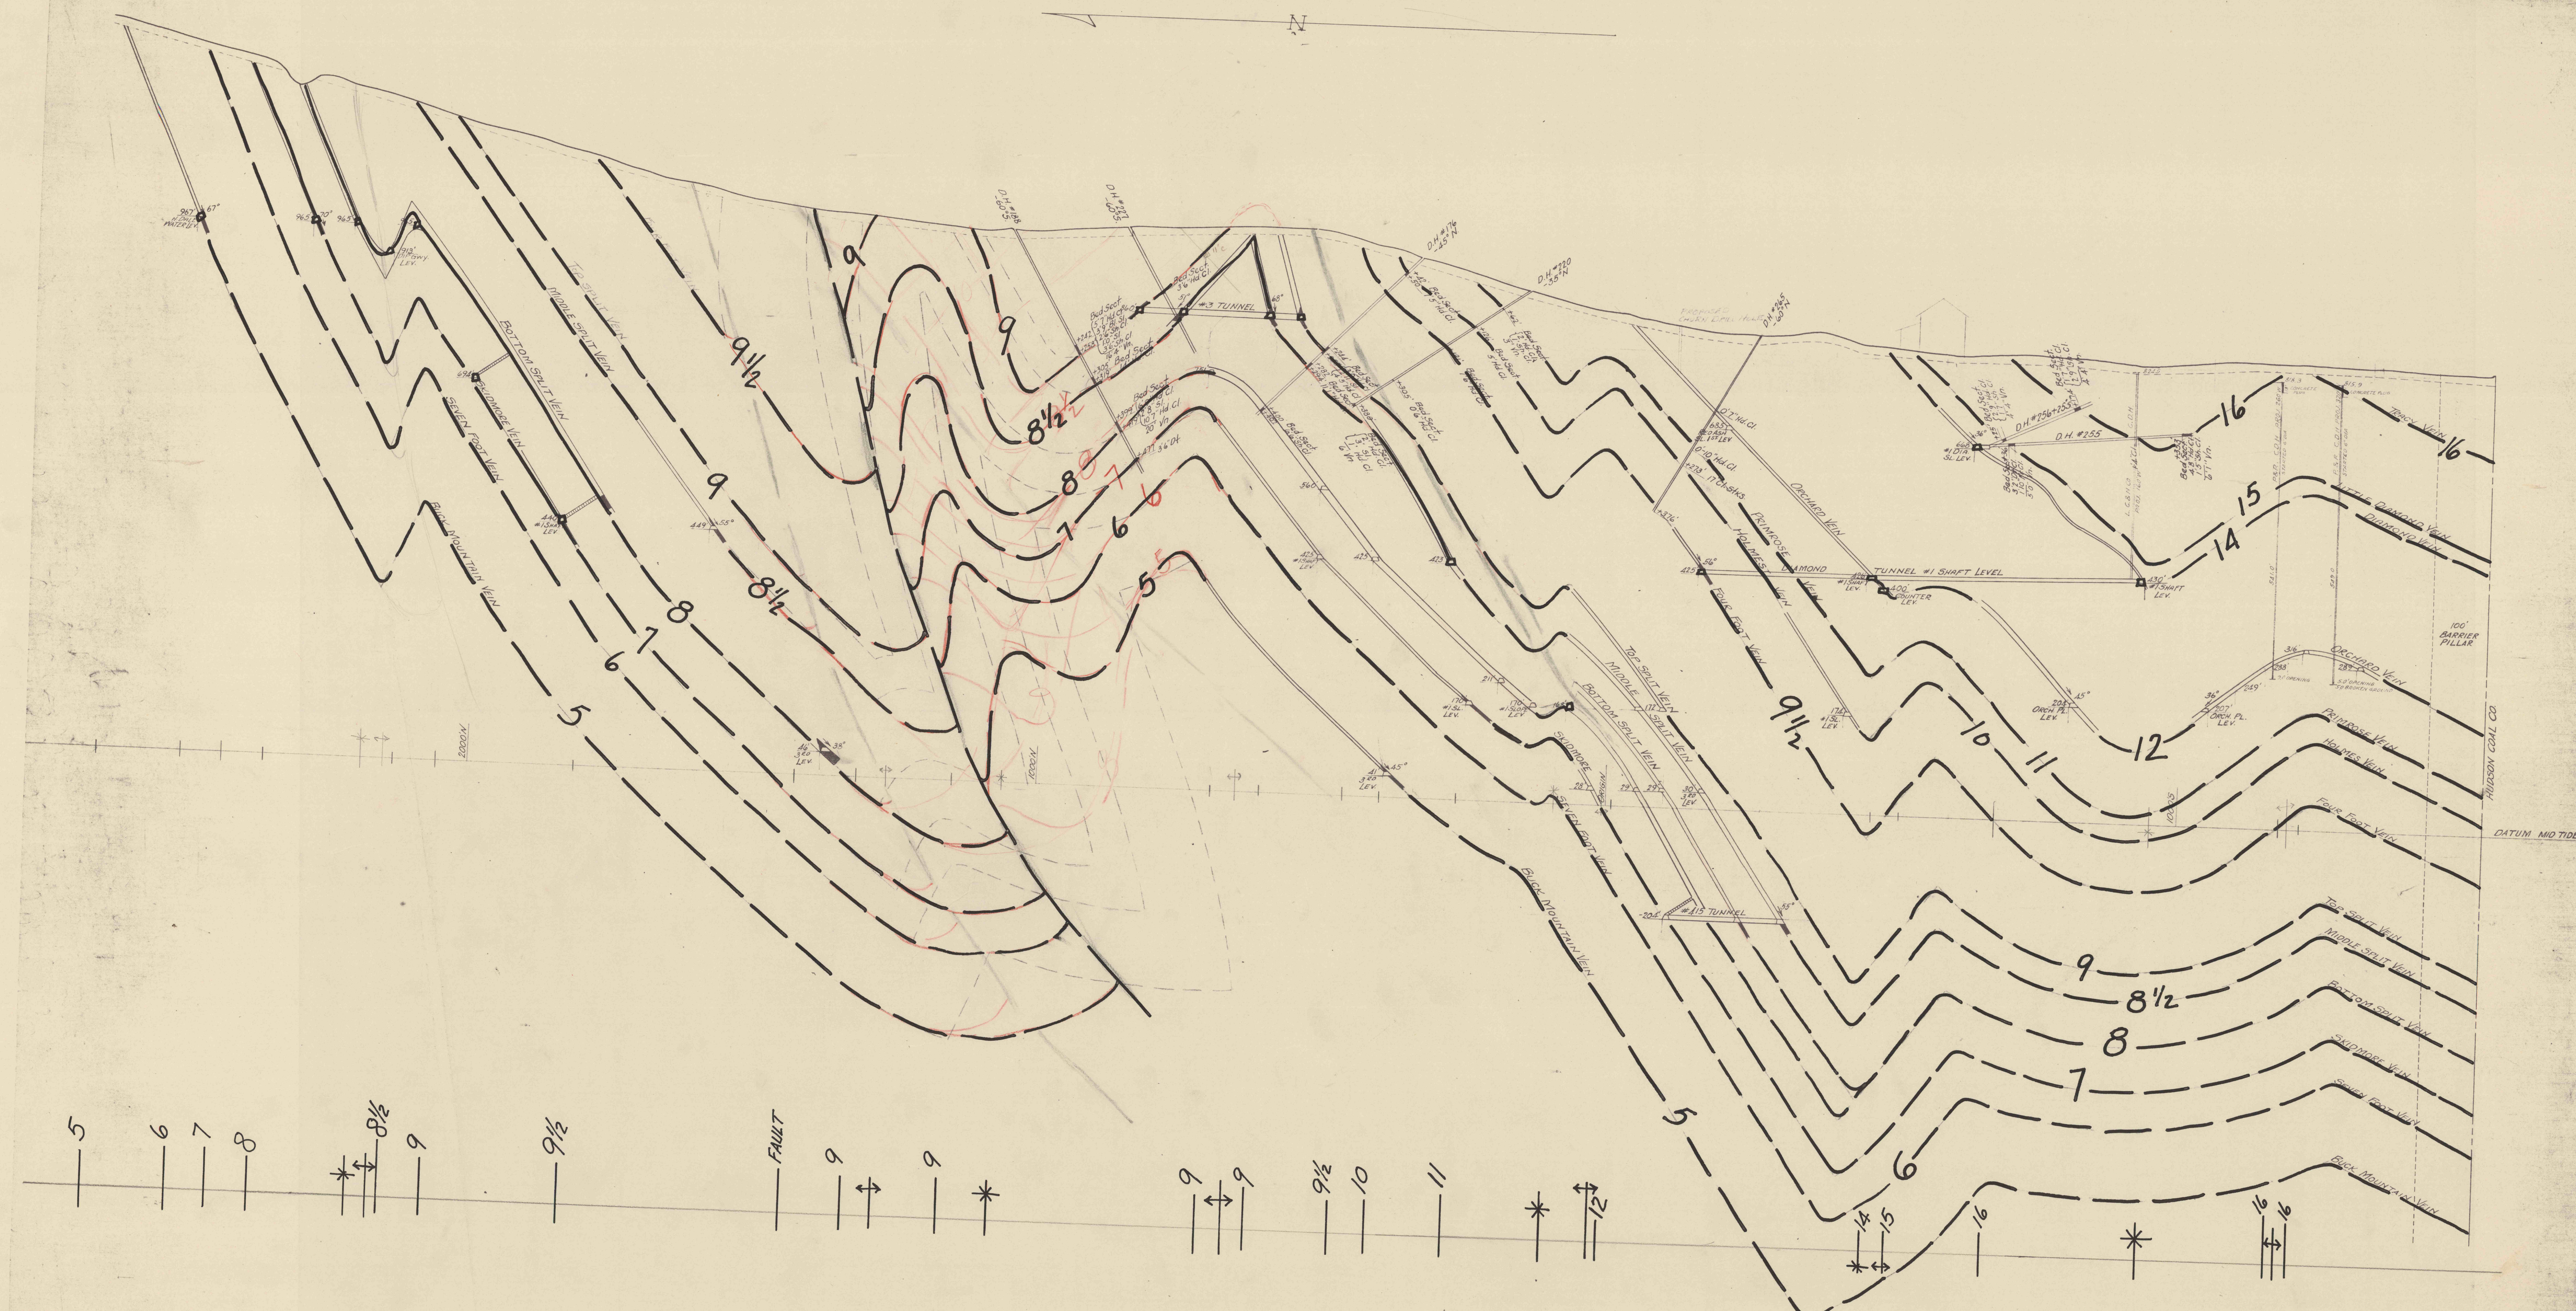

ALLIANCE COLLIERY
 CROSS SECTION LINE 294
 1100' EAST OF NO. 1 SHAFT
 SCALE 1"=100'
 MARCH 1933.
 REVISED DEC. 1935
 W.S. RAUSCH MIN. ENGR.