


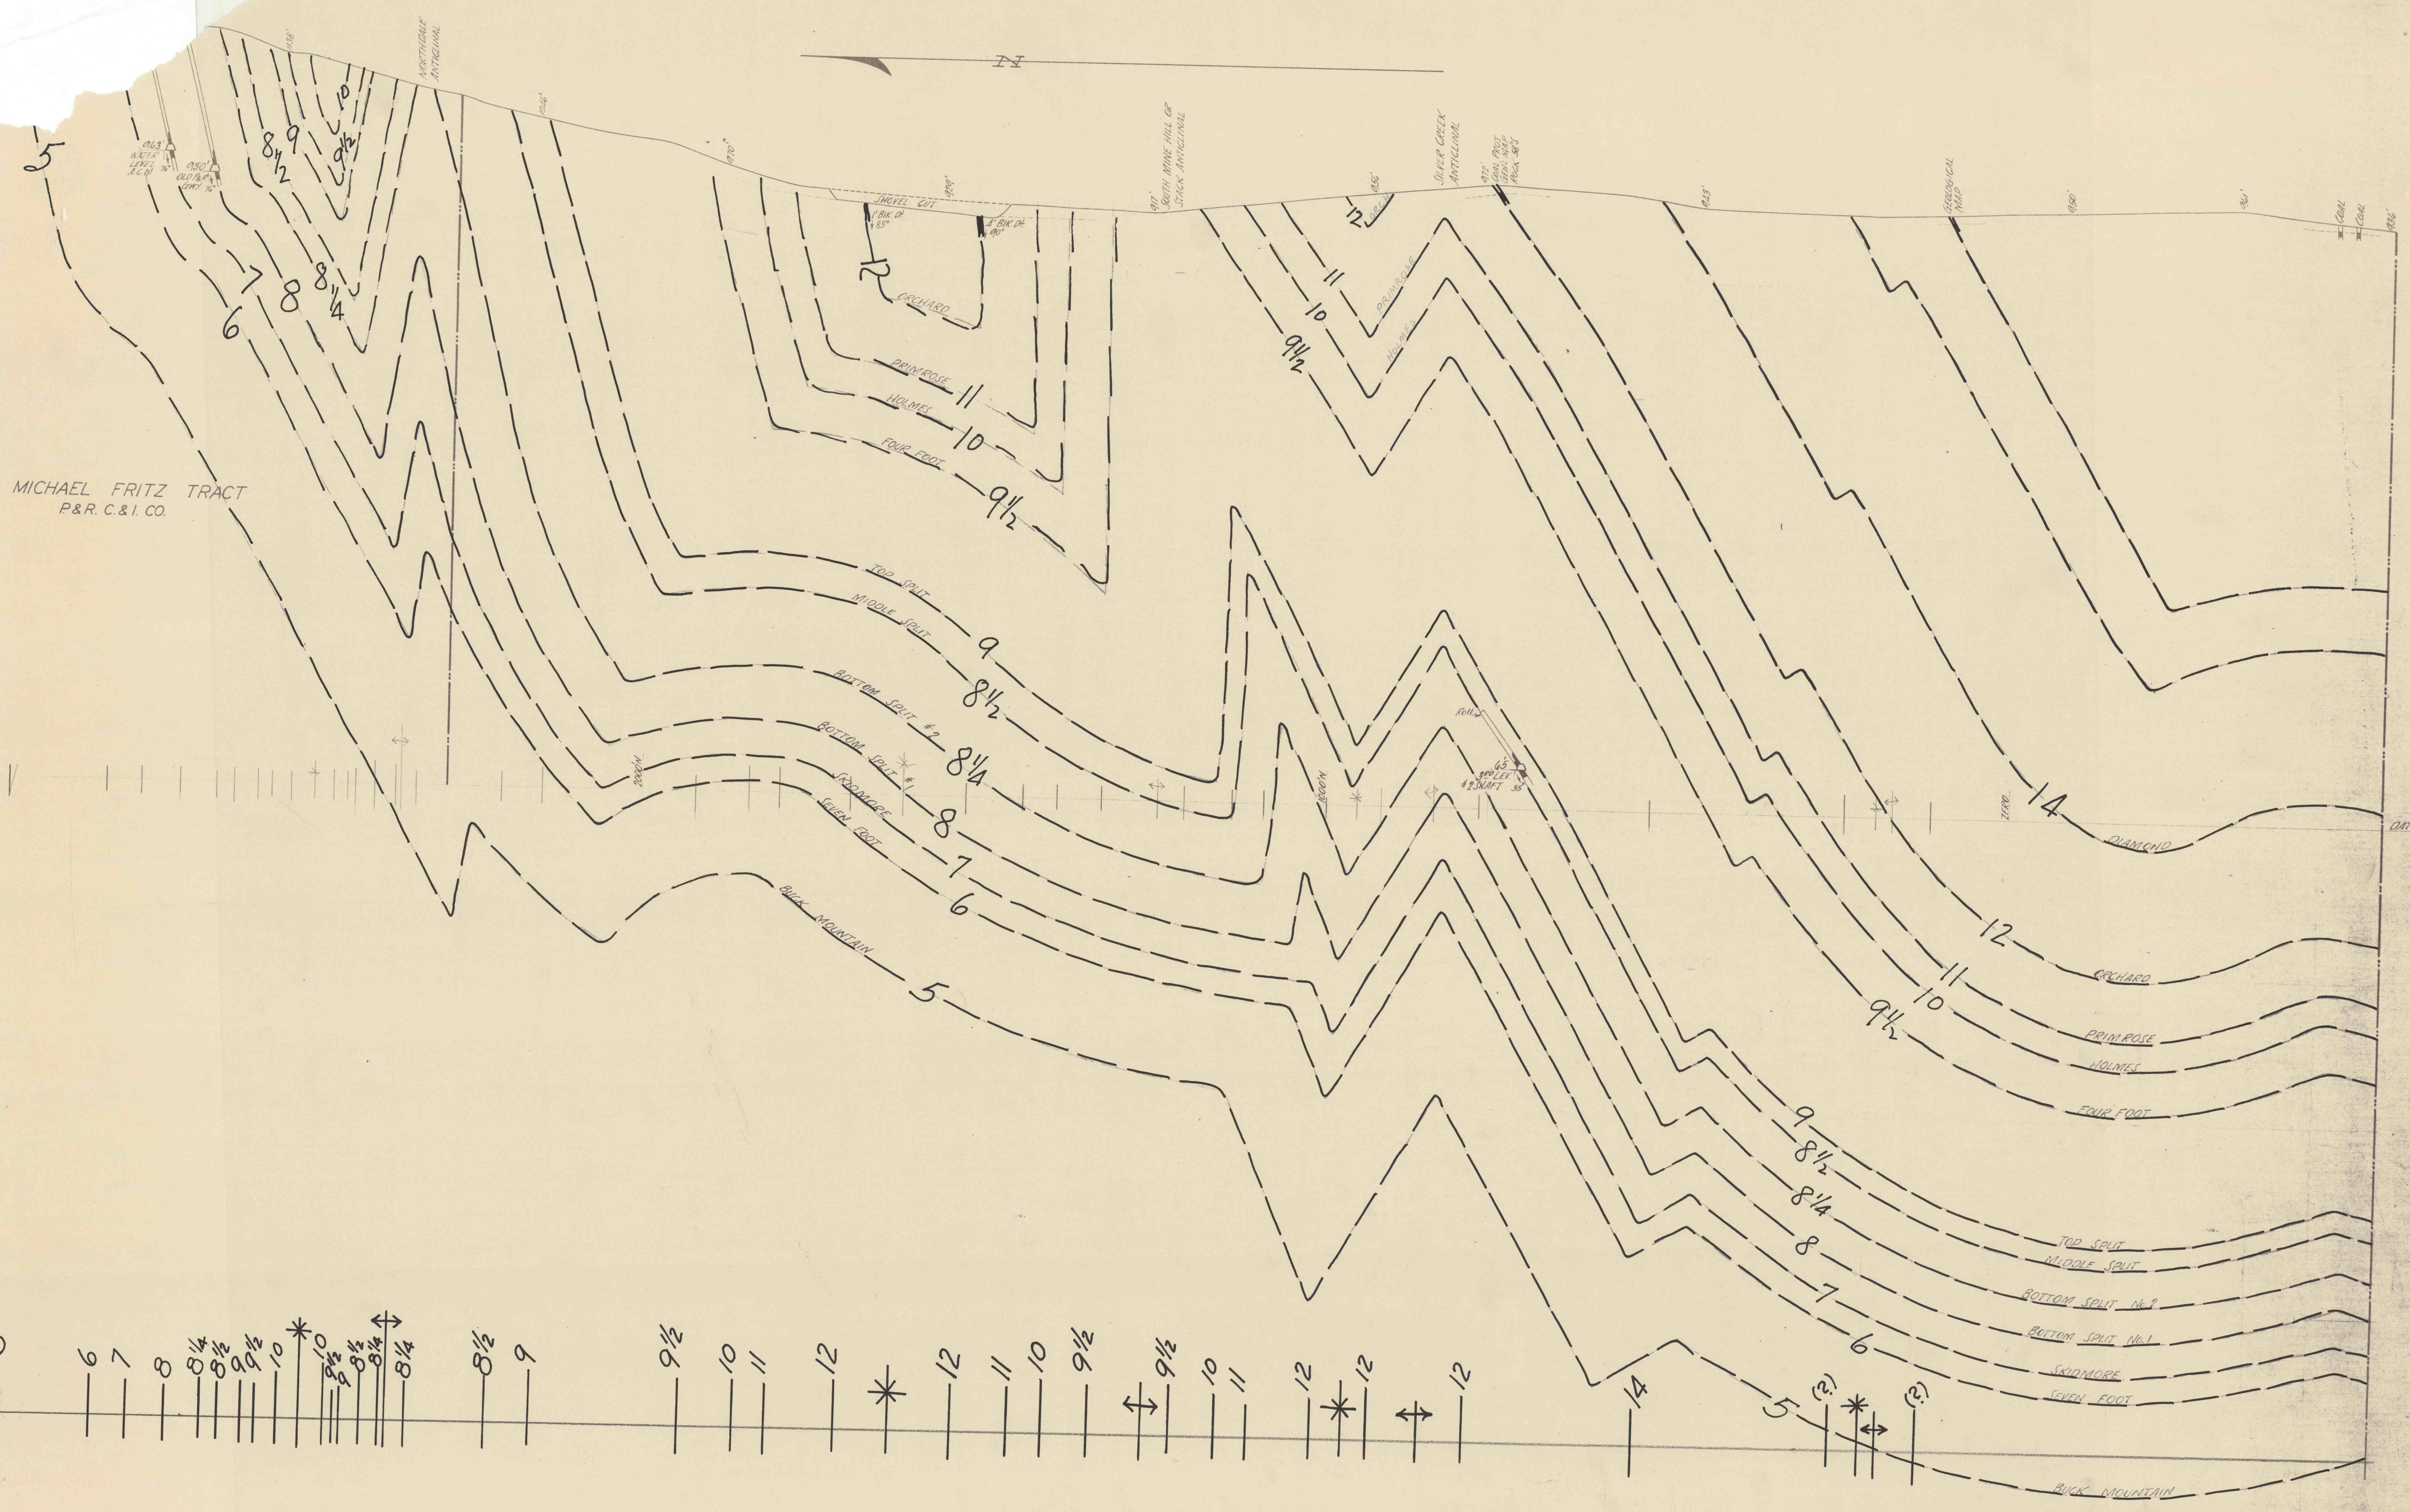

ALLIANCE COLLIERY
 CROSS SECTION LINE 295
 ALONG EAST LAND LINE. 4580' EAST OF NO. 1 SHAFT.
 SCALE 1"=100' APRIL 1933. REVISED, DEC. 1935.
 W.S. RAUSCH, MIN. ENGR.

80