


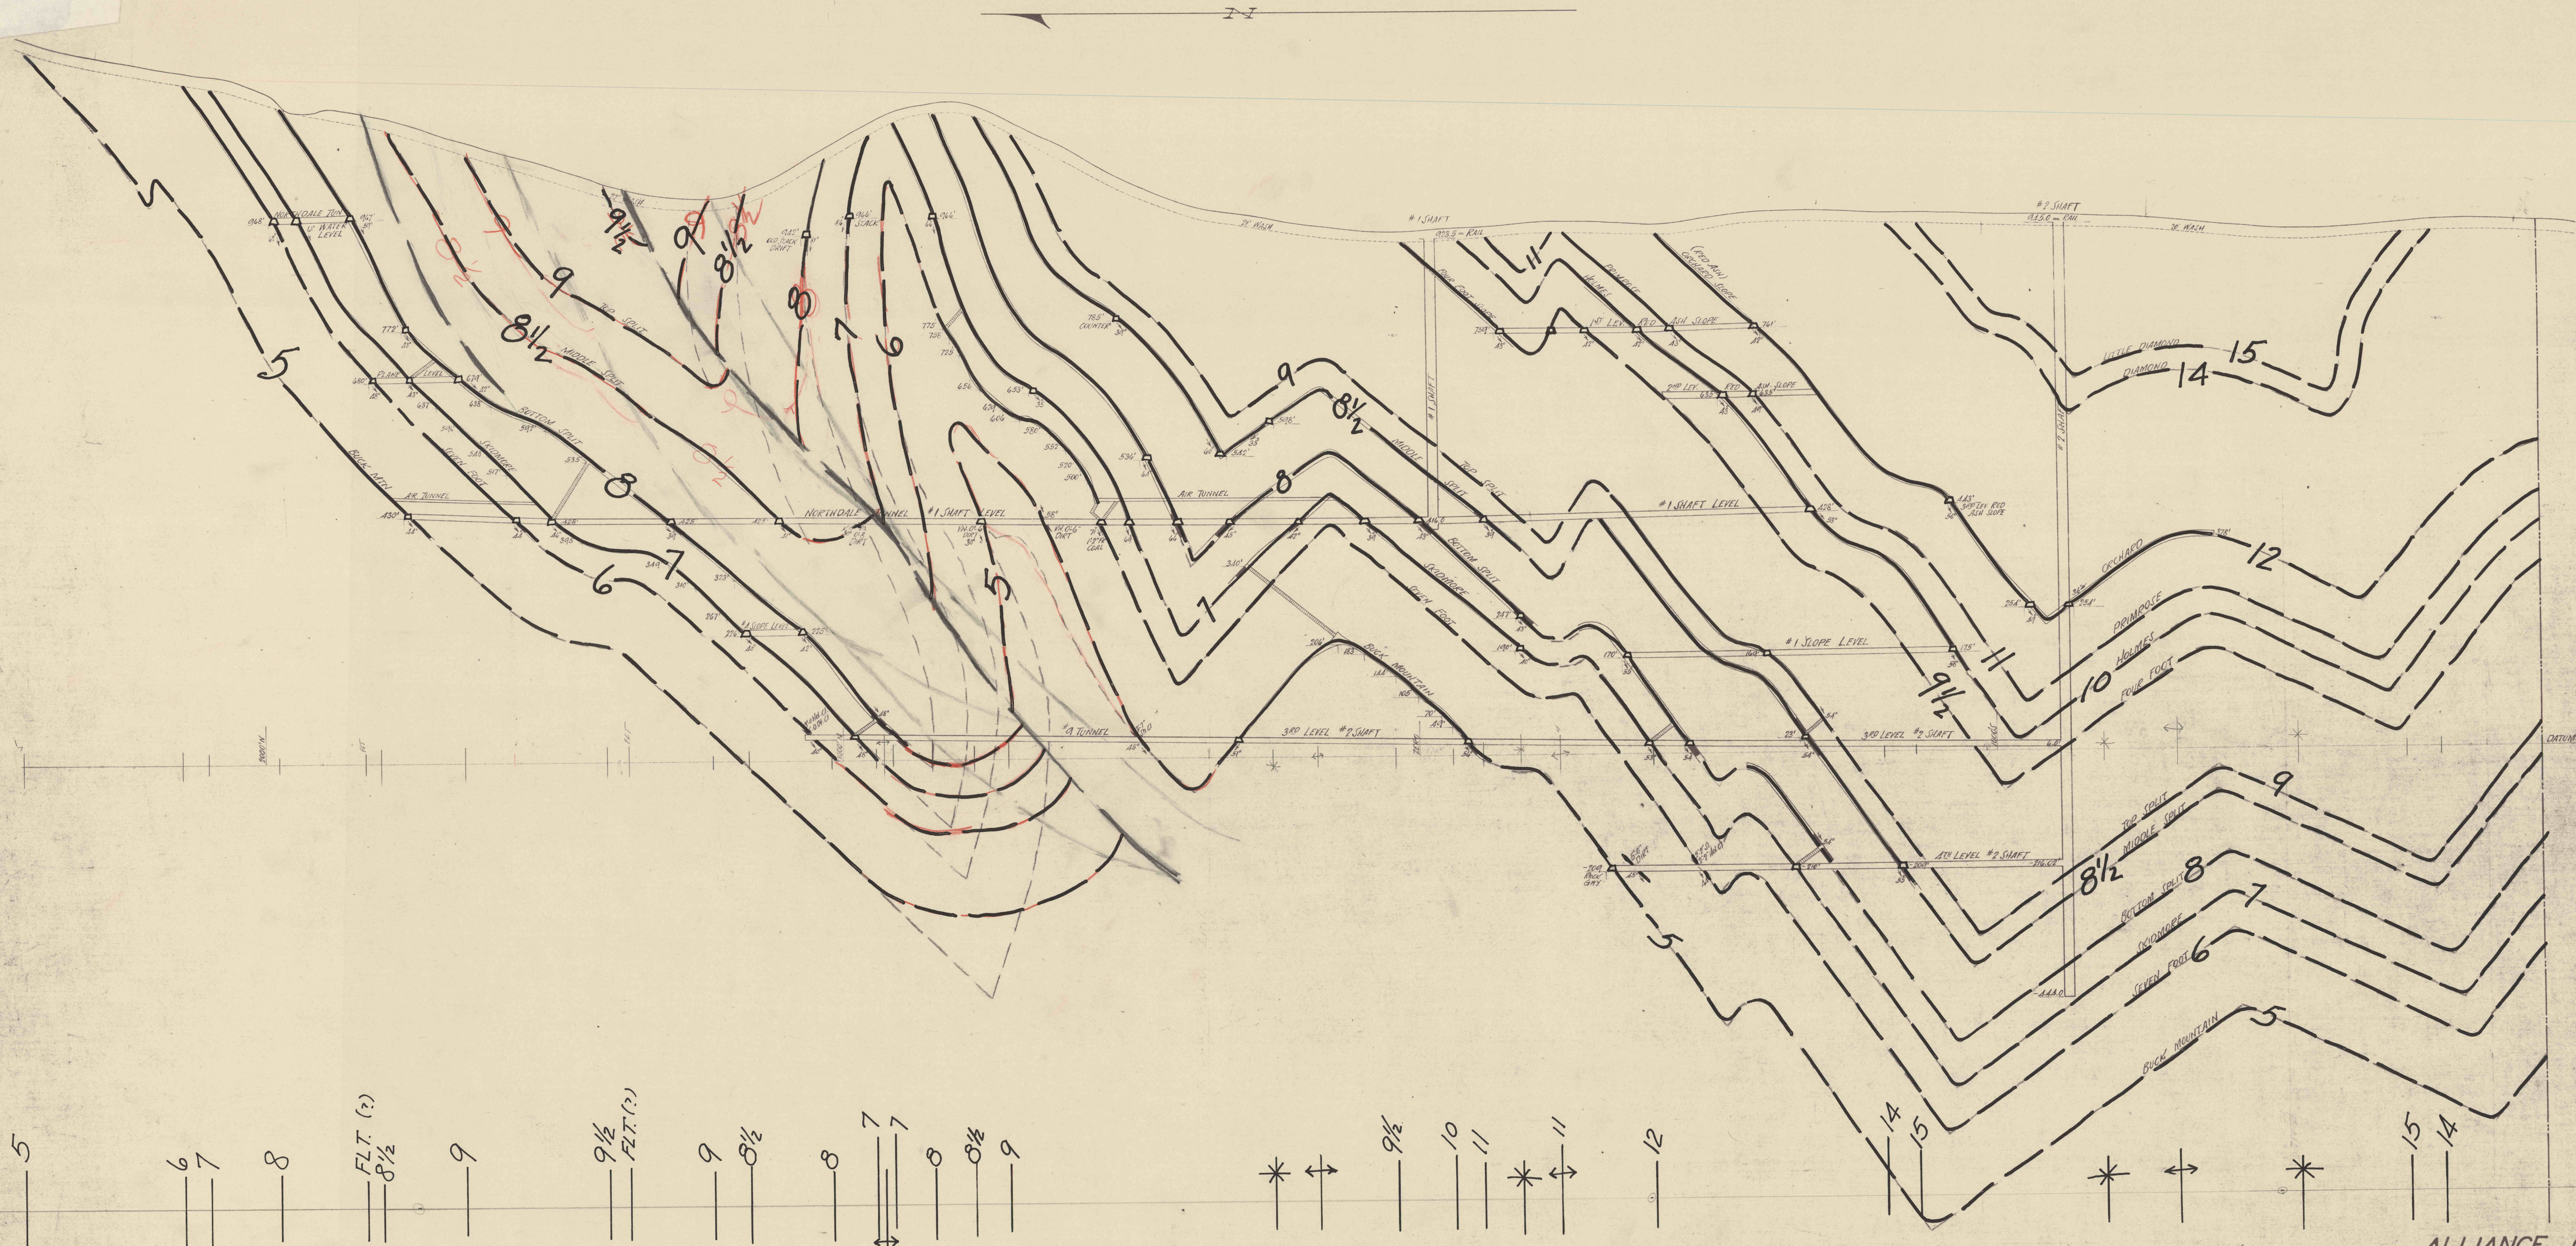

5
 6
 7
 8
 FLT. (?)
 8 1/2
 9
 9 1/2
 FLT. (?)
 9
 8 1/2
 8
 7
 7
 8
 8 1/2
 9
 * ↑
 9 1/2
 10
 11
 * ↑
 11
 12
 14
 15
 * ↑
 * ↑
 * ↑
 15
 14

ALLIANCE COLLIERY
 CROSS SECTION LINE 285
 500' WEST OF NO. 1 SHAFT.

SCALE 1"=100'
 JULY 1932
 W.S. RAUSCH, MIN. ENGR.
 REVISED NOV. 1935