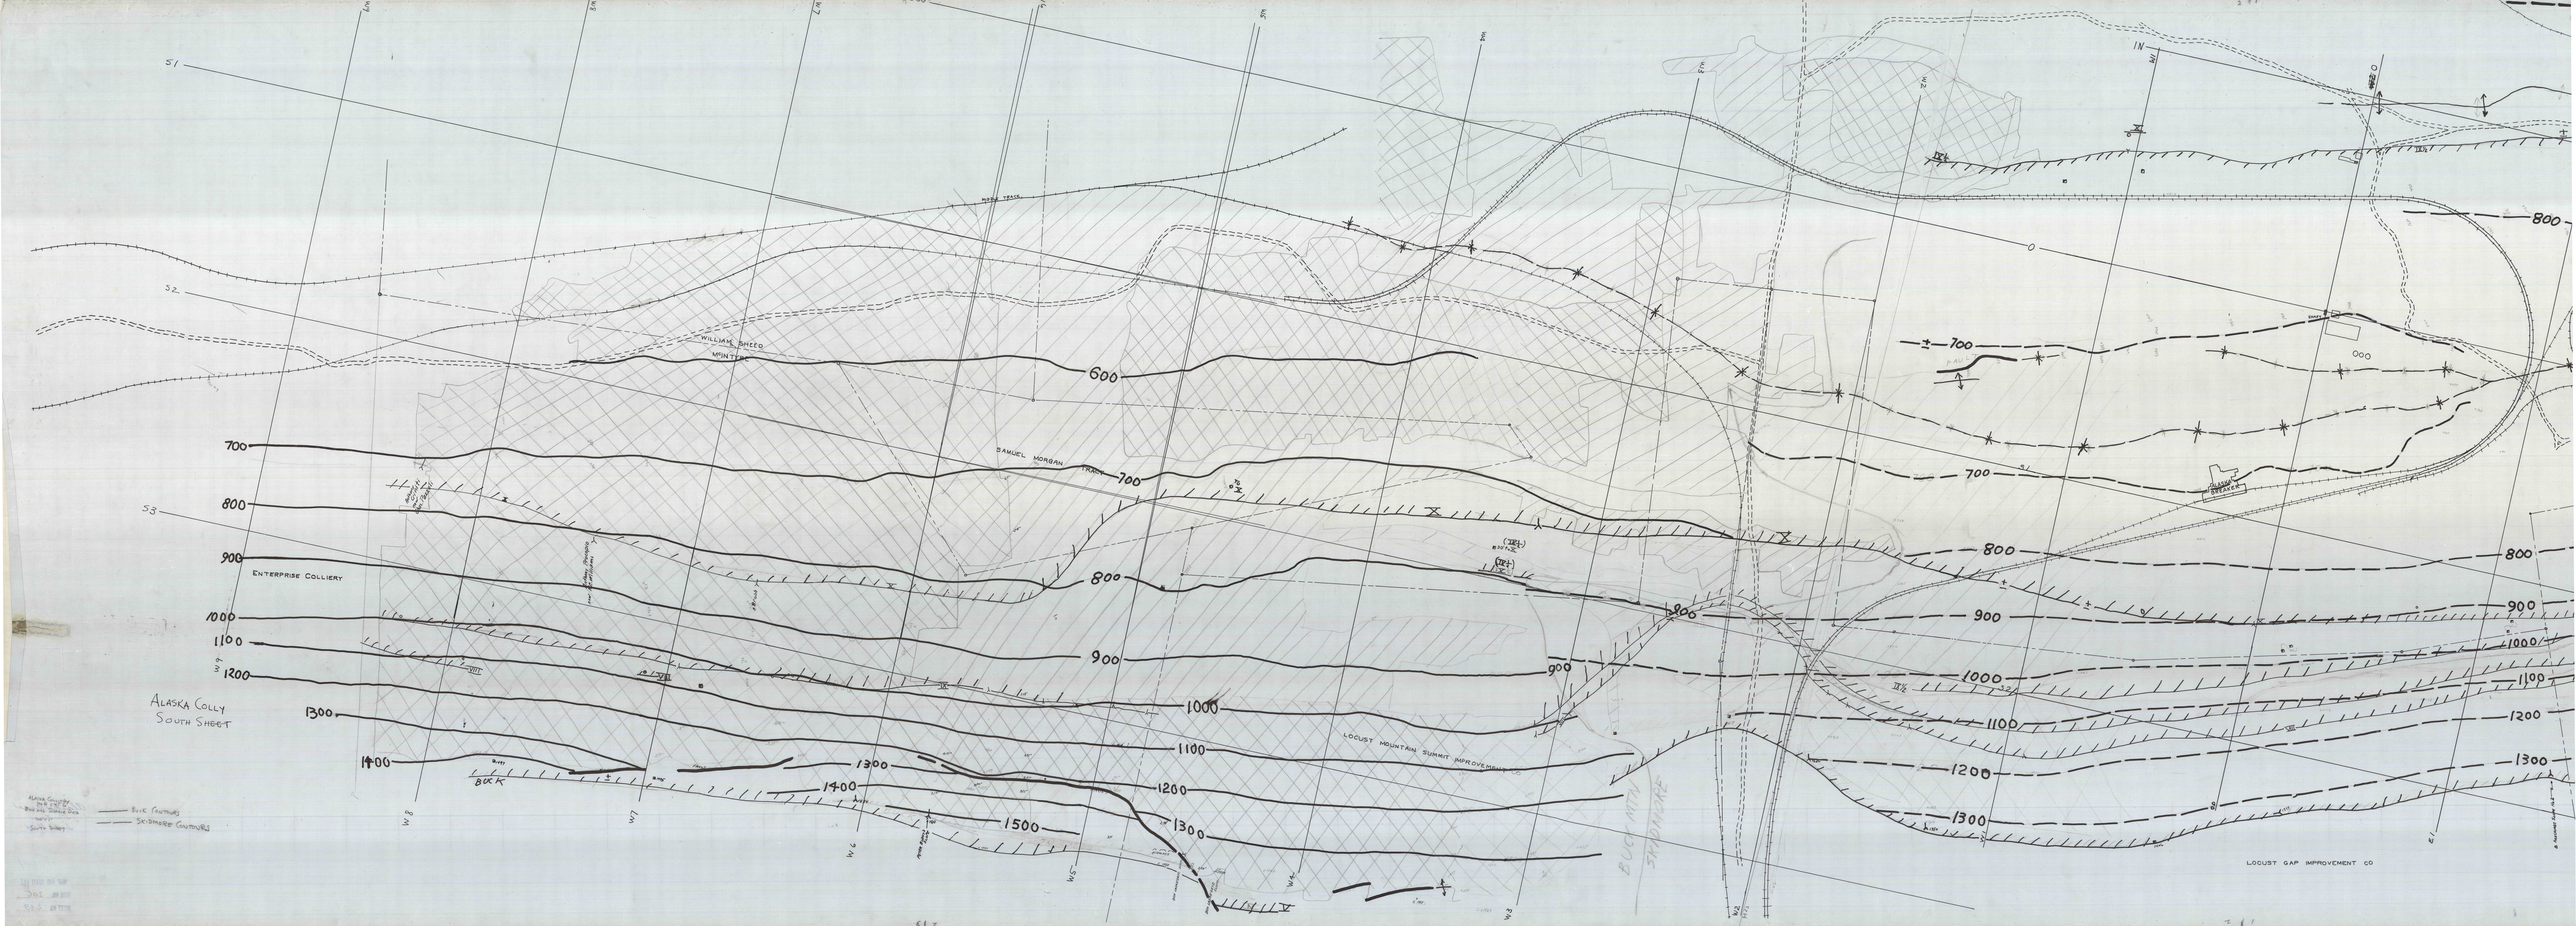

WILLIAM SHEED
SAMUEL MORGAN TRACT
ENTERPRISE COLLIERY
ALASKA COLLY
SOUTH SHEET
LOCUST MOUNTAIN SUMMIT IMPROVEMENT
LOCUST GAP IMPROVEMENT CO
BUCK MTN
600
700
800
900
1000
1100
1200
1300
1400
1500