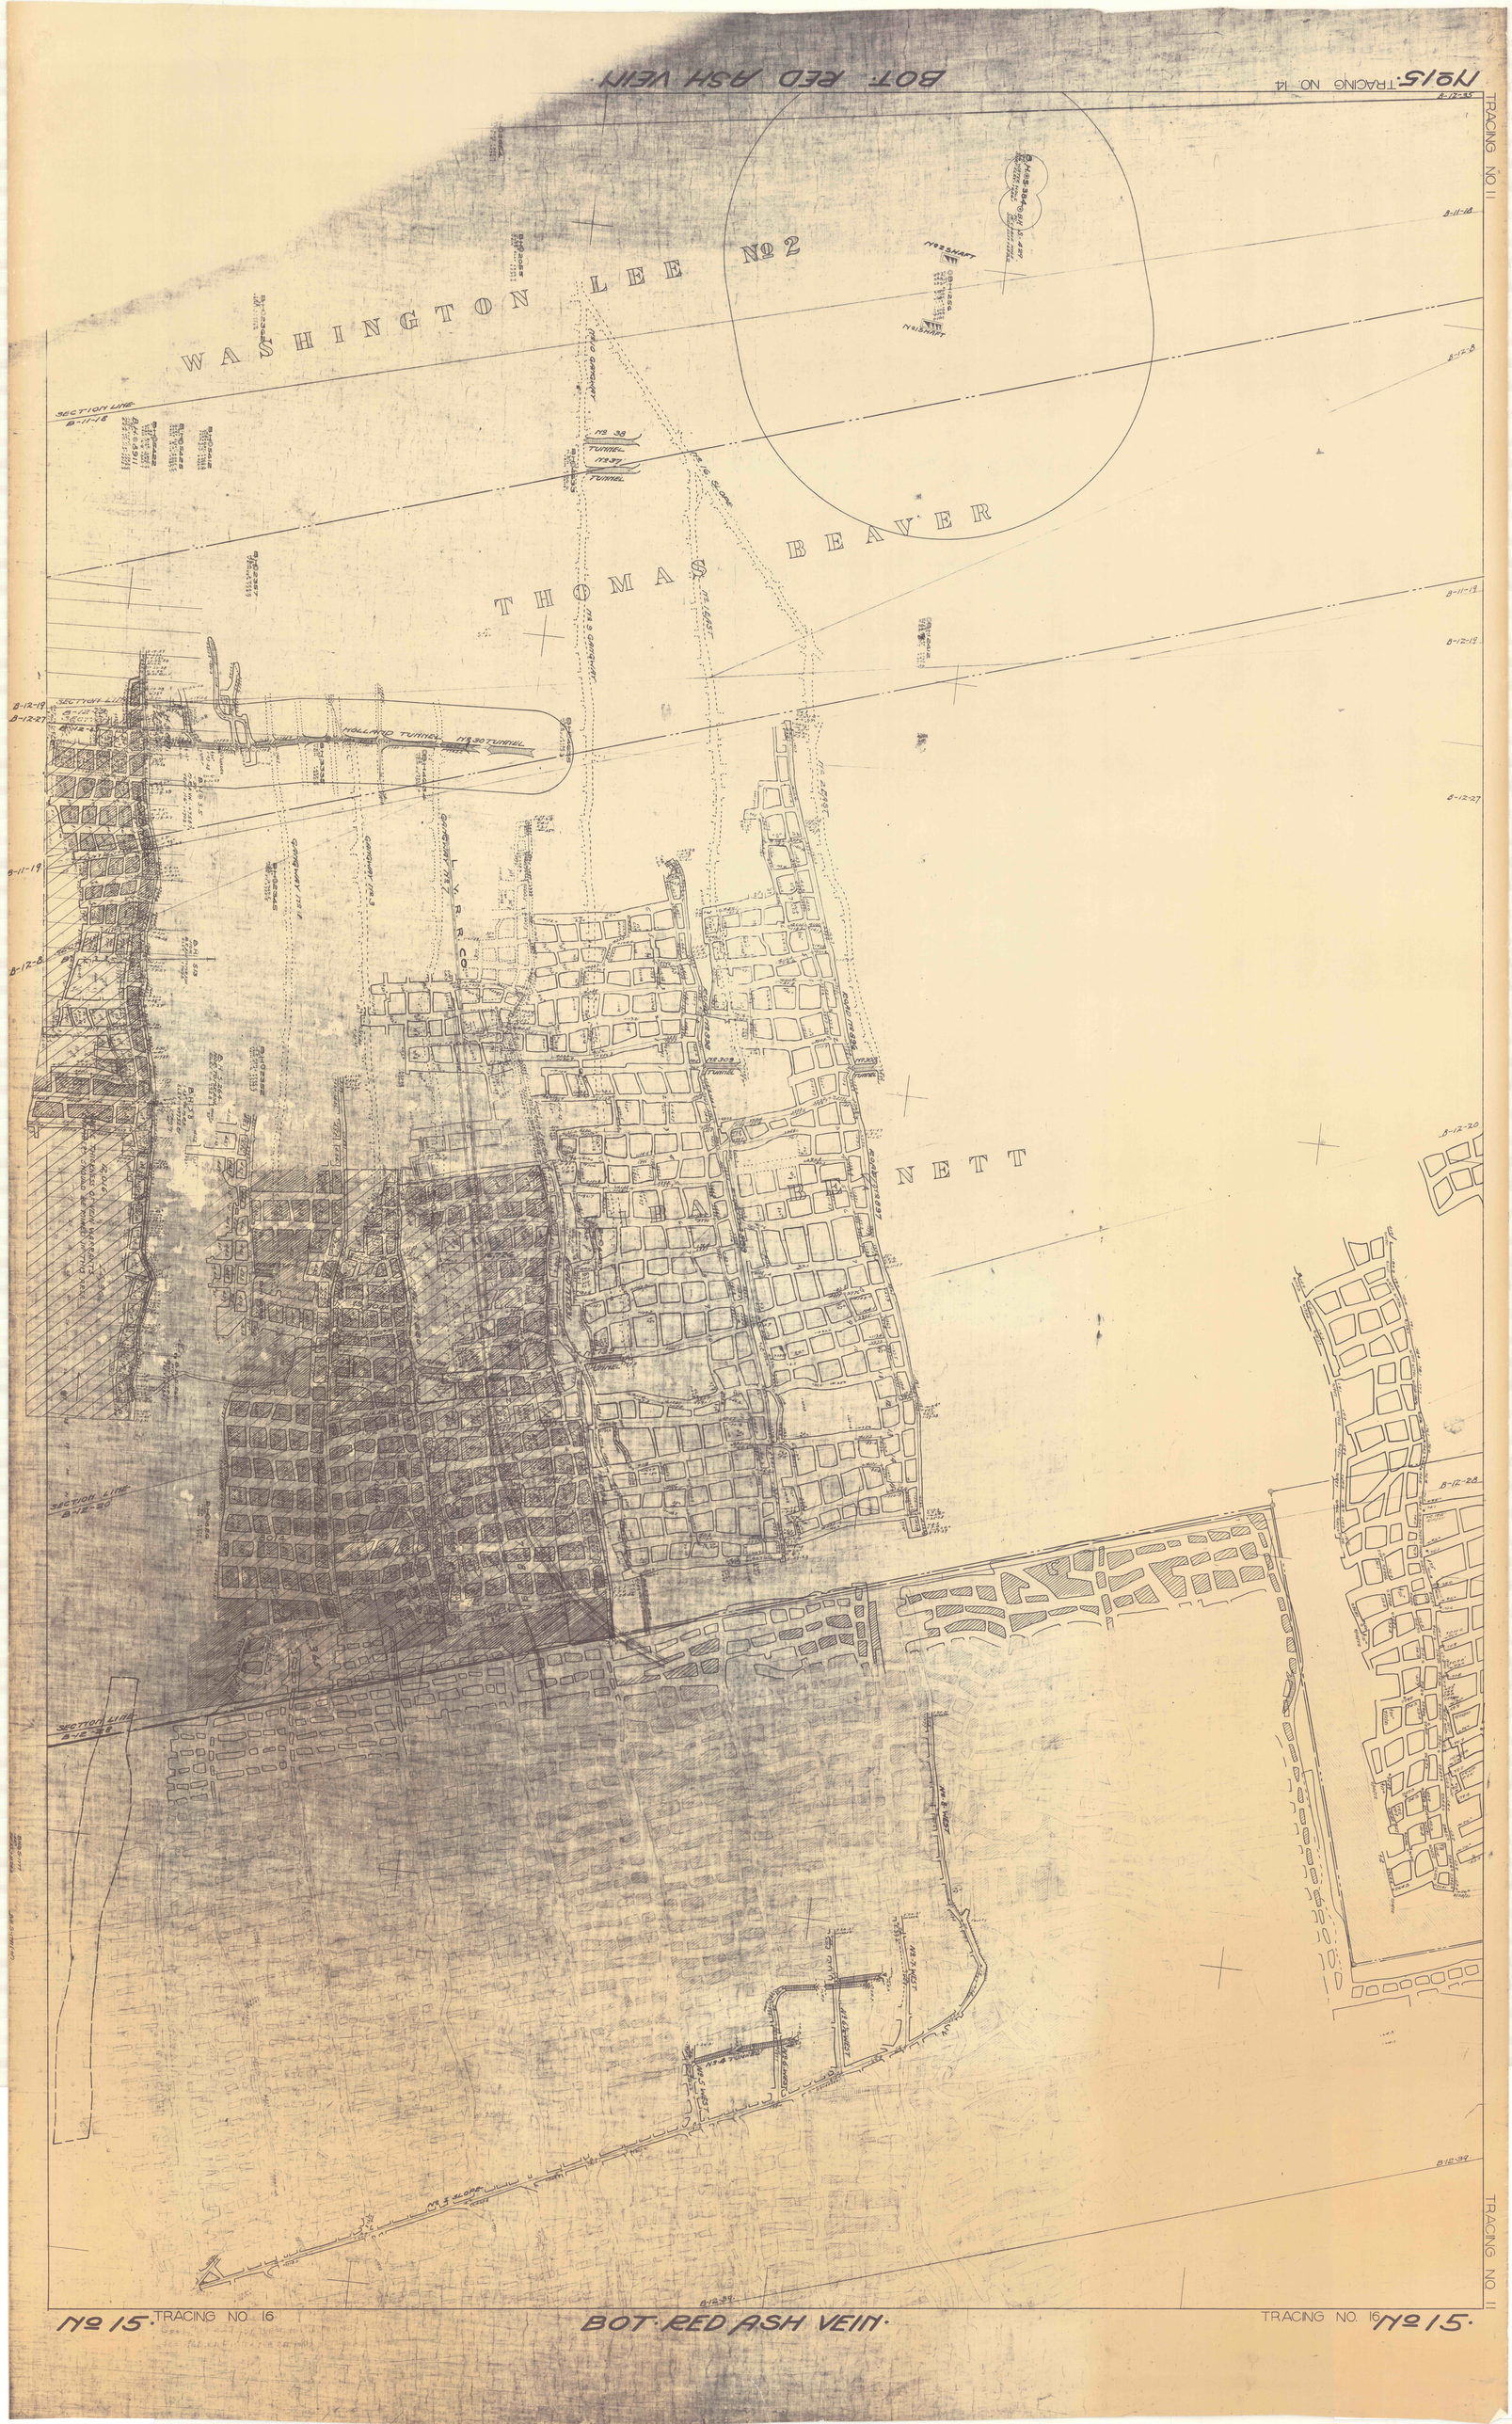

Nº 15. TRACING NO 16
BOT. RED ASH VEIN.
TRACING NO 16 Nº 15.
TRACING NO 11
Nº 15. TRACING NO 14
BOT. RED ASH VEIN
WASHINGTON LEE Nº 2
THOMAS BEAVER
NETT
L. V. R. R. CO.
SECTION LINE B-12-28
SECTION LINE B-11-18
SECTION LINE B-12-27
THESE THICKNESS OF VEIN WARRANTS CHAMBERS SHOULD BE MINED IN THIS AREA
GANGWAY Nº 1
GANGWAY Nº 3
GANGWAY Nº 7
Nº 9 GANGWAY
Nº 10 GANGWAY
Nº 1 EAST
Nº 2 EAST
Nº 16 SLOPE
HOLLAND TUNNEL
Nº 30 TUNNEL
Nº 37 TUNNEL
Nº 38 TUNNEL
Nº 1 SHAFT
Nº 2 SHAFT
B.H.1256
B.H.S-384
B.H. S-429
WATER HOLE
CABLE HOLE
B.H.2055
B.H.2054
B.H.2362
B.H.2357
B.H.5412
B.H.5425
B.H.5422
B.H.8911
B.H.3335
B.H.4634
B.H.4635
B.H.4633
B.H.2345
B.H.2352
B.H.12412
B.H.5.264
B.H.S.8
B.H.S.13
B.H.S.5
ROAD Nº 897
ROAD Nº 896
ROAD Nº 898
ROAD Nº 899
Nº 309 TUNNEL
Nº 308 TUNNEL
Nº 4 SLOPE
Nº 5 WEST
Nº 6 WEST
Nº 6½ WEST
Nº 7 WEST
Nº 8 WEST
Nº 14 TUNNEL
B-12-39
B-12-28
B-12-20
B-12-27
B-12-19
B-11-19
B-12-8
B-11-18
B-12-35