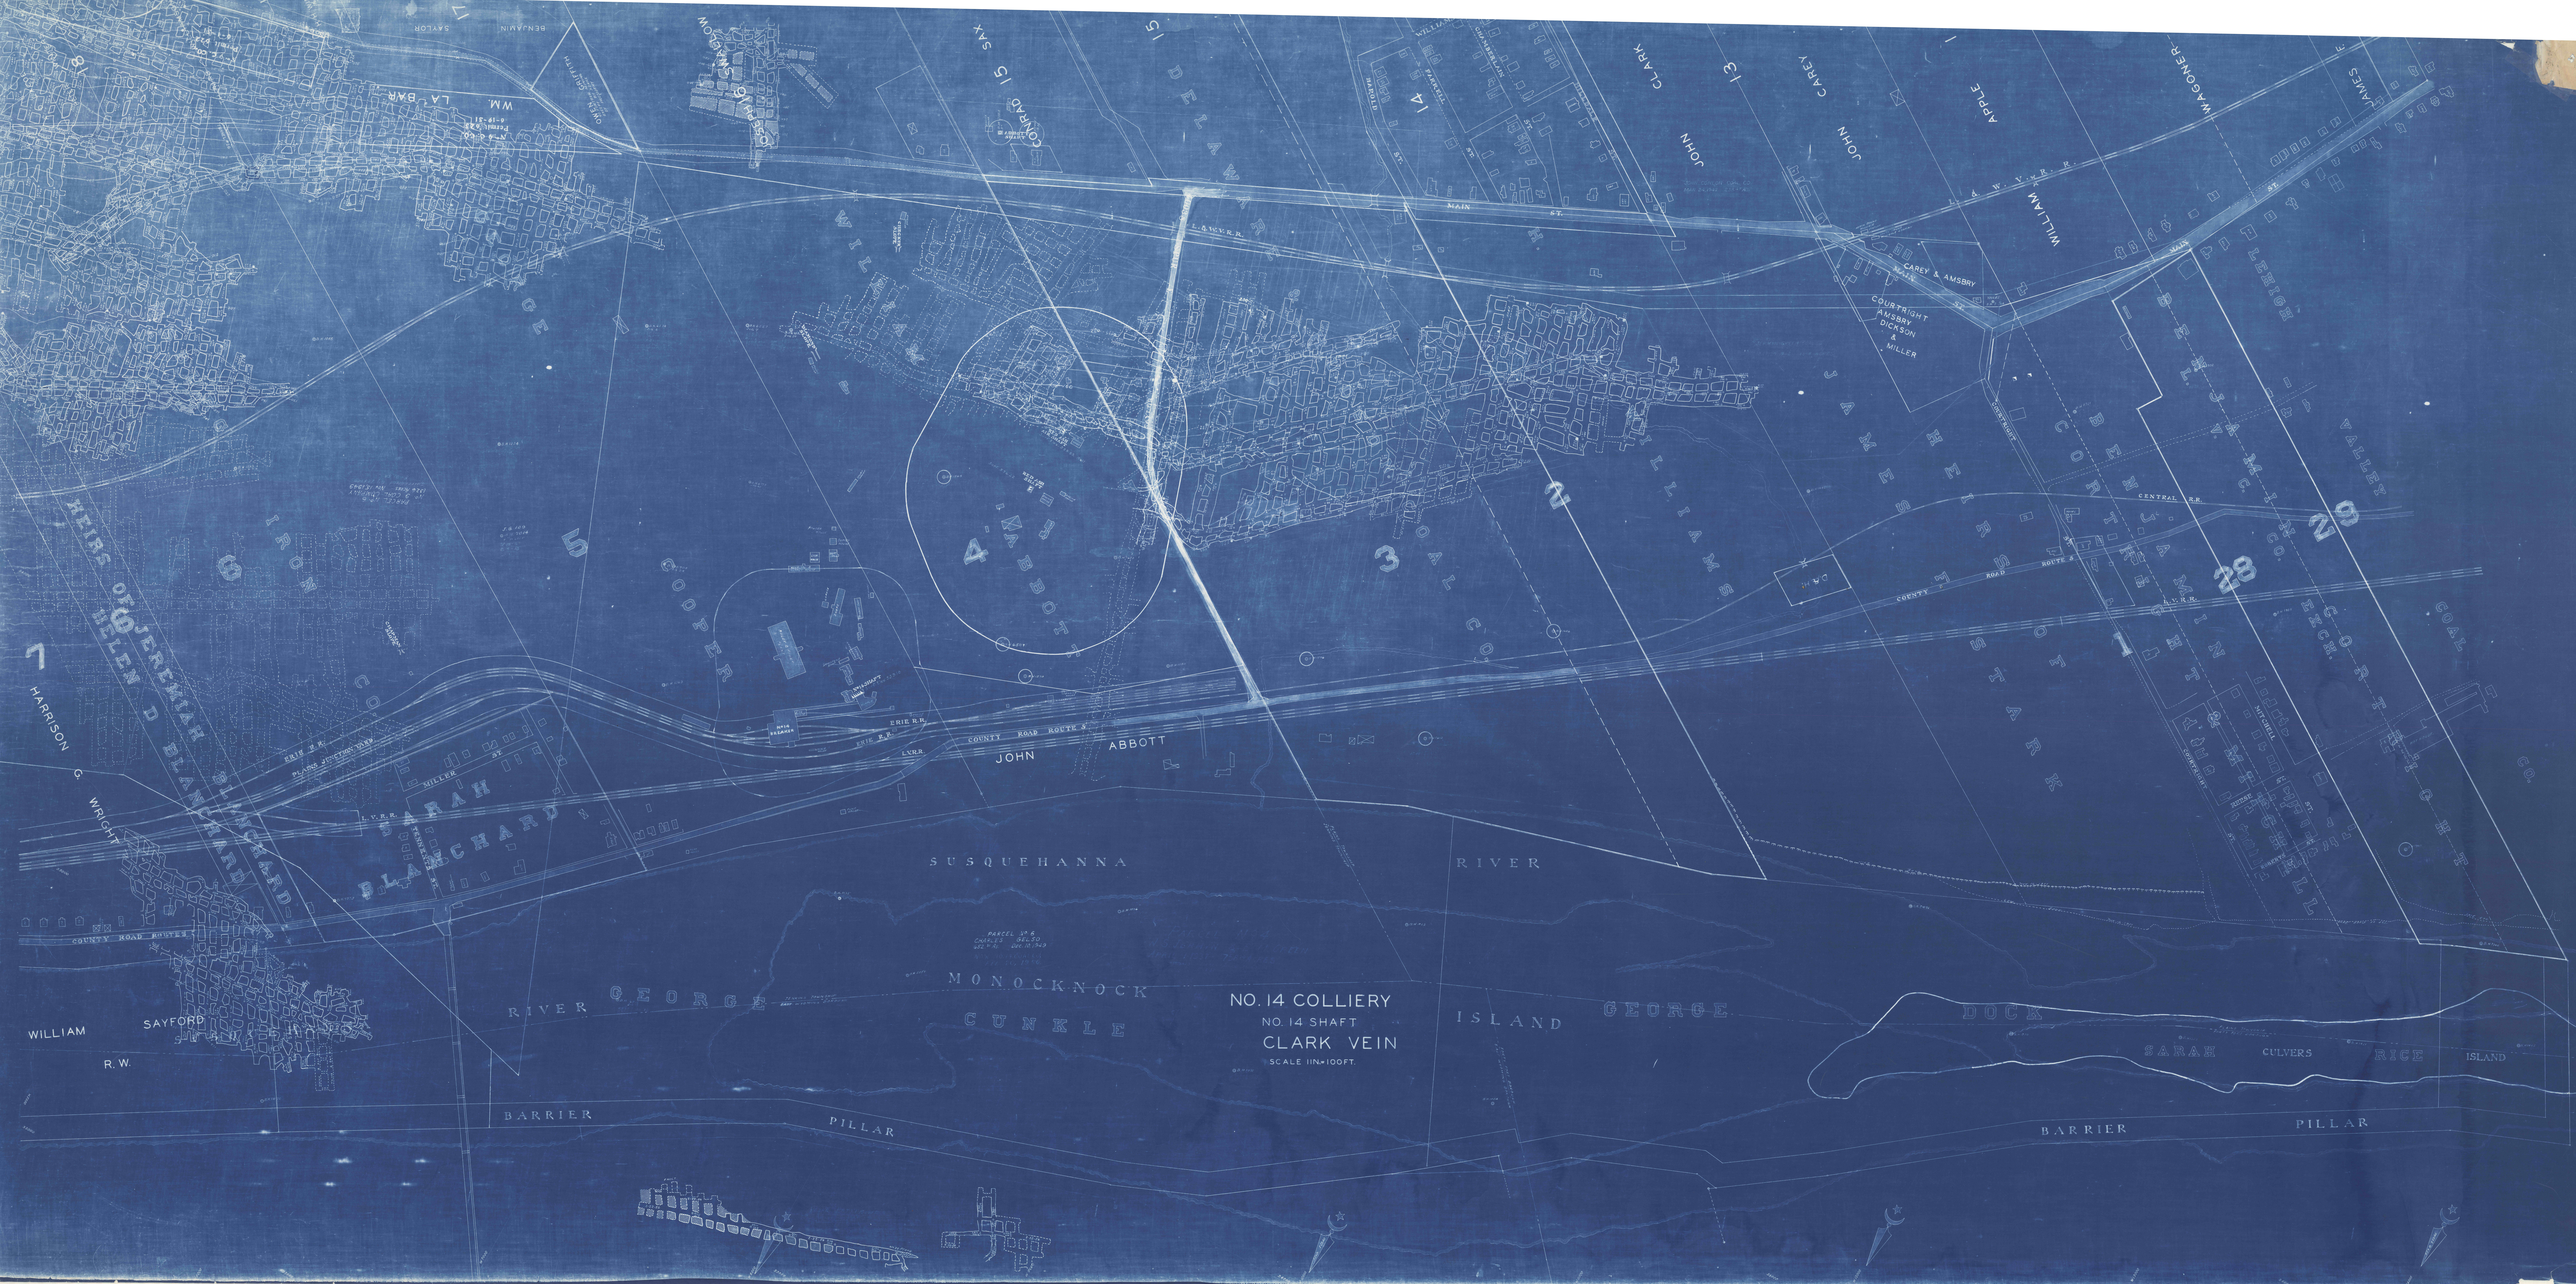

NO. 14 COLLIERY
NO. 14 SHAFT
CLARK VEIN
SCALE 1IN.=100FT.
SUSQUEHANNA
RIVER
MONOCKNOCK
CUNKLE
ISLAND
GEORGE
DOCK
BARRIER
PILLAR
SARAH
CULVERS
RICE
ISLAND
WILLIAM
SAYFORD
R.W.
HARRISON G. WRIGHT
HEIRS OF JEREMIAH & HELEN D. BLANCHARD
SARAH BLANCHARD
JOHN ABBOTT
COUNTY ROAD ROUTE 8
ERIE R.R.
L.V.R.R.
CENTRAL R.R.
MAIN ST.
COURTRIGHT AMSBRY DICKSON & MILLER
CAREY & AMSBRY
WILLIAM
JOHN
CLARK
APPLE
CAREY
WAGONER
JAMES
PHILLIPS
LEGION
VALLEY
ENCHORT
GOAL CO.
IRON CO.
COOPER
GEORGE
SAX
CONRAD
MOSHER
WM. LA BAR
BENJAMIN
SAYLOR
MILLER ST.
MITCHELL ST.
CHURCH ST.
SHERIDAN ST.
WILLIAM ST.
1
2
3
4
5
6
7
8
9
10
11
12
13
14
15
16
17
18
19
20
21
22
23
24
25
26
27
28
29