
LEE SEAM - NORTHERN SECTION

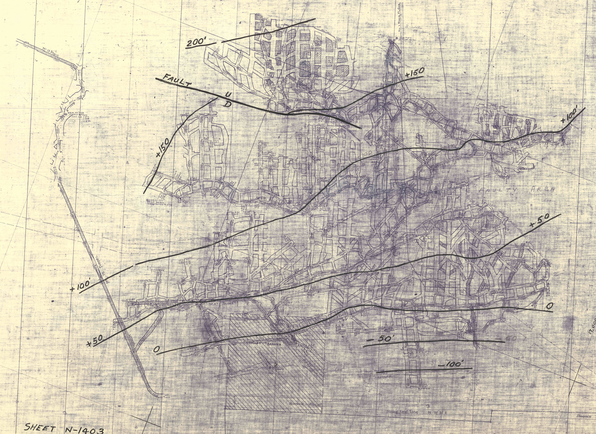

SHEET N-1403
TUBE N- 302

SUSQUEHANNA COLLIERIES CO.
Nº 8 COLLIERY
LEE SEAM-NORTHERN SECTION
Scale 1"=50' Geo. Lyon Oct. 15, 1935.
Asst. Engineer

LEE SEAM - NORTHERN SECTION