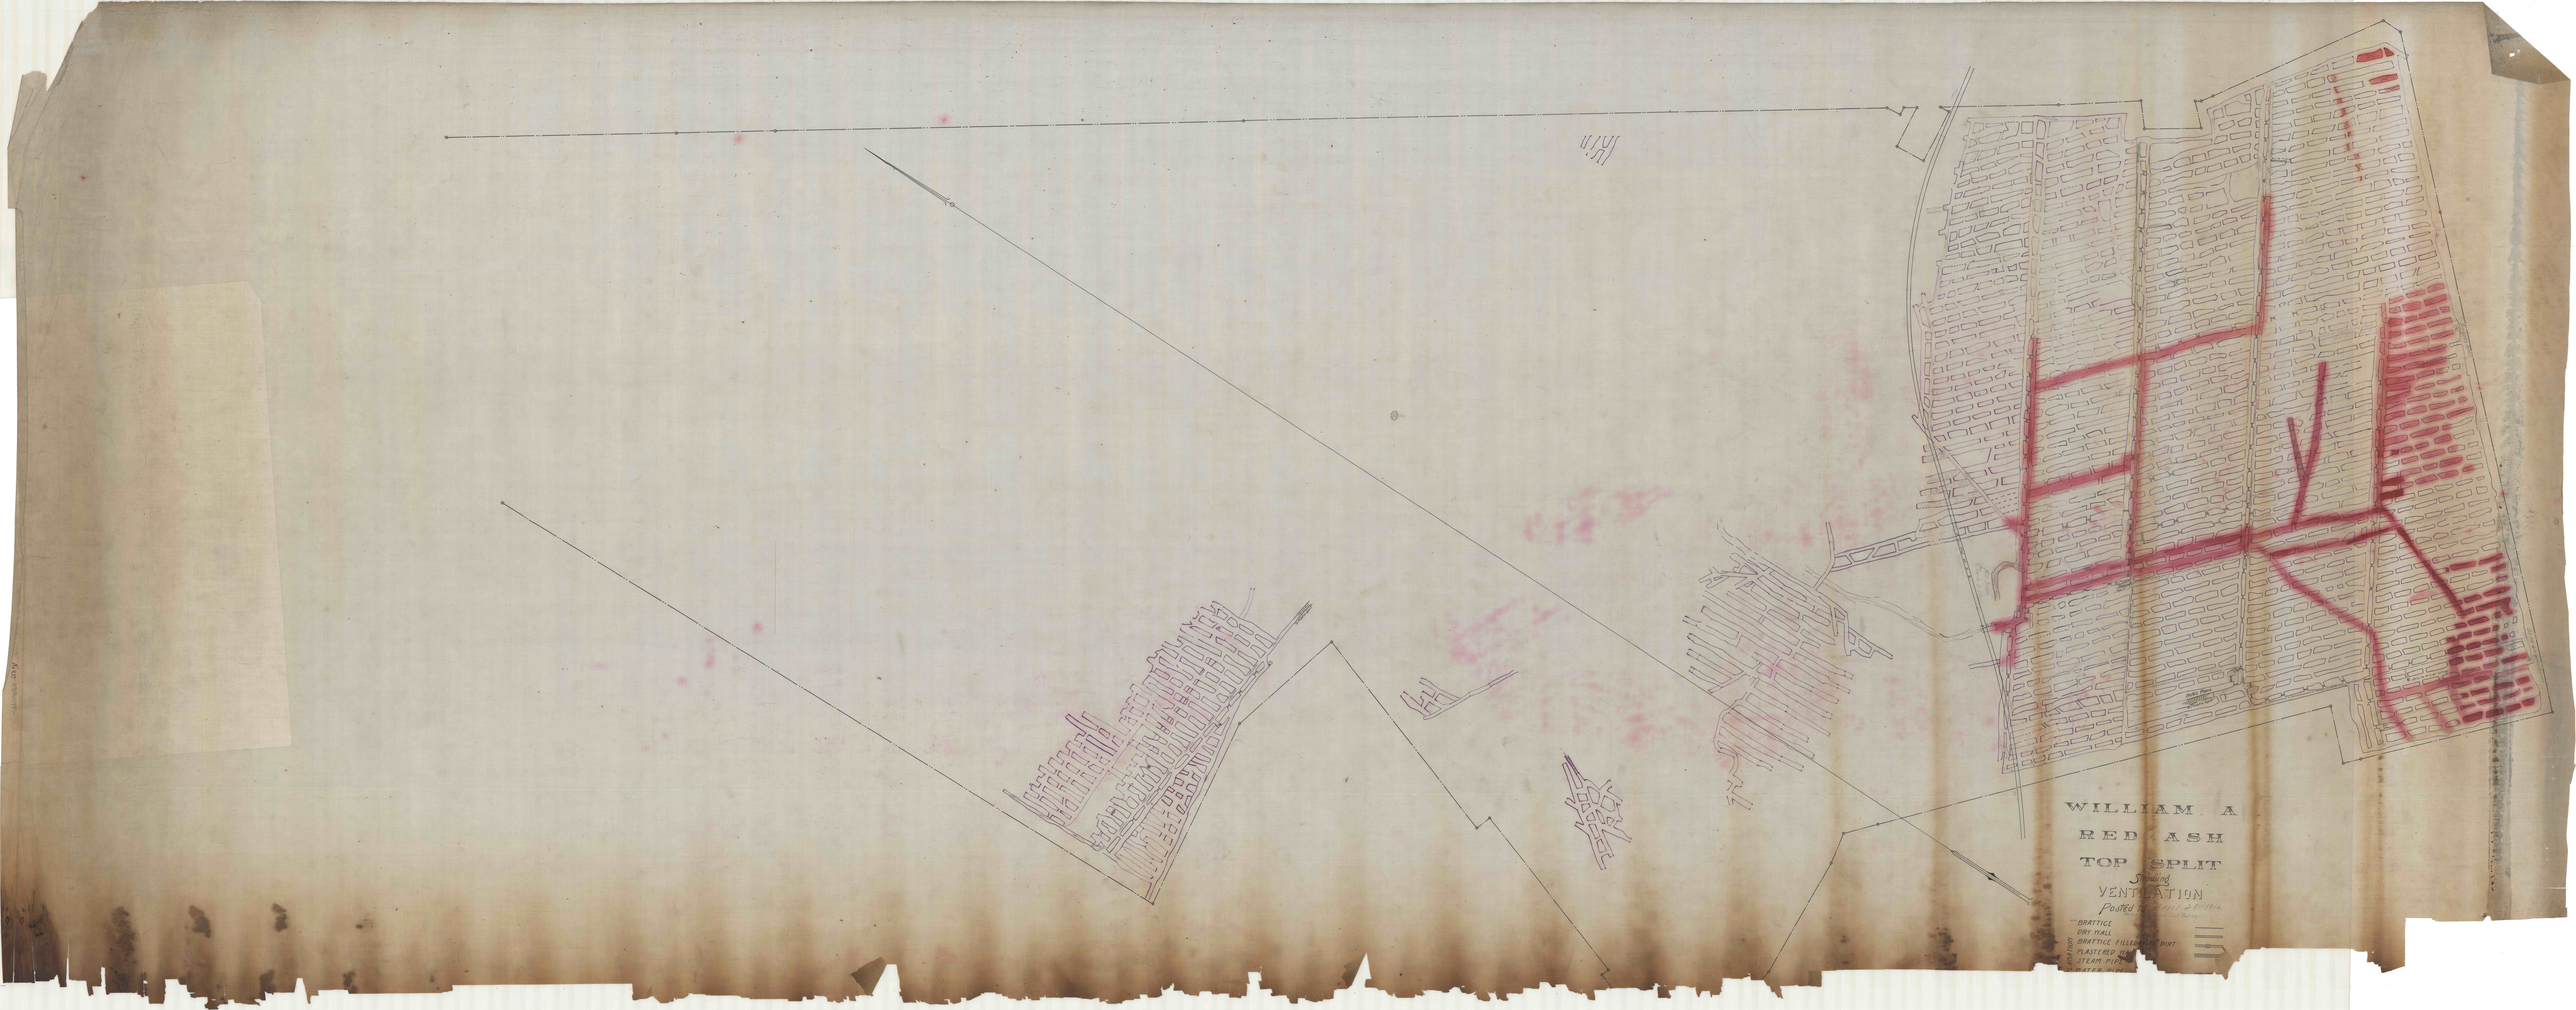

WILLIAM A
RED ASH
TOP SPLIT
Showing
VENTILATION
BRATTICE
DRY WALL
BRATTICE FILLED WITH DIRT
PLASTERED
STEAM PIPE