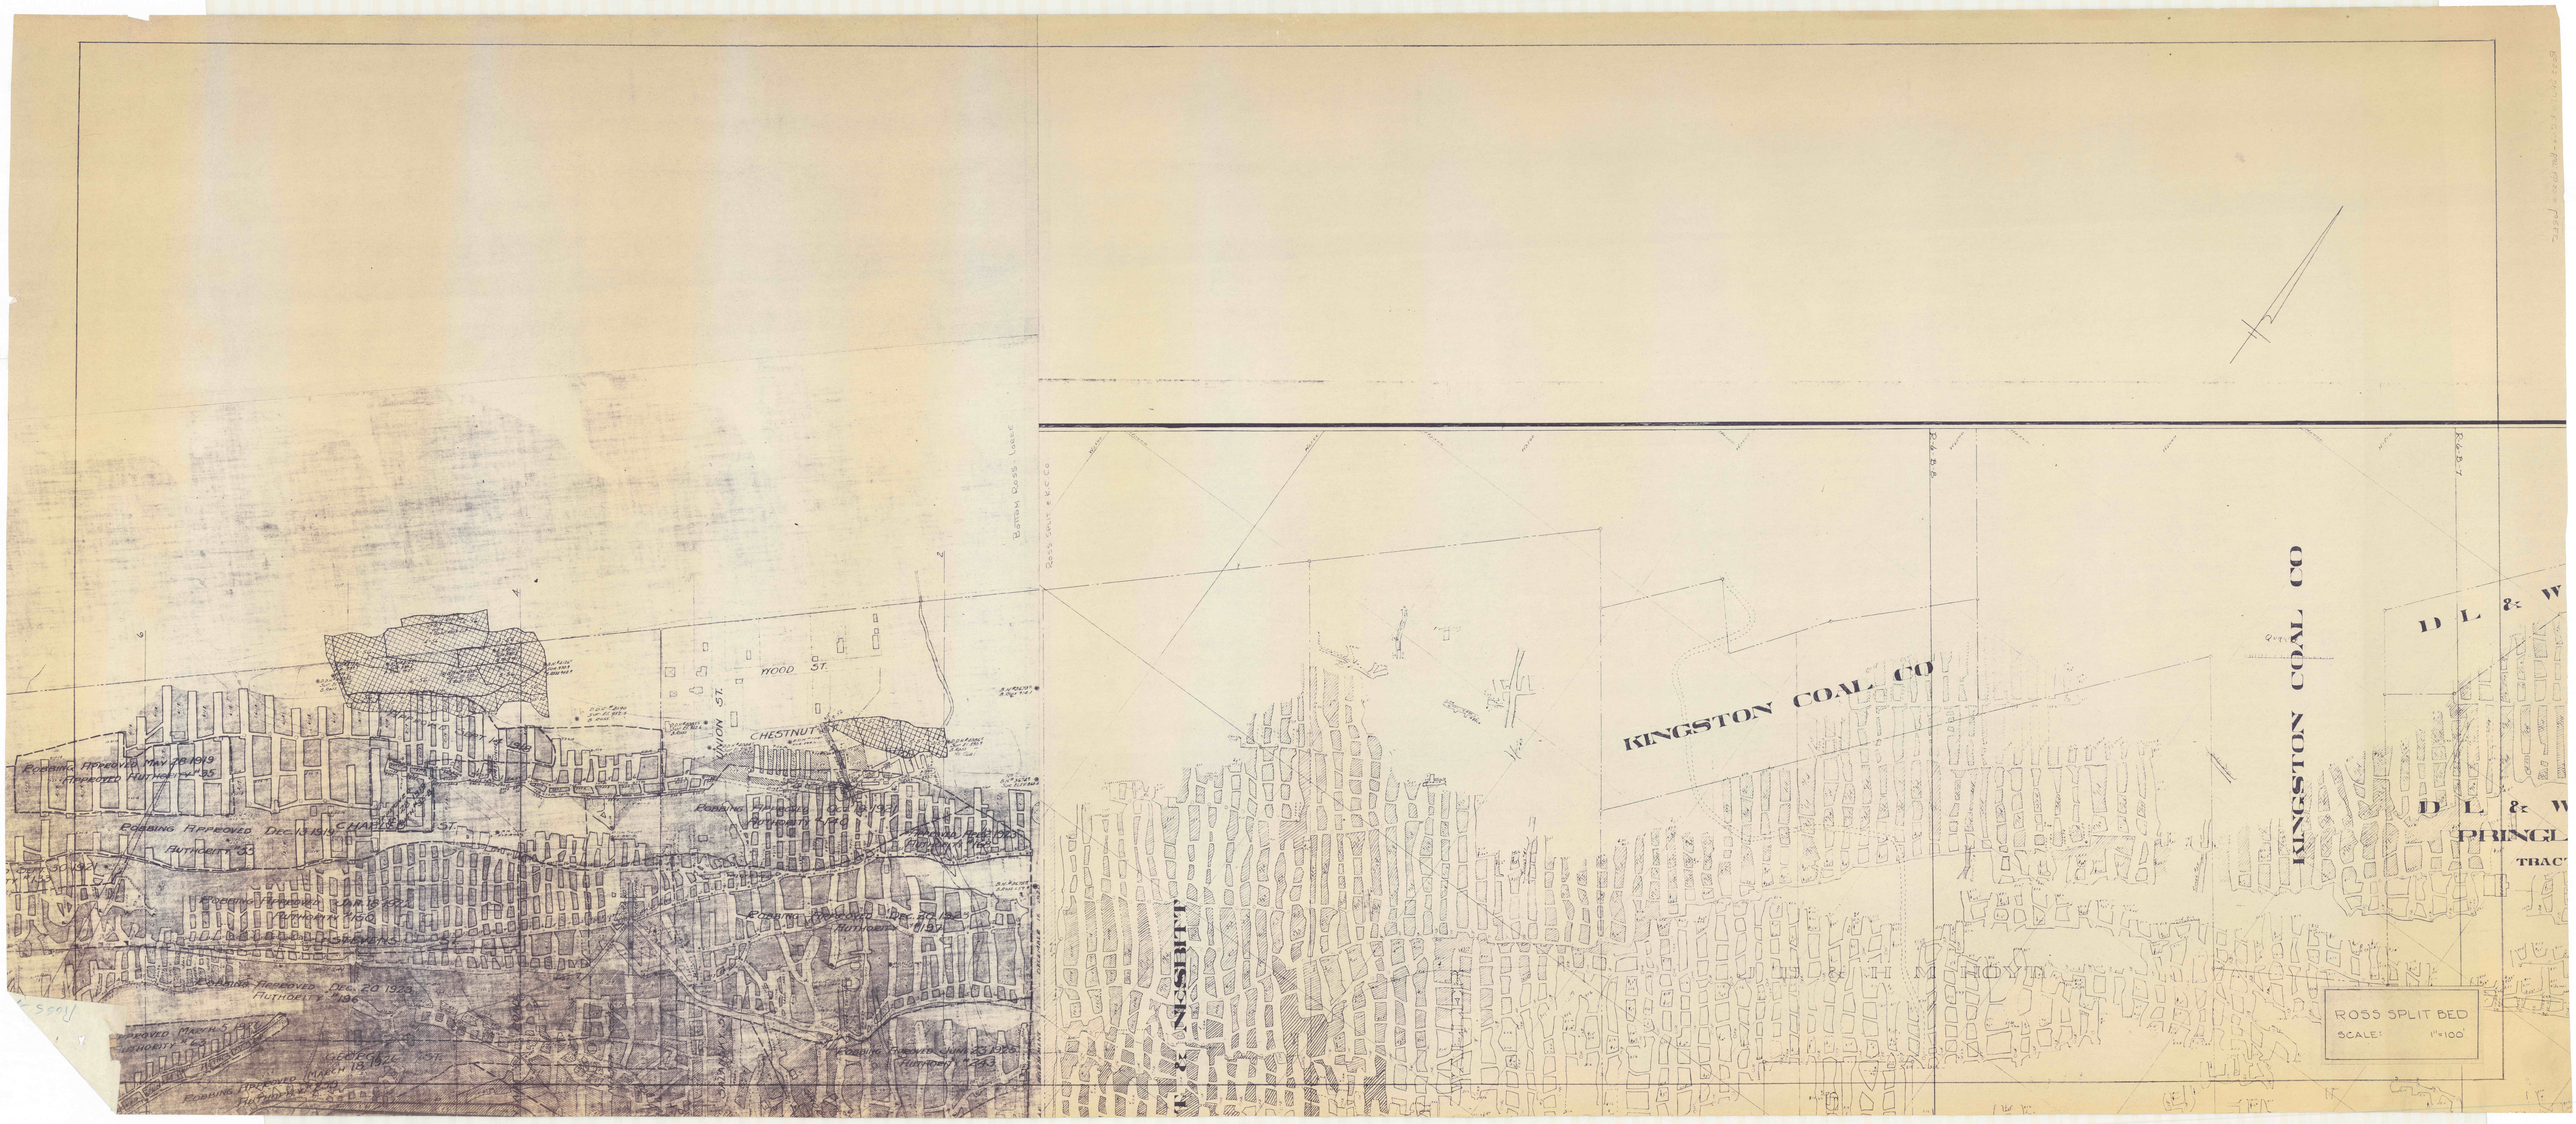

KINGSTON COAL CO
KINGSTON COAL CO
D L & W
D L & W
PRINGL
TRAC
ROSS SPLIT BED
SCALE: 1"=100'
WOOD ST.
CHESTNUT ST.
UNION ST.
MAIN ST.
Ross Split + K.C. Co
Boston Ross - Lease
Pooling Approved May 28 1919 Authority 85
Pooling Approved Dec. 13 1919 Authority 93
Pooling Approved Jan. 16 1922 Authority 160
Pooling Approved Dec. 20 1923 Authority 196
Pooling Approved March 5 1924 Authority 213
Pooling Approved March 13 1924 Authority 214
Pooling Approved Dec. 30 1924 Authority 197
Pooling Approved June 25 1925 Authority 233