
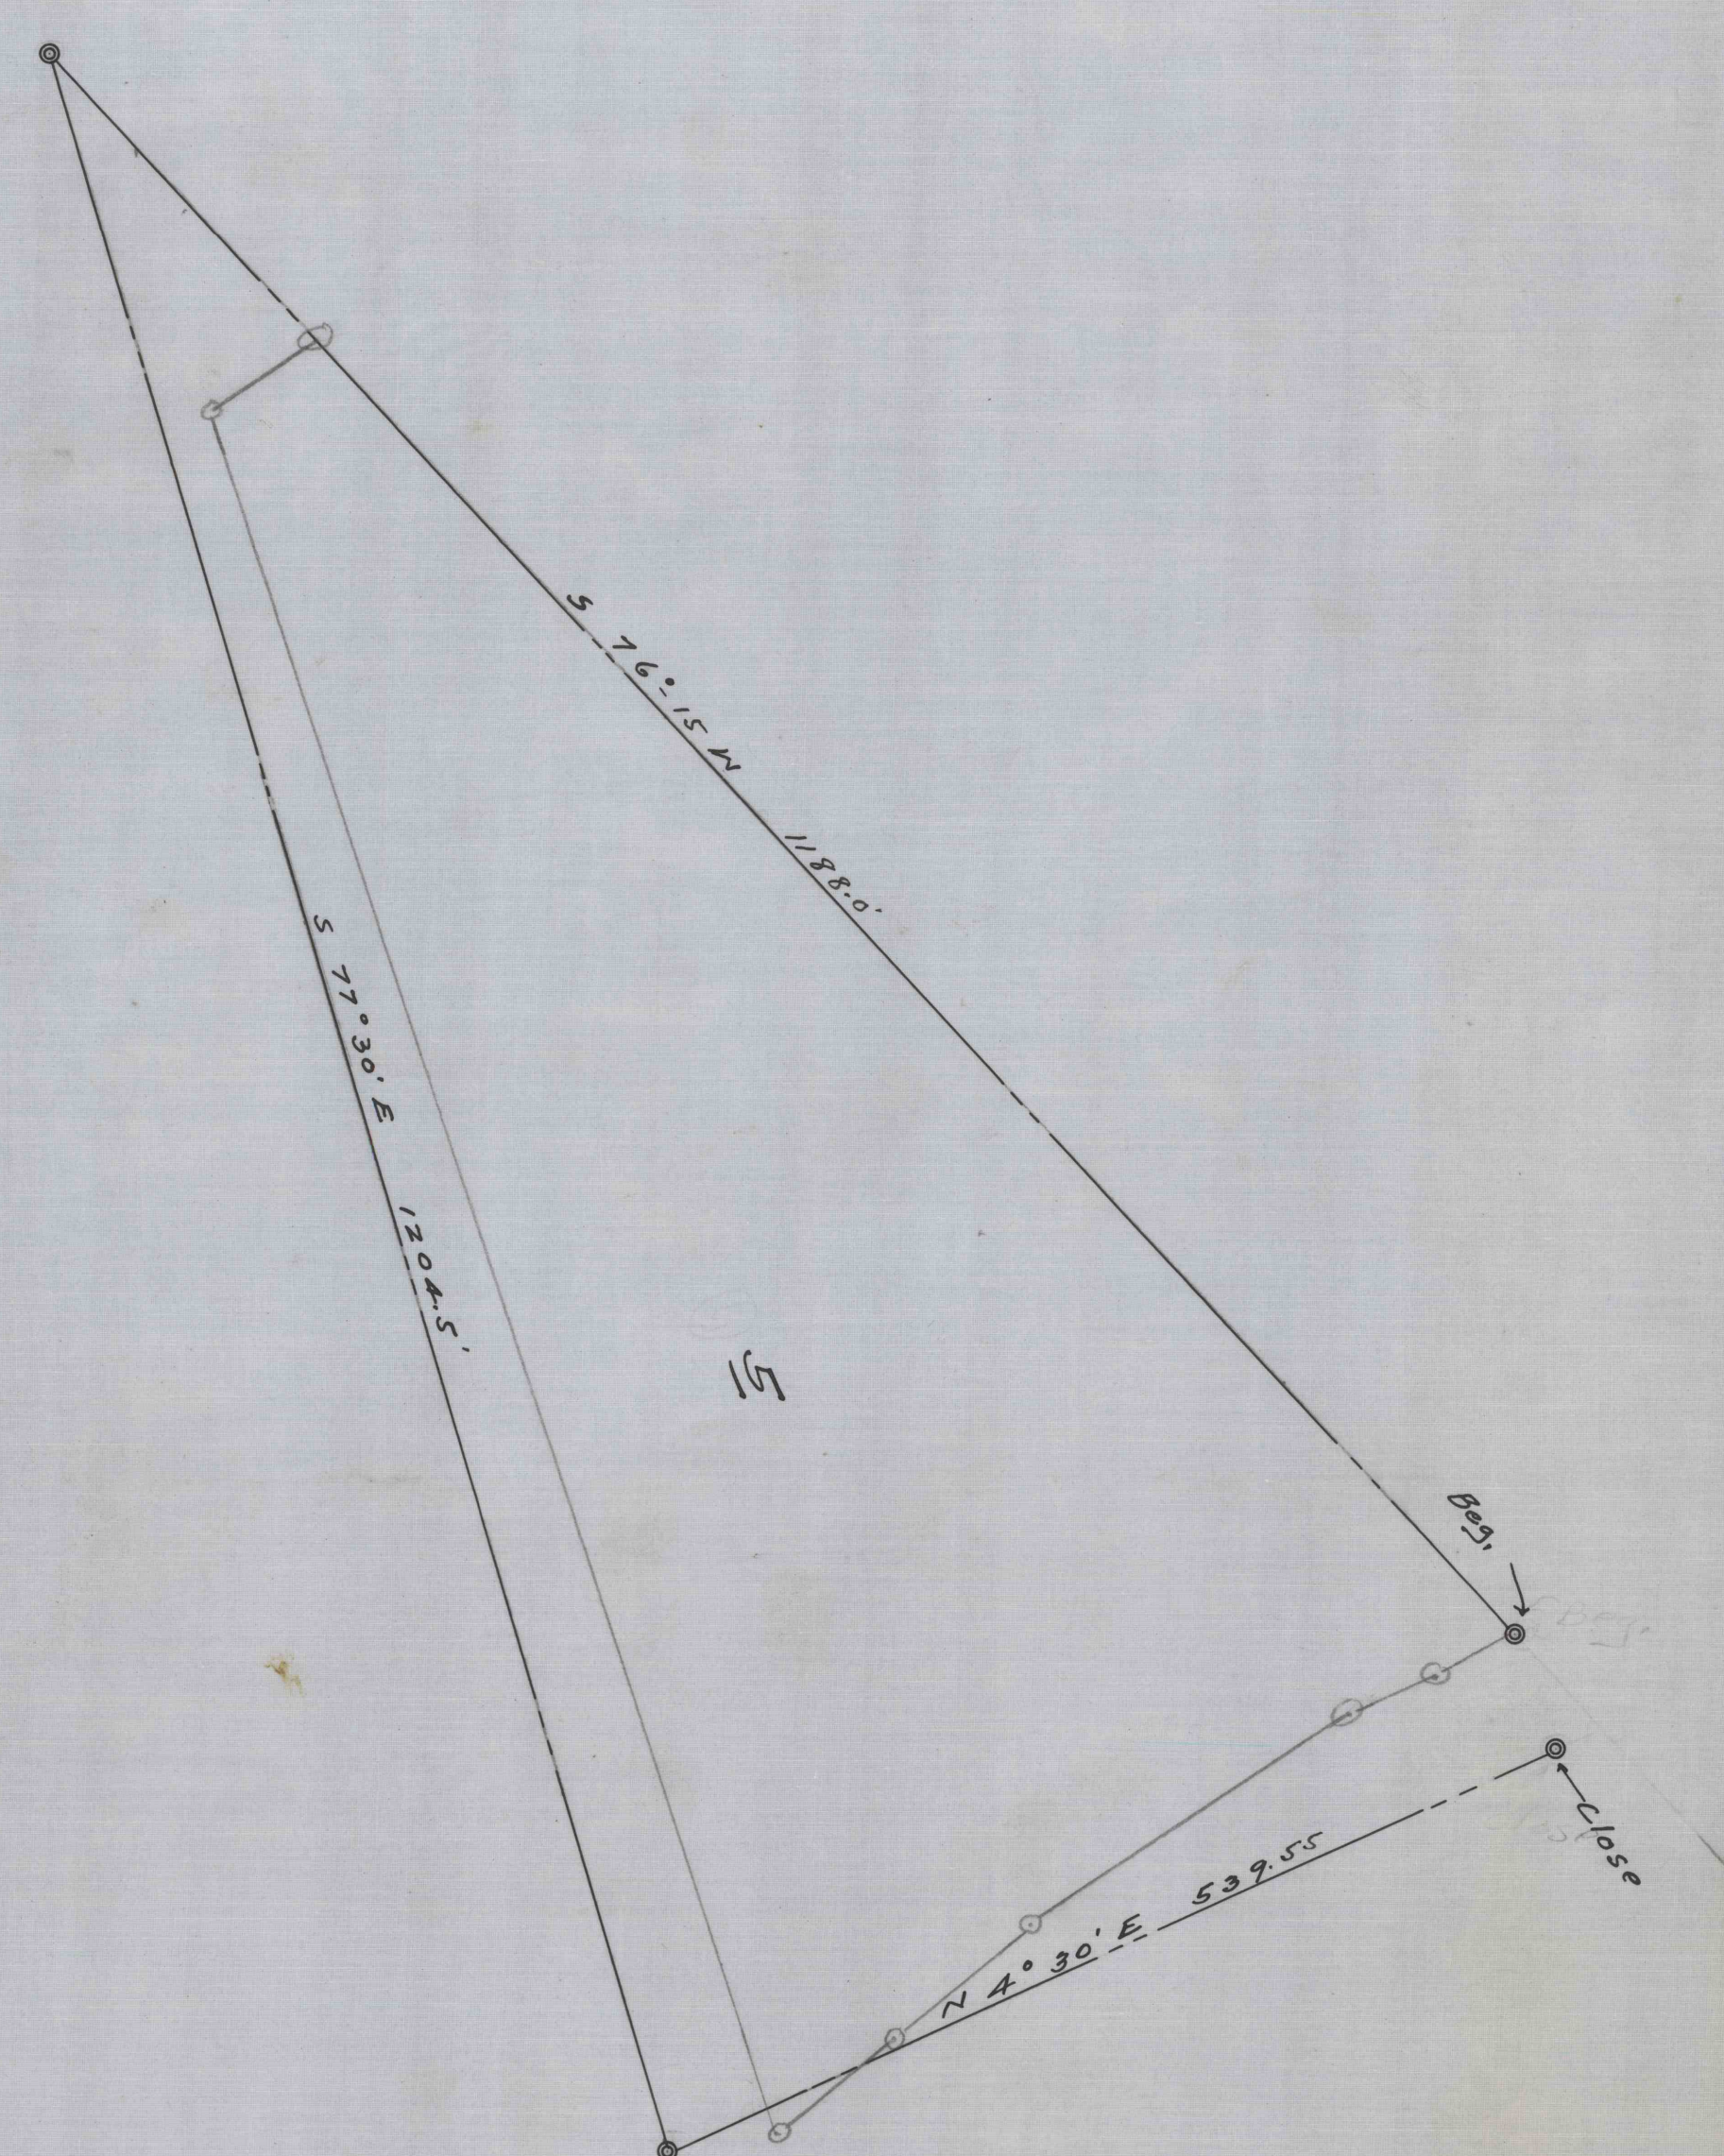
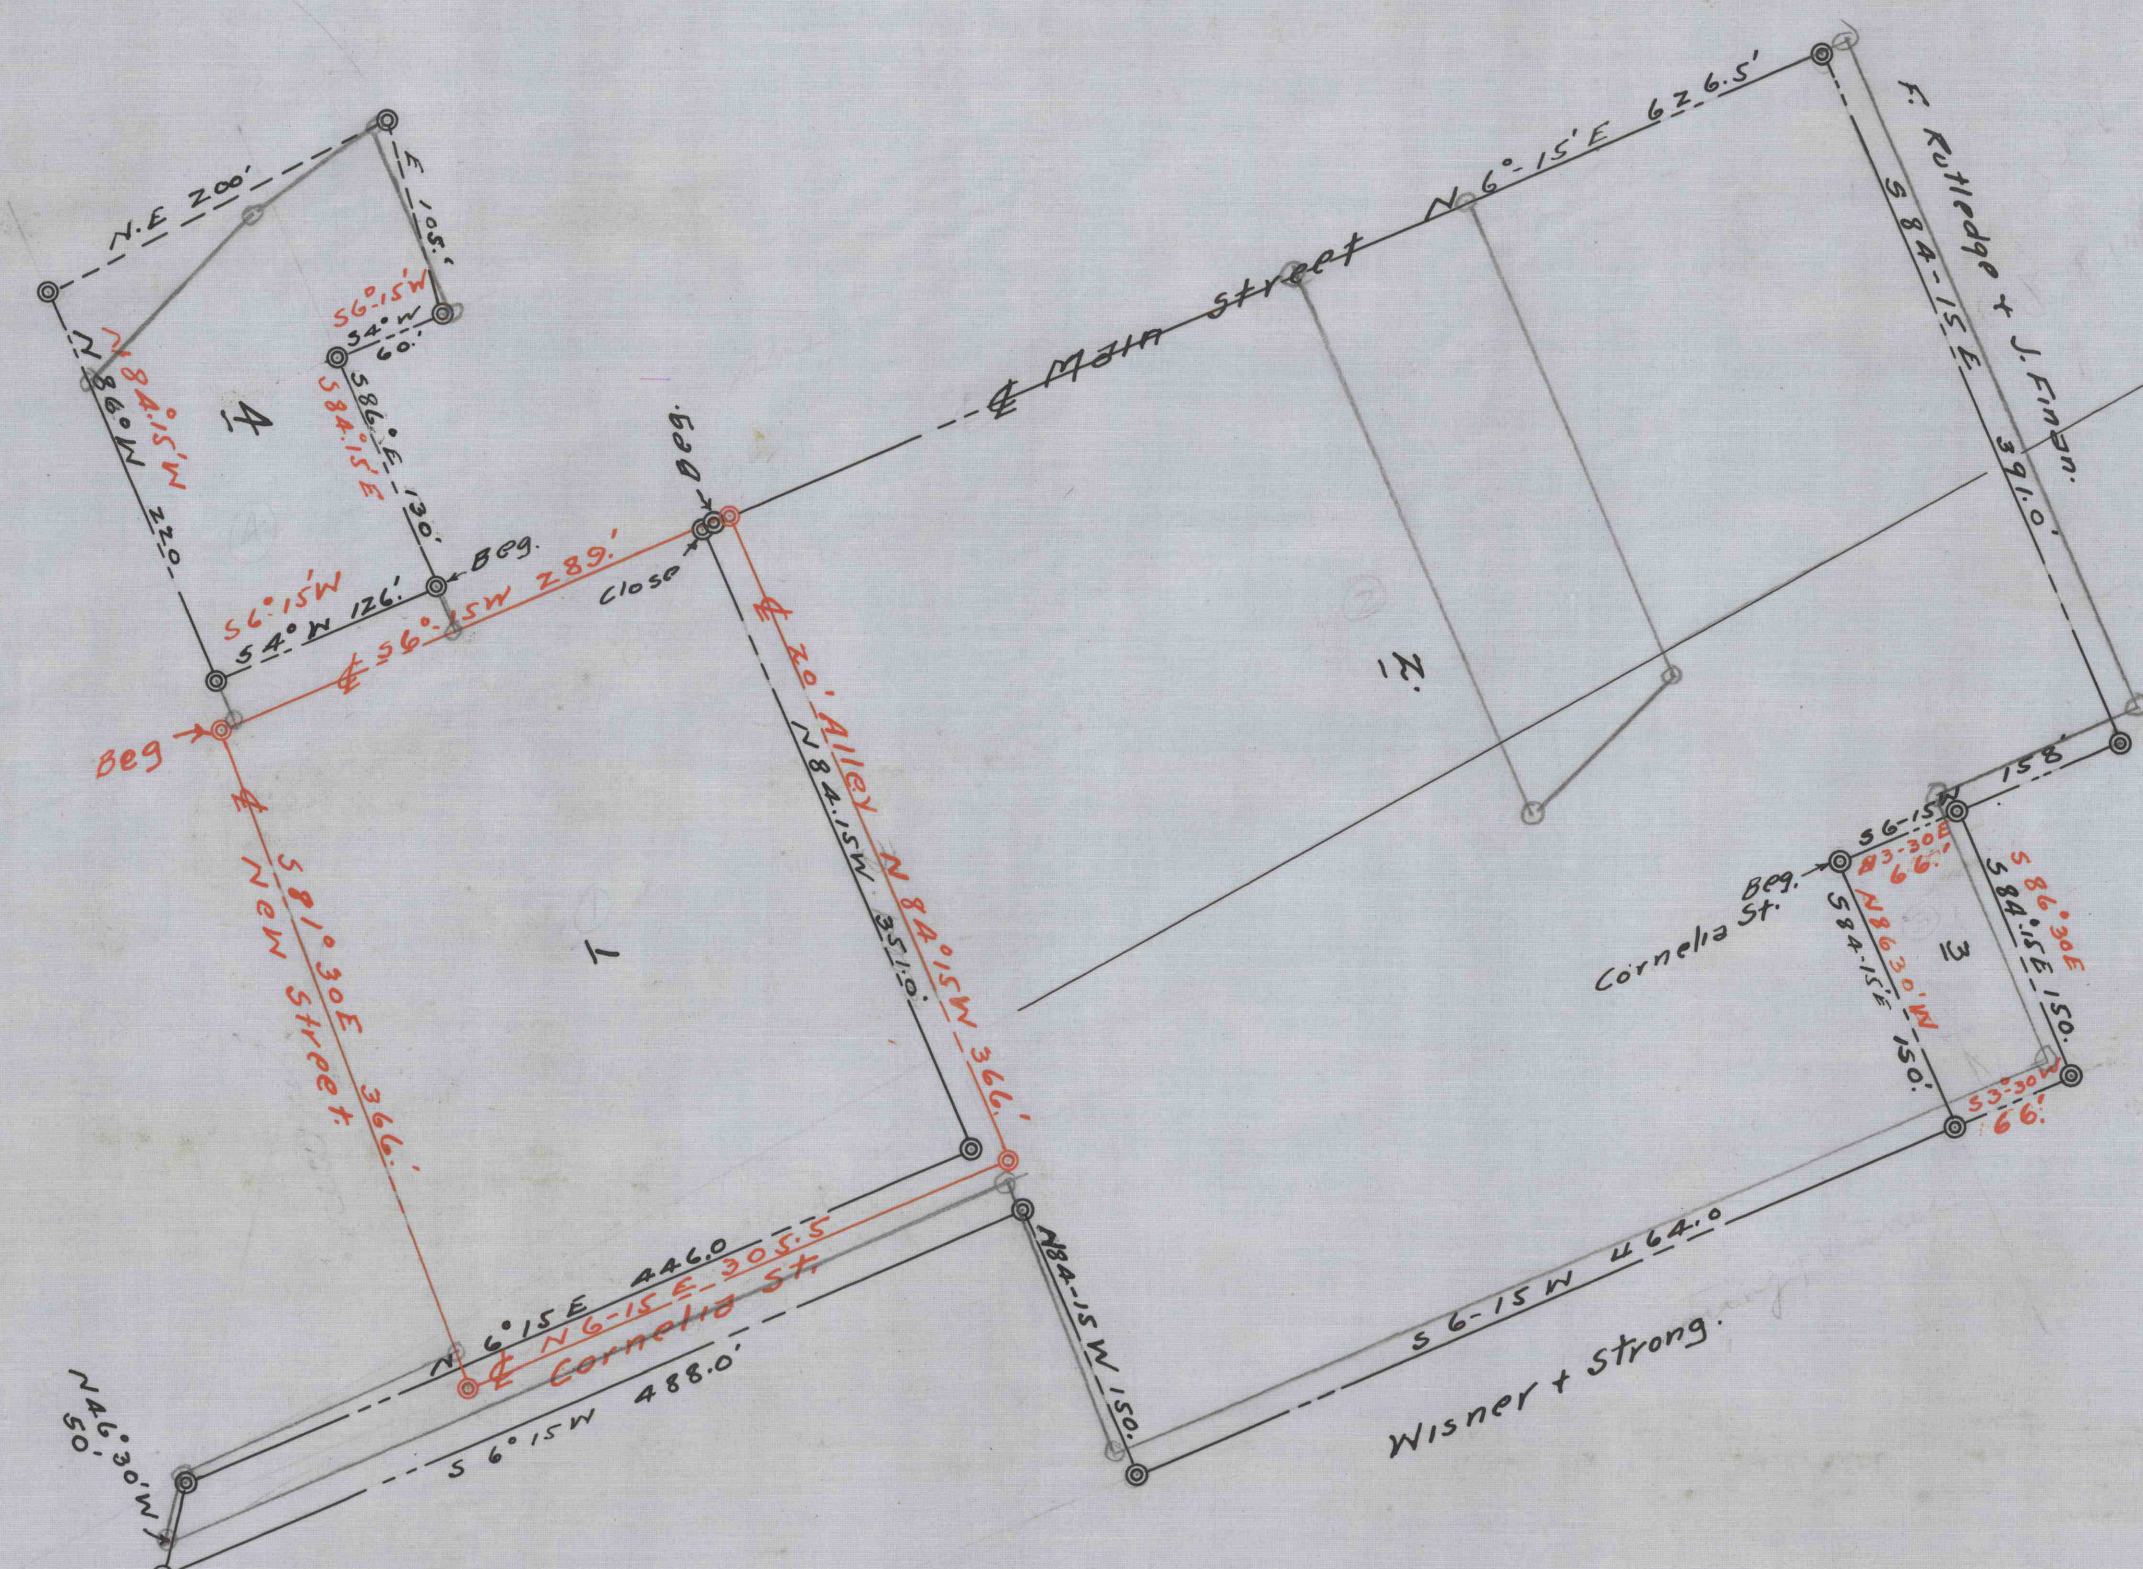


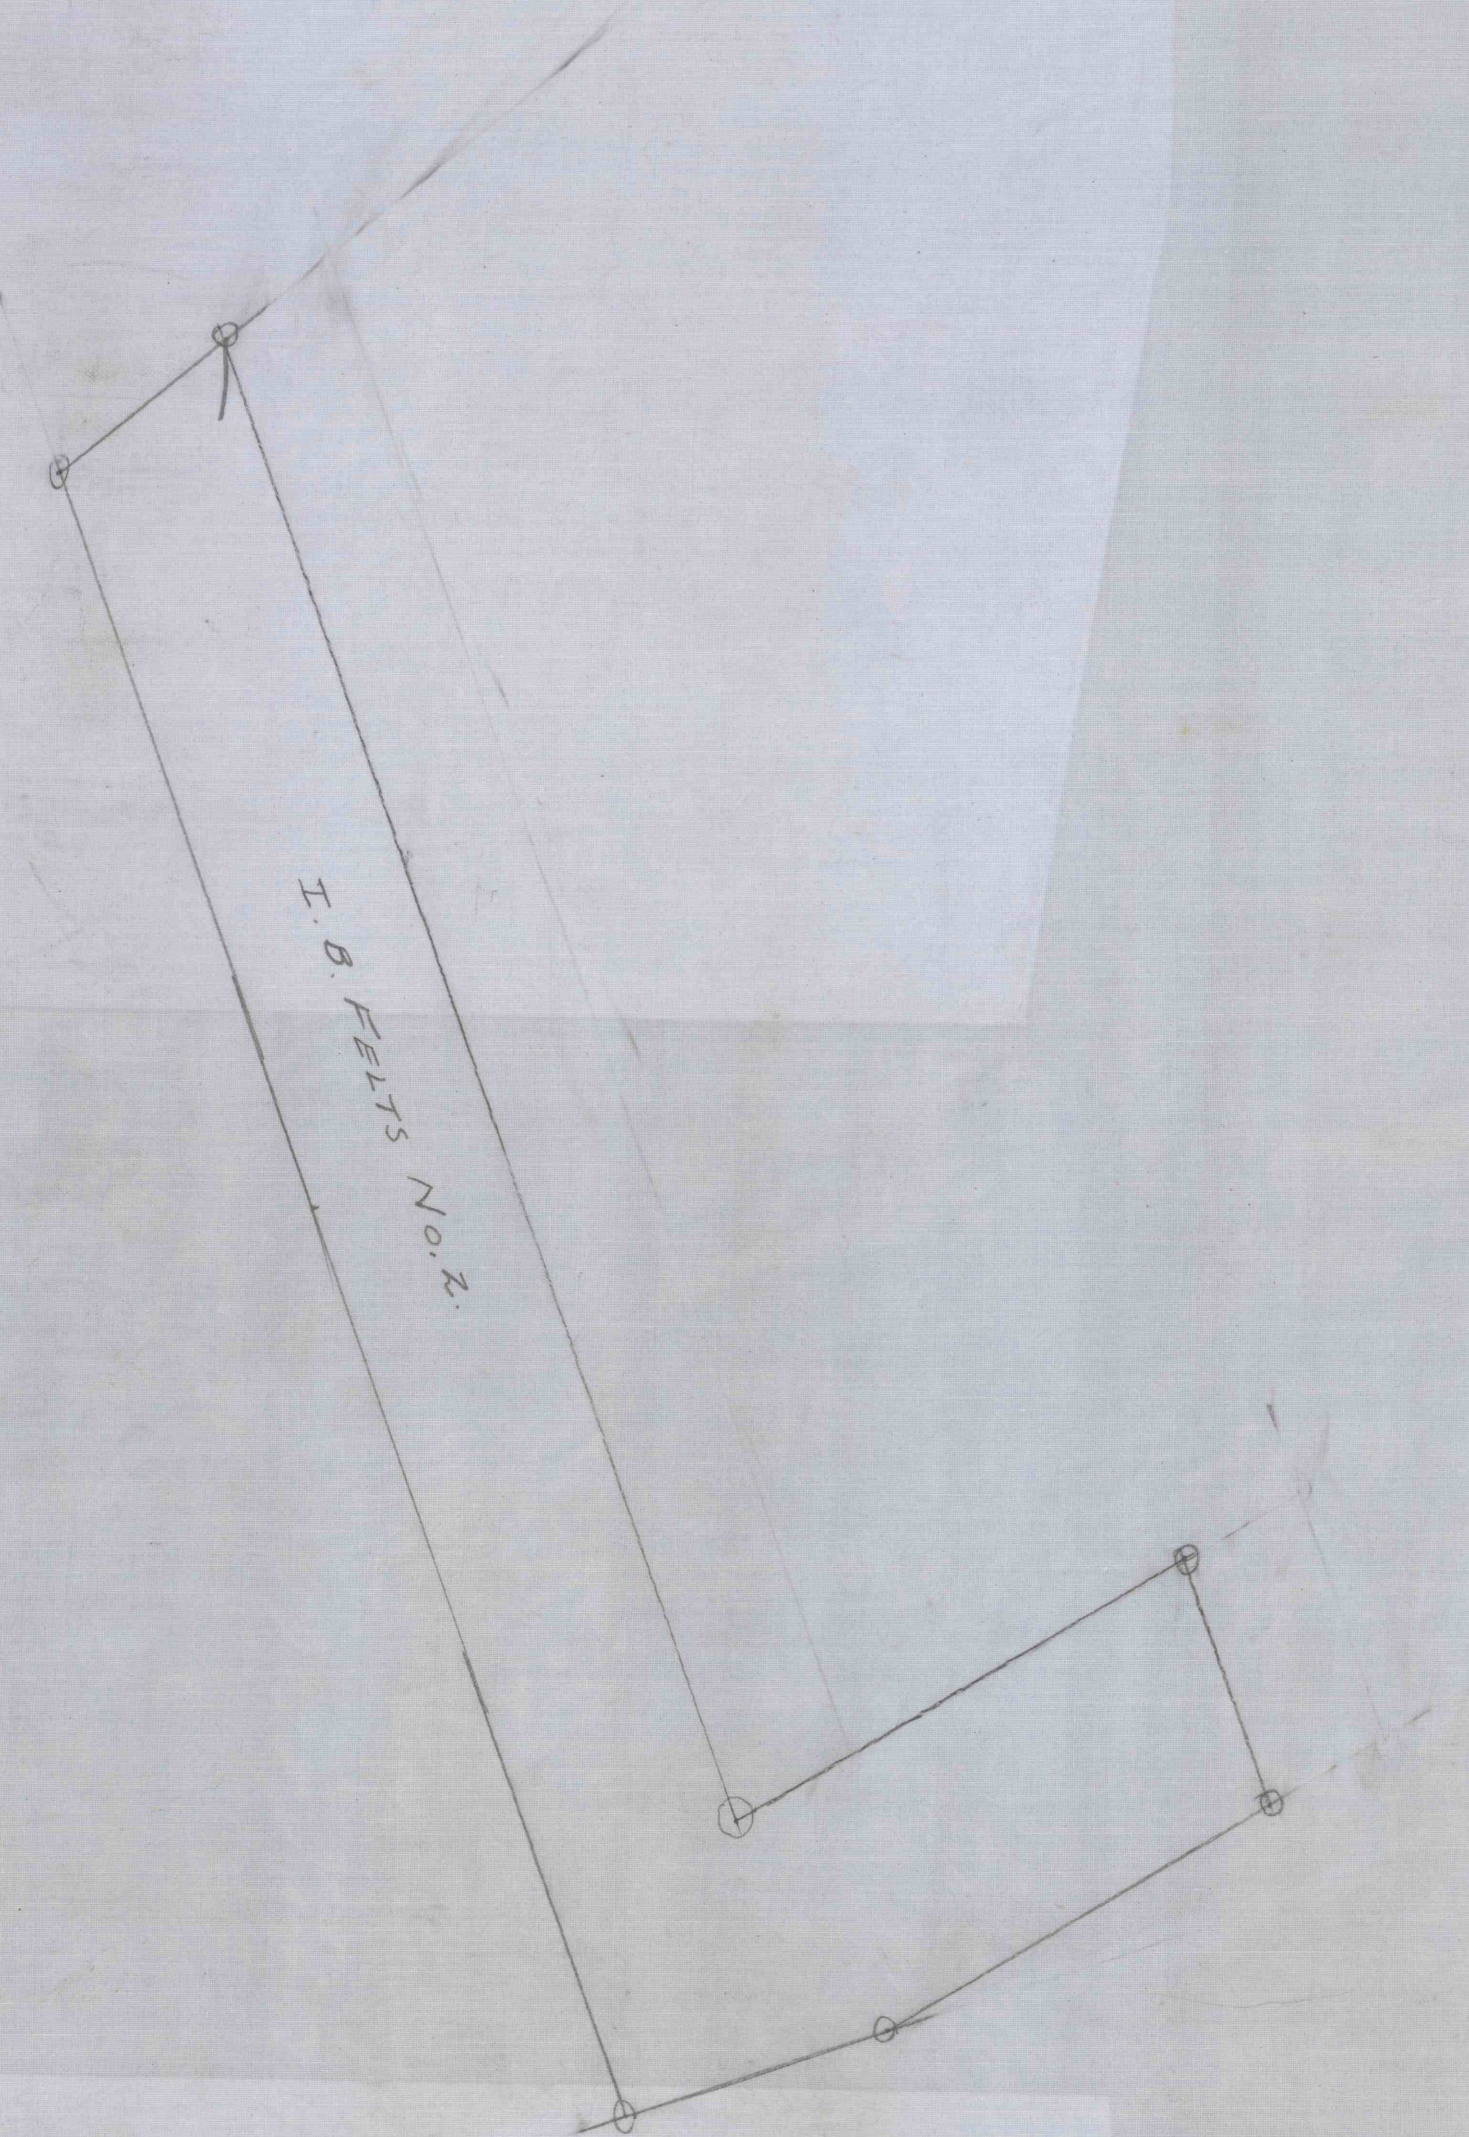

SENECA COLLIERY
 I.D. FELTS No. 2 Tracts
 Plotted from Description in Lease Book of
 Norton Coal Mining Co.
 Backs Div. Engr. Dept.
 Scale 1" = 100'
 8-19-30