


2-1060

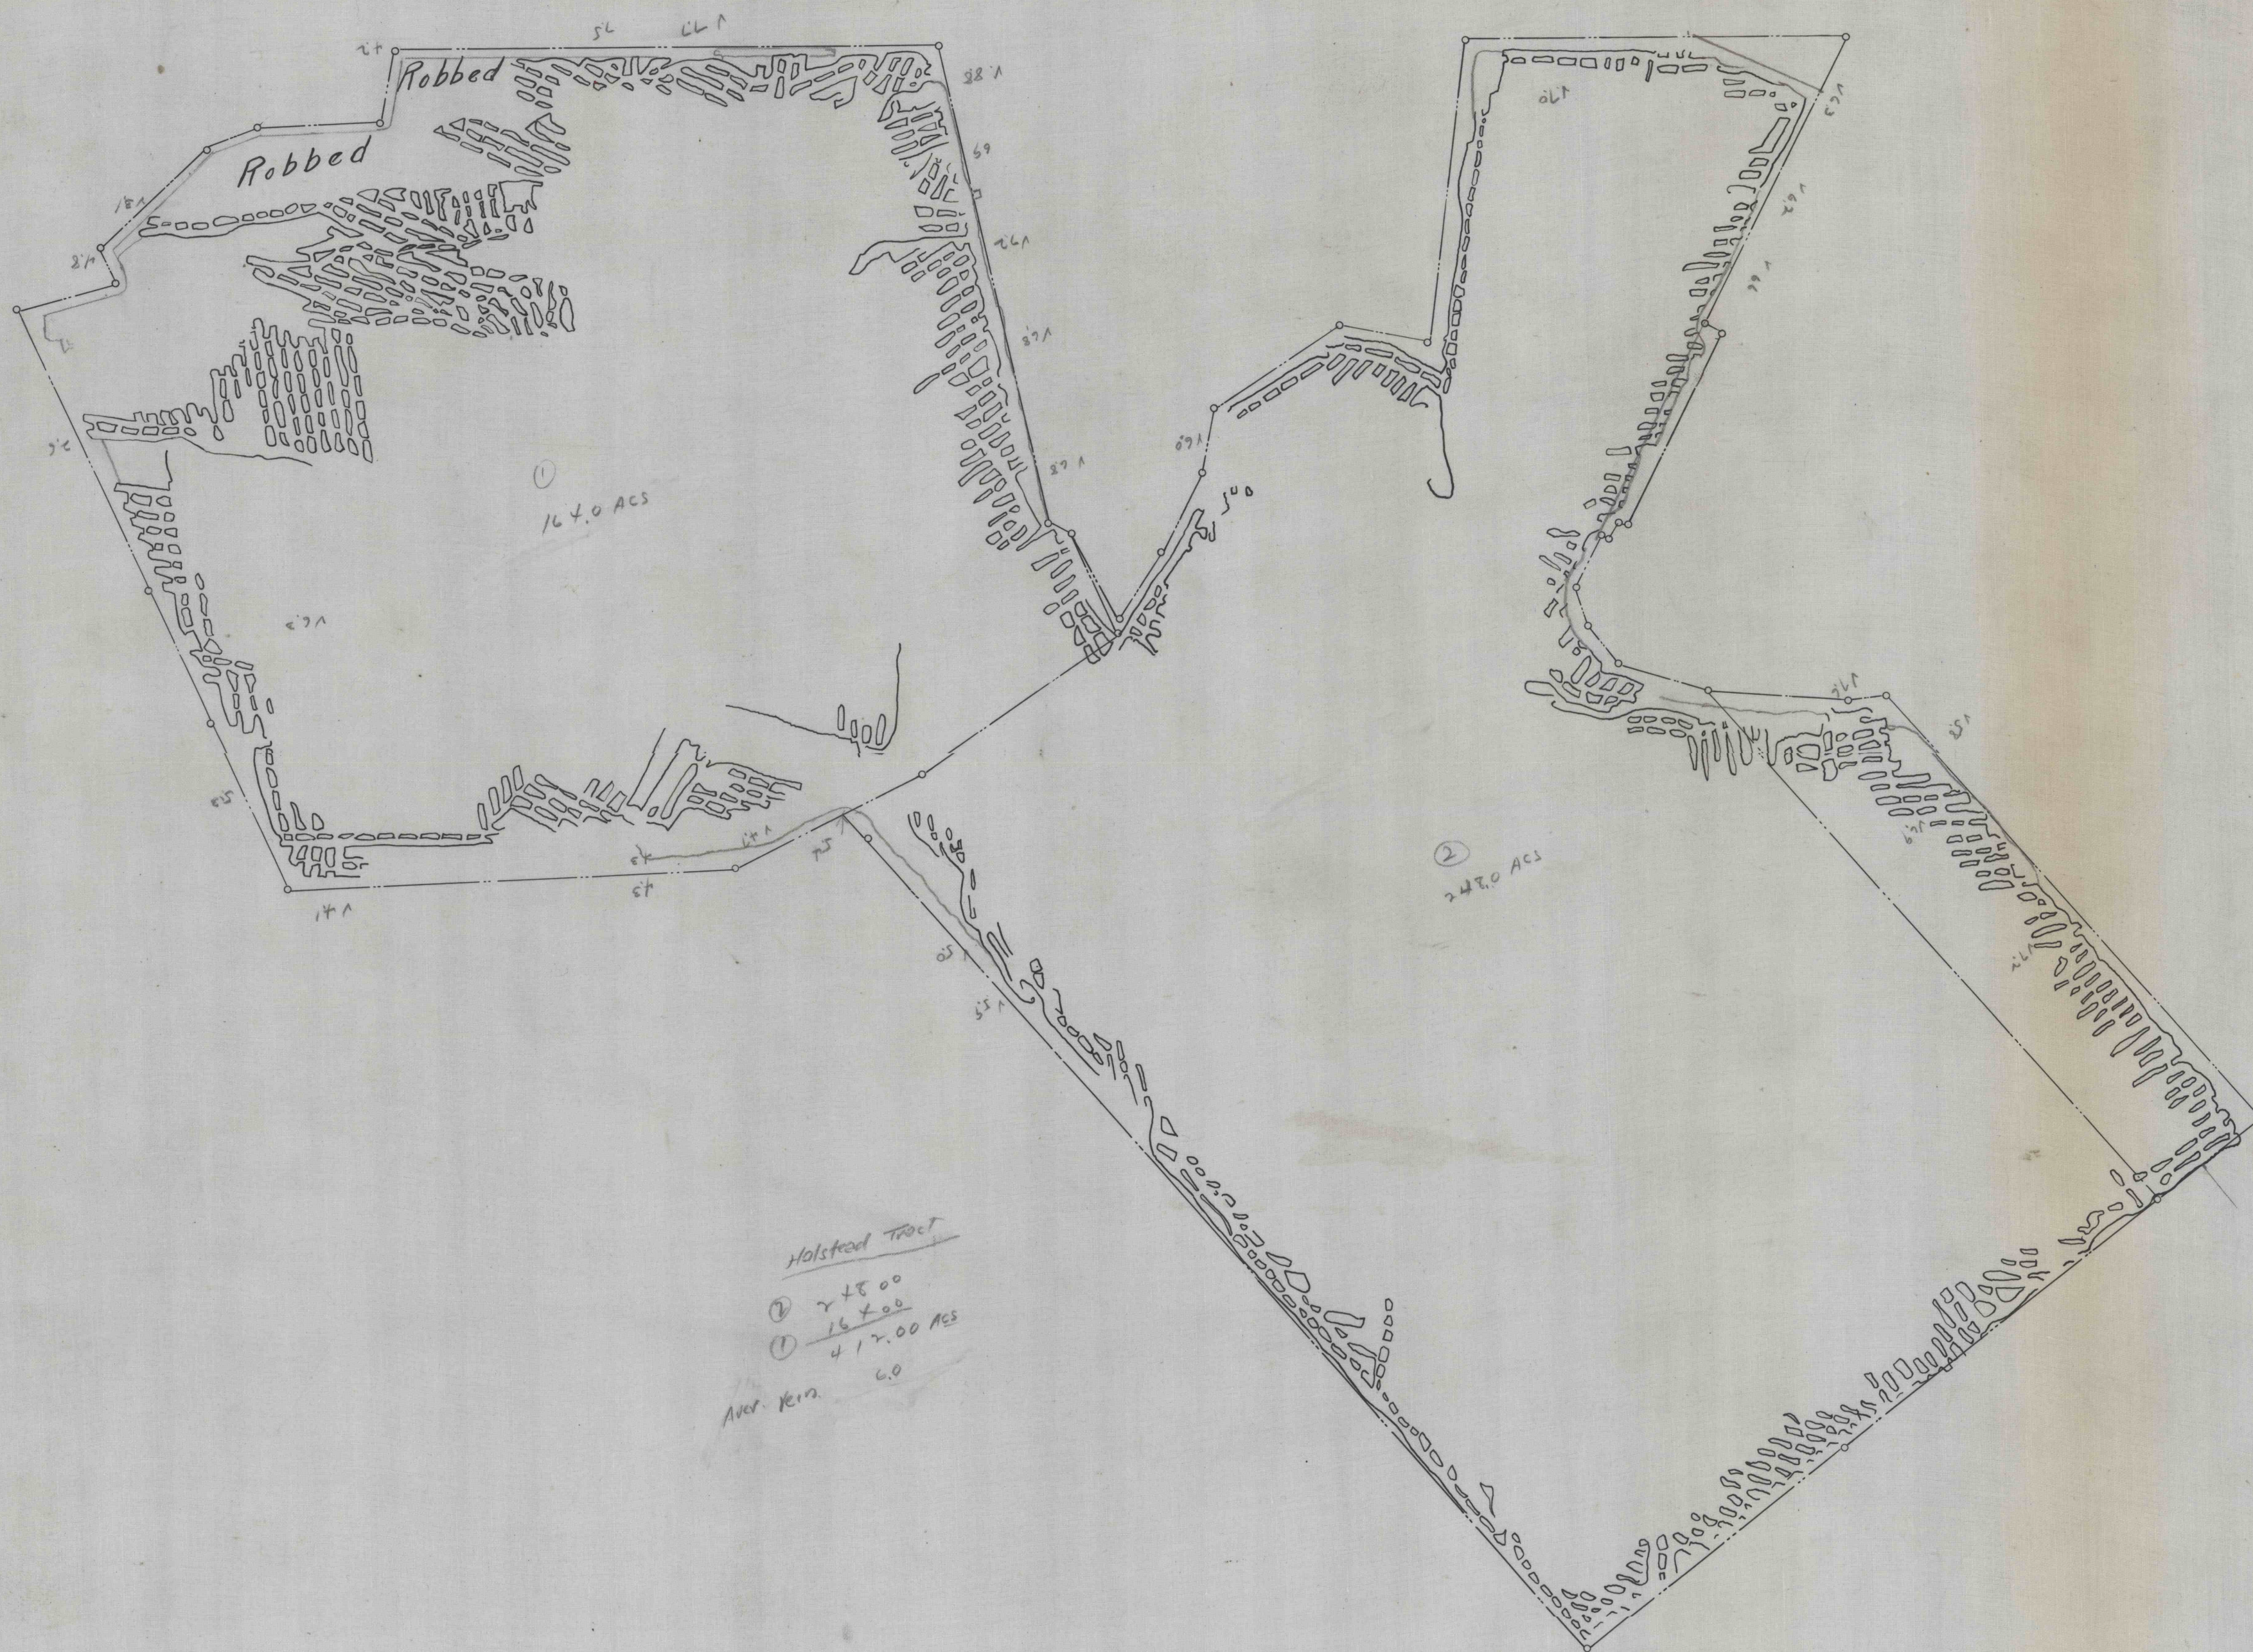

Hallstead
Middle Red Ash

2-1060