


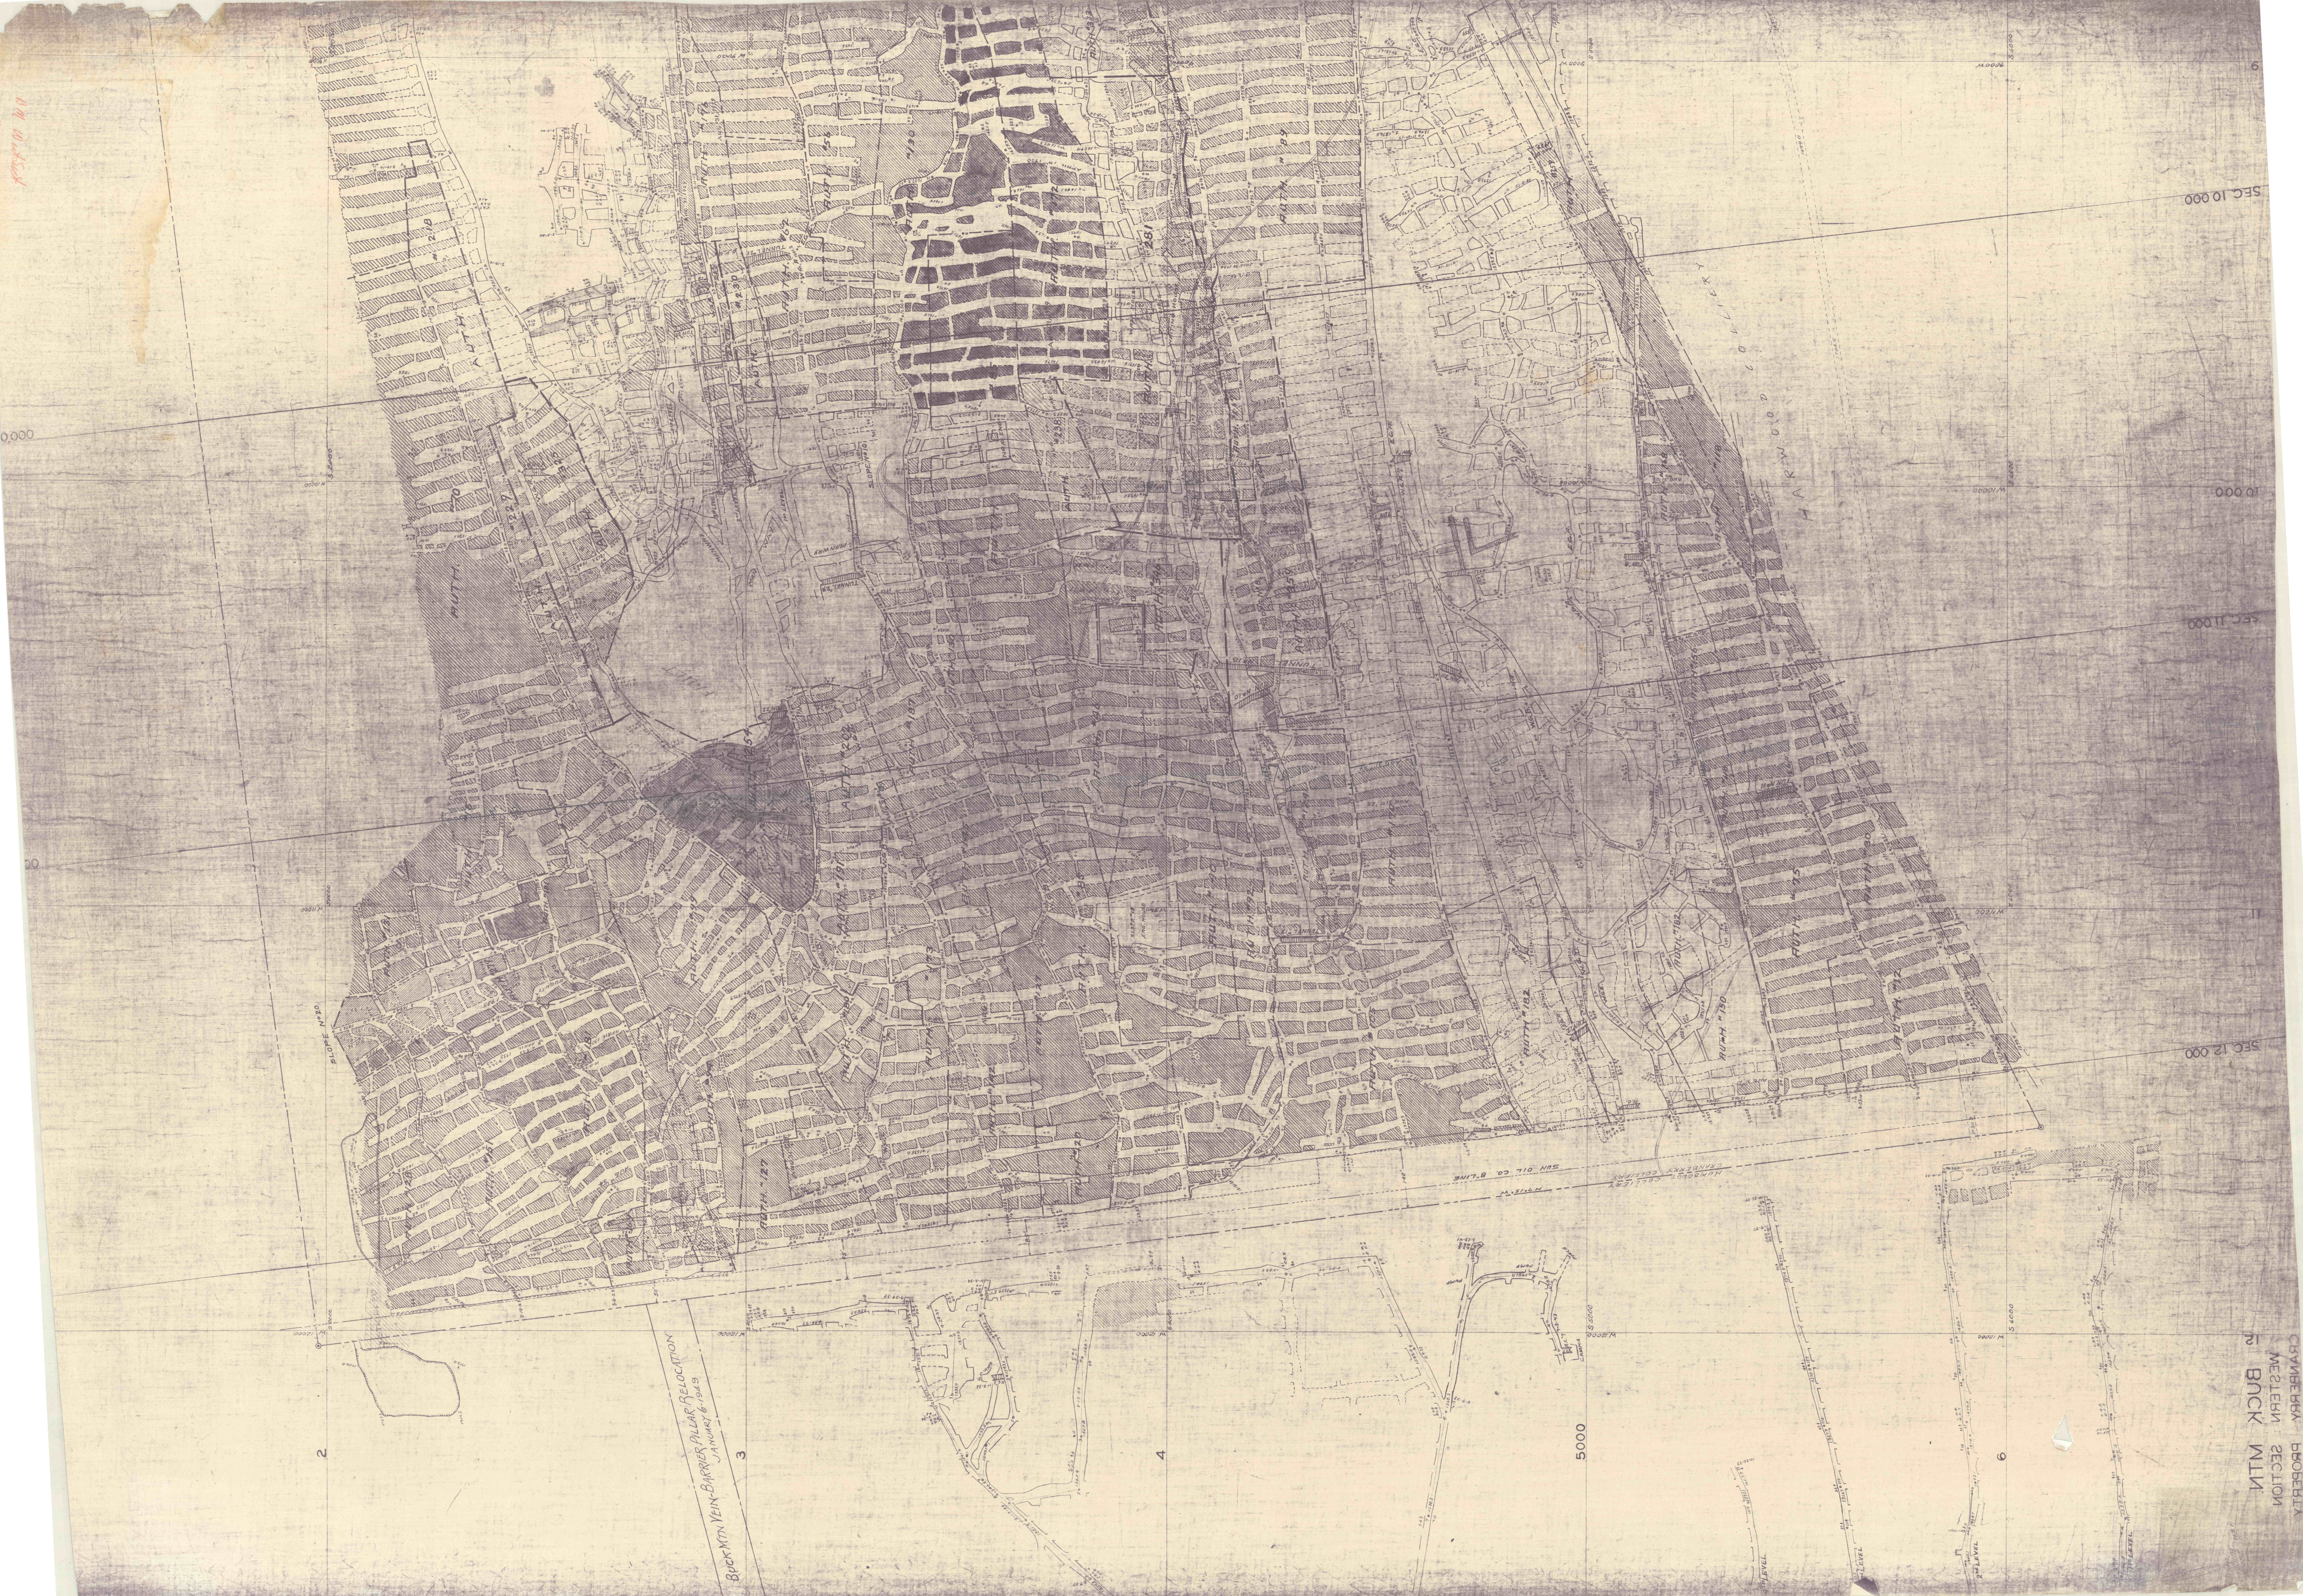

CRANBURY PROPERTY
WESTERN SECTION
BUCK MTN.

BUCK MTN. VEIN-BARRIER PILLAR RELOCATION
JANUARY 6-1929

2

3

4

5000

9

SEC. 10 000

SEC. 11 000

SEC. 12 000

SEC. 13 000