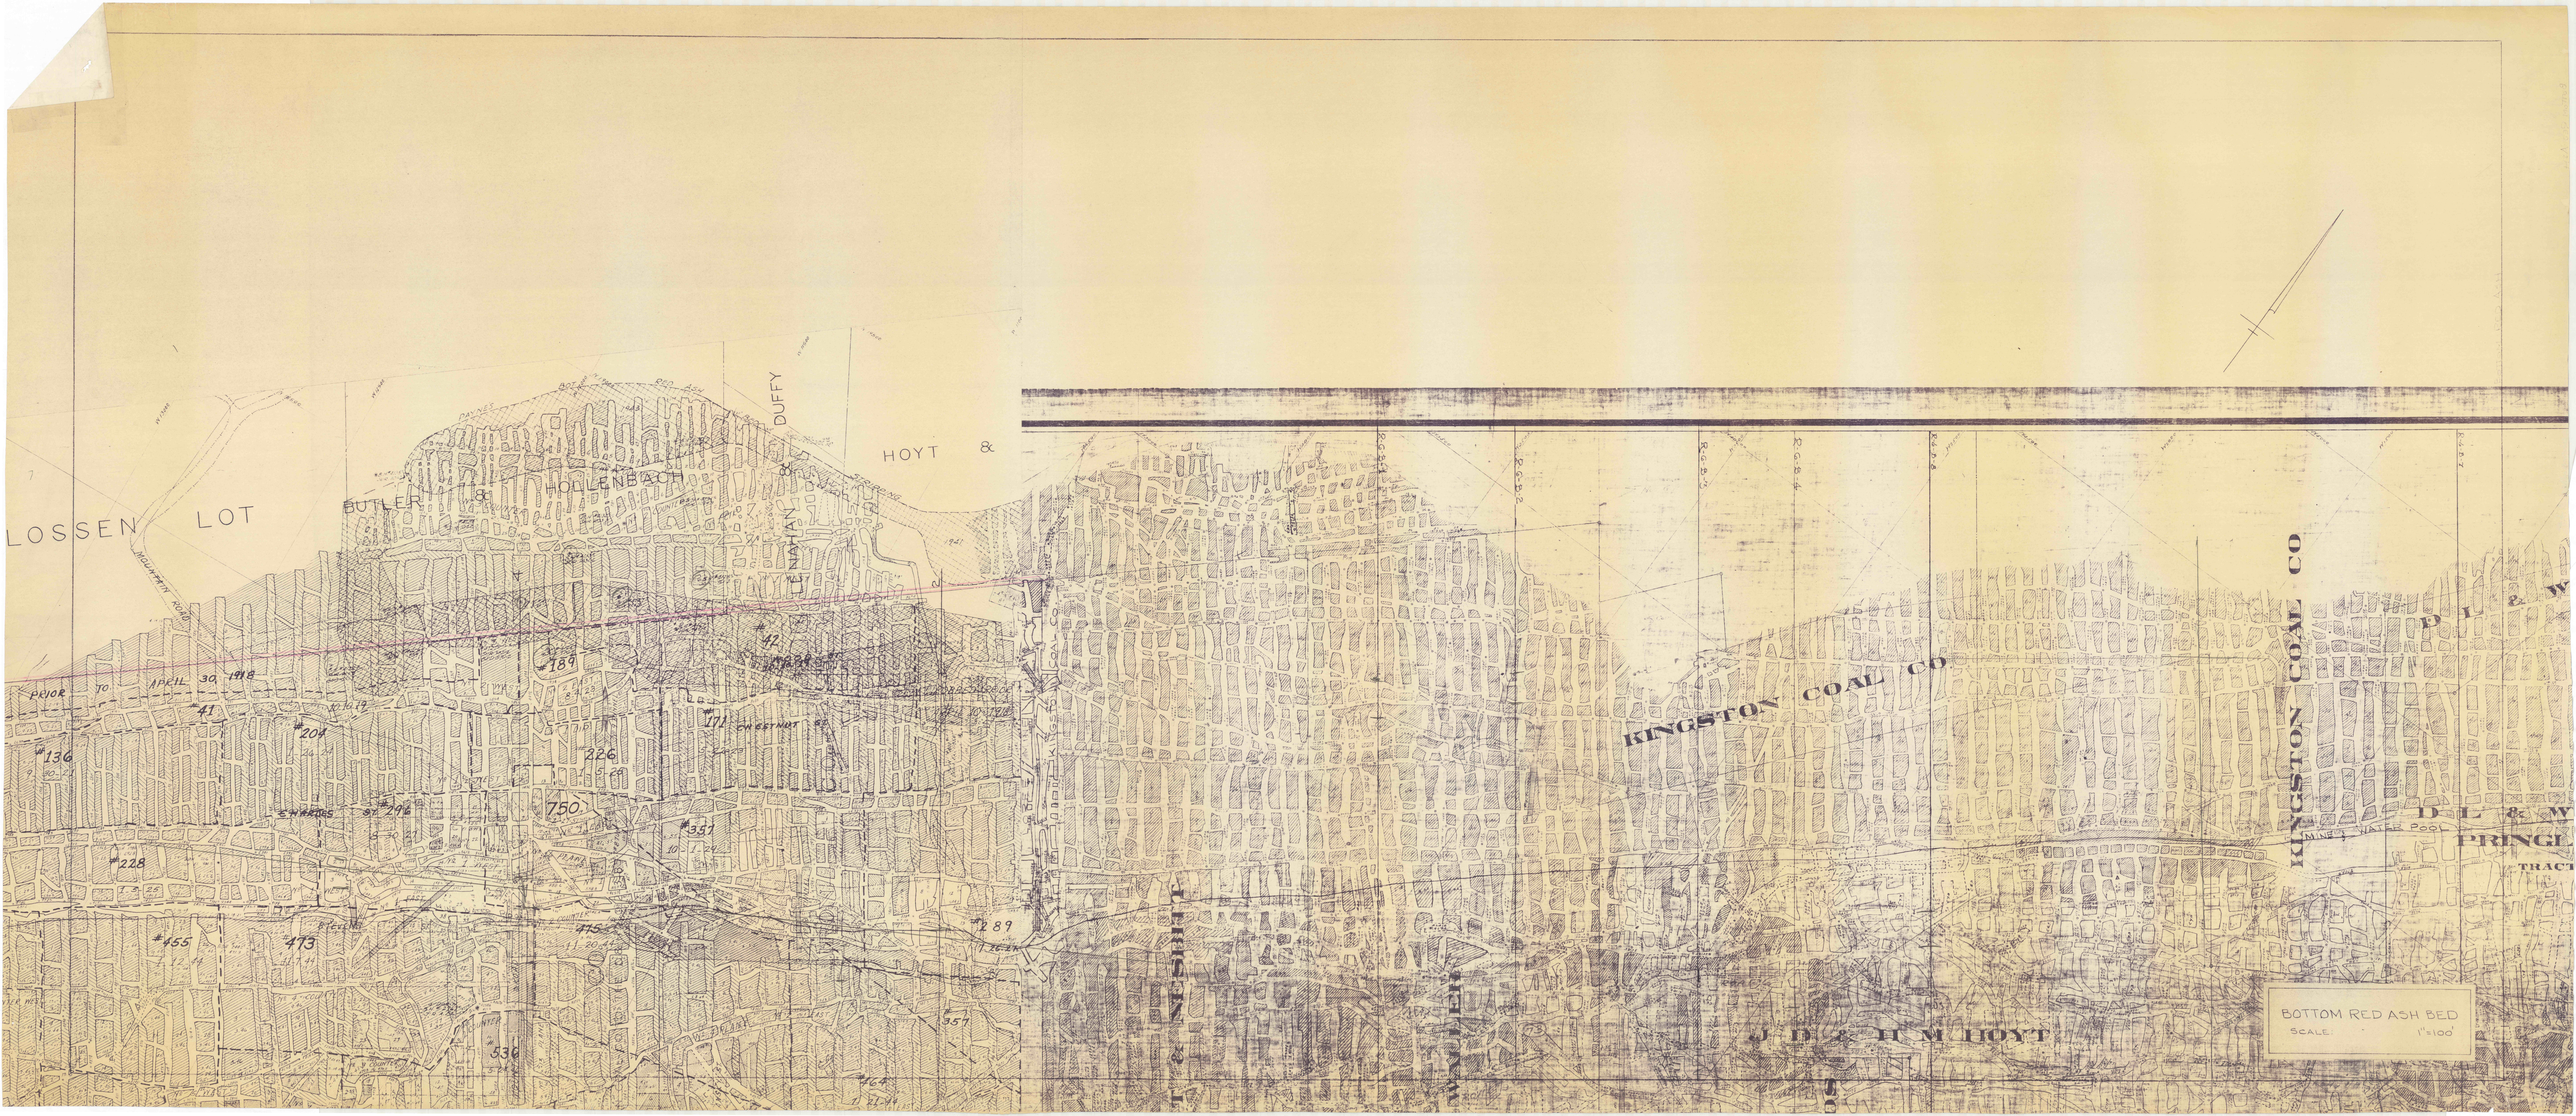

LOSSEN LOT
BUTLER & HOLLENBACH
DUFFY & NAHAN
HOYT &
PRIOR TO APRIL 30 1918
KINGSTON COAL CO
KINGSTON COAL CO
D L & W
PRINGL
TRACT
MINE 3 WATER POOL
J D & H M HOYT
BOTTOM RED ASH BED
SCALE 1"=100'
#136
#204
#189
#42
#41
#226
#171
#750
#351
#228
#455
#473
#289
#357
#530