WORKED BY GLENDOWER

——— WORKED MAR. 1913.

- - - - - WORKED 1913 TO MAR. 1920

— SCALE 1"=300' —

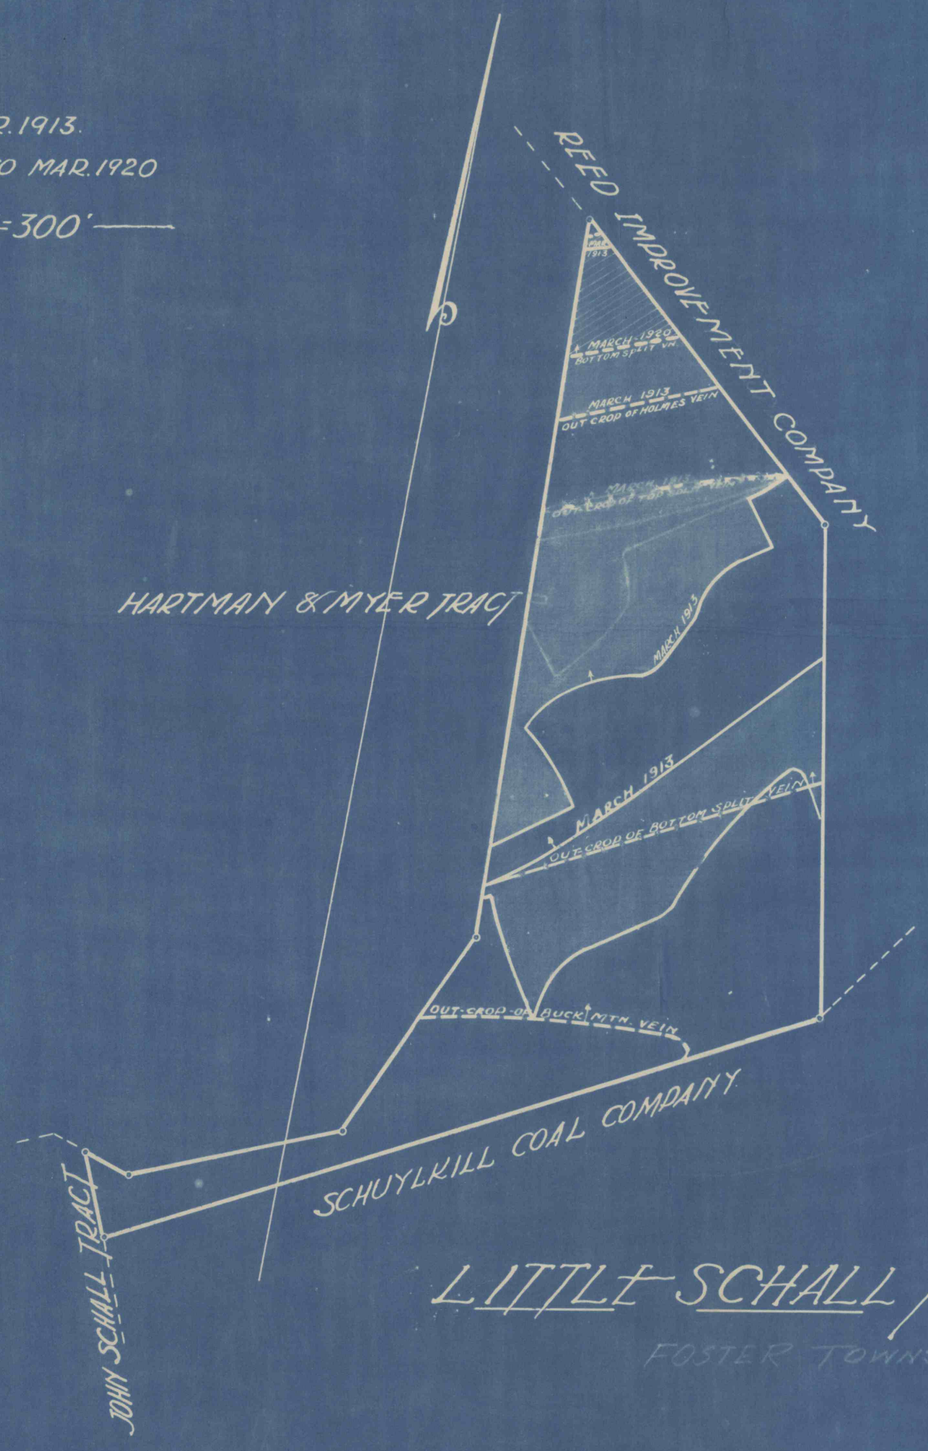

Office Record

LITTLE SCHALL TRACT

FOSTER TOWNSHIP