

WORKED BY  
PINE KNUTS

GETTLE & WAGNER TRACT

HOLMES VN  
MARCH 1920

LEONARD REED TRACT


— WORKED MAR. 1913  
--- WORKED 1913 TO MAR. 1920

SCALE 1"=100'

CASS } TOWNSHIPS  
NEW CASTLE }

GETTLE & WAGNER TRACT

GETTLE & WAGNER TRACT

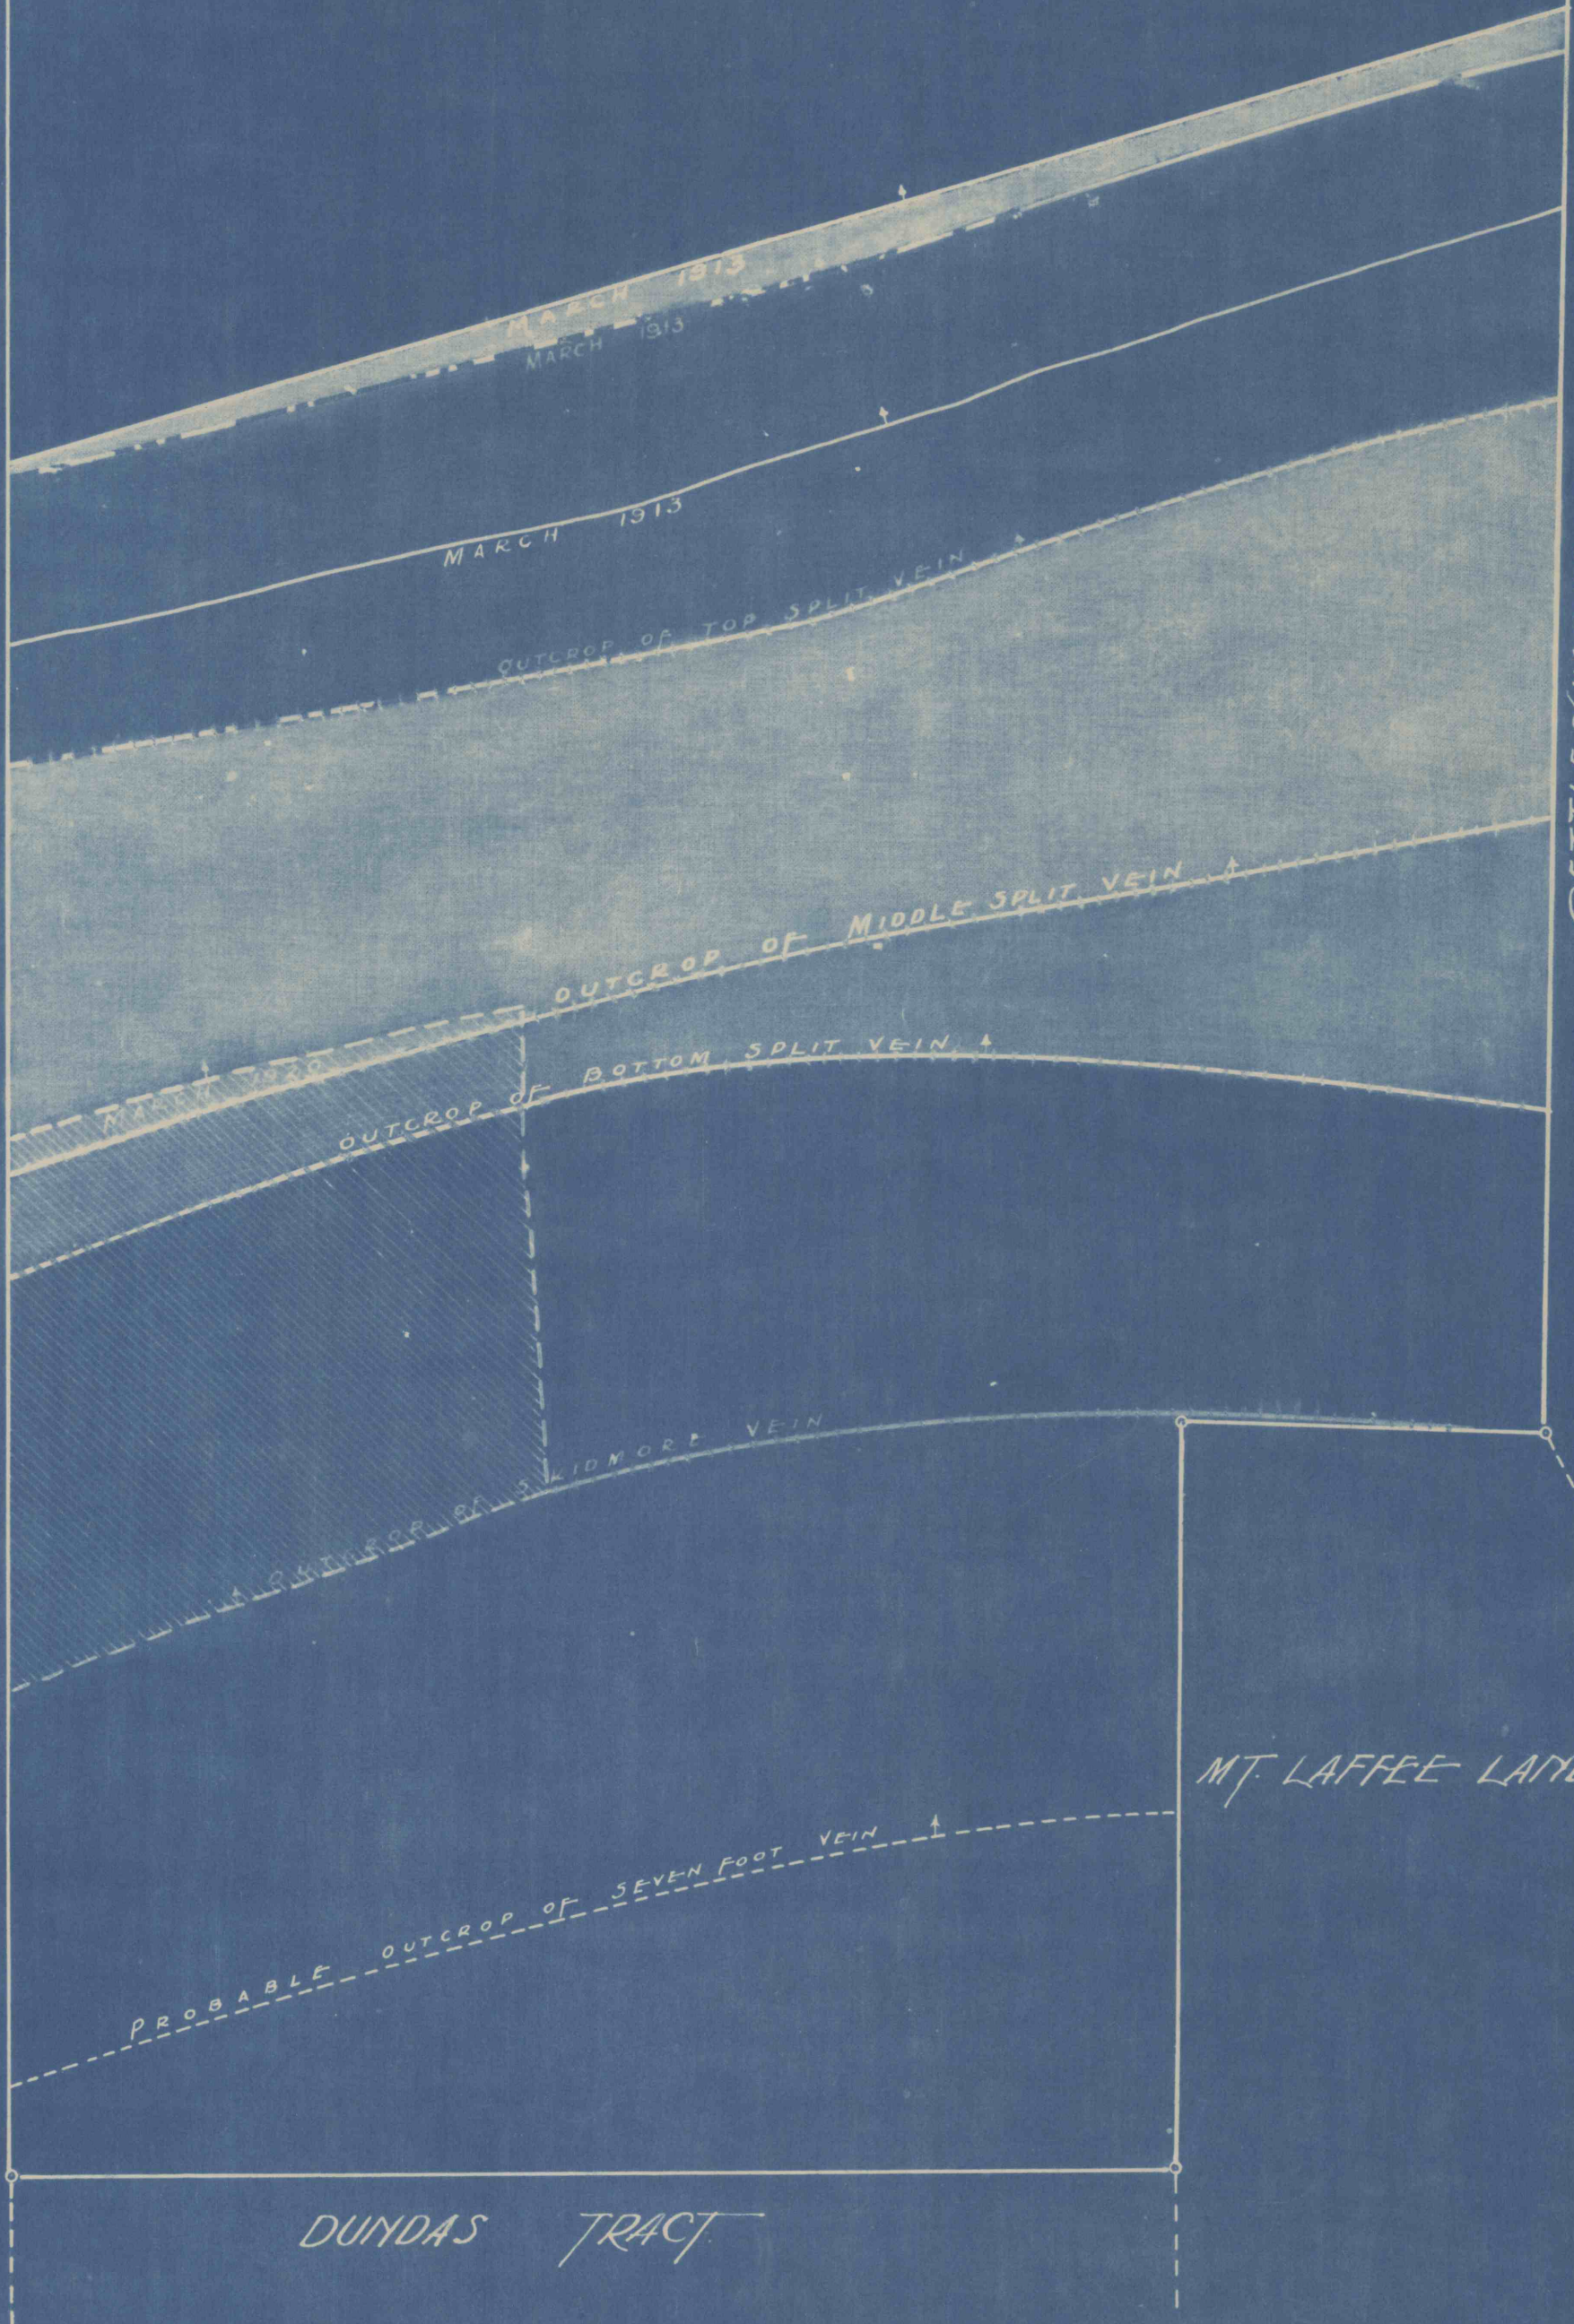

