WORKED BY
OAK HILL

Office
Surv

—— WORKED MAR. 1913
— — — WORKED 1913 TO MAR. 1920
SCALE 1" = 300'
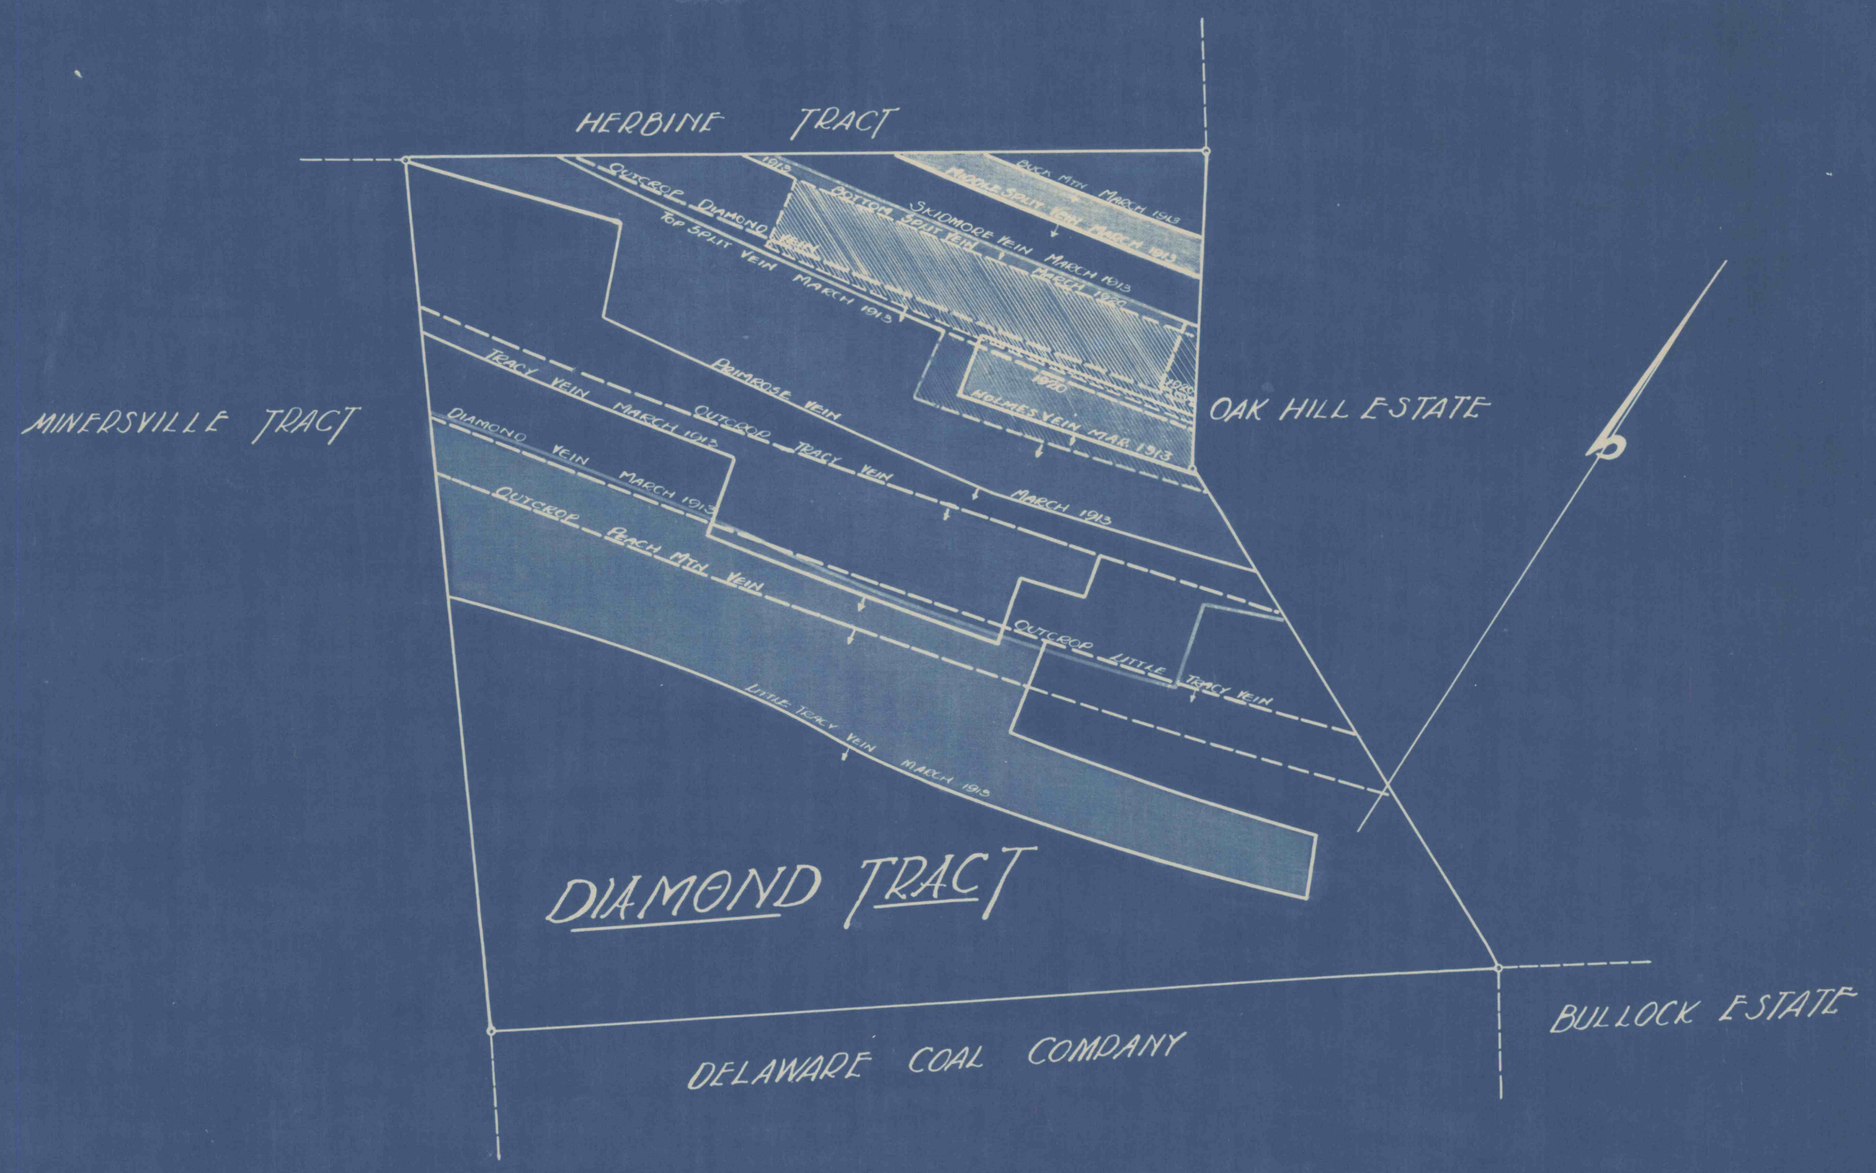
CASS TOWNSHIP