


WORKED MAR. 1913
WORKED 1913 TO MAR. 1920

SCALE 1" 800'

REILLY TOWNSHIP

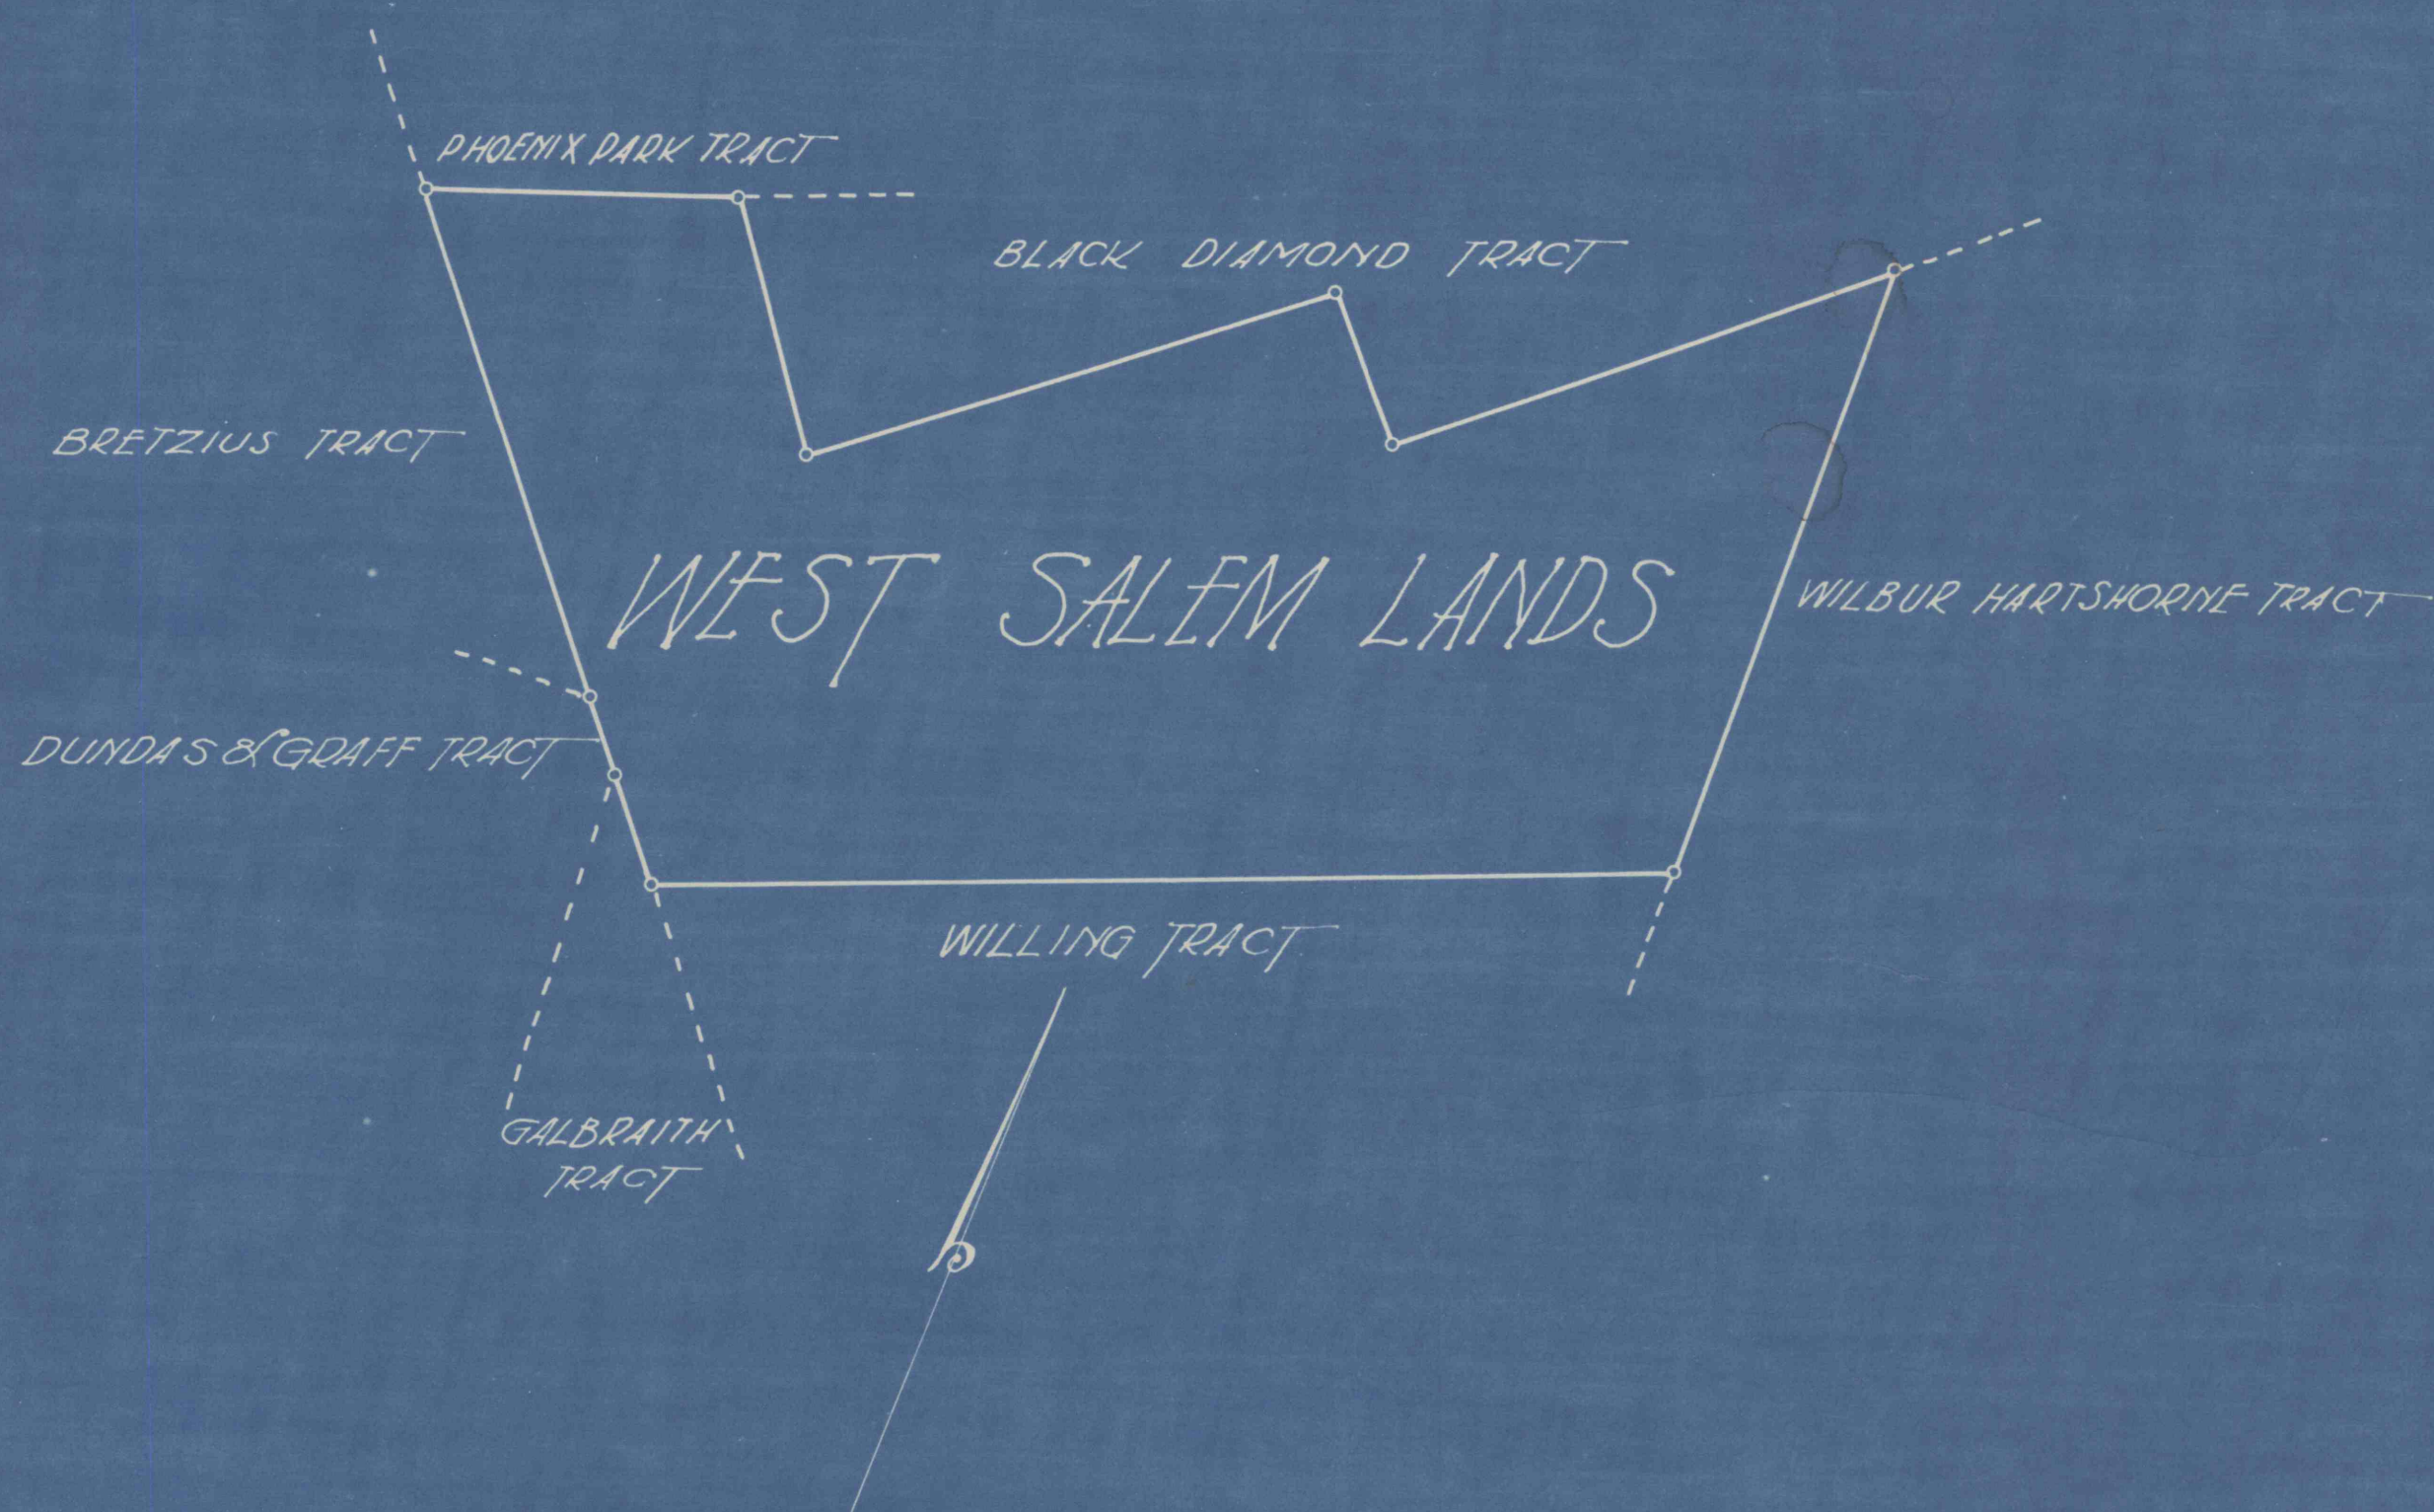

Office Copy