


Glendower Holmes

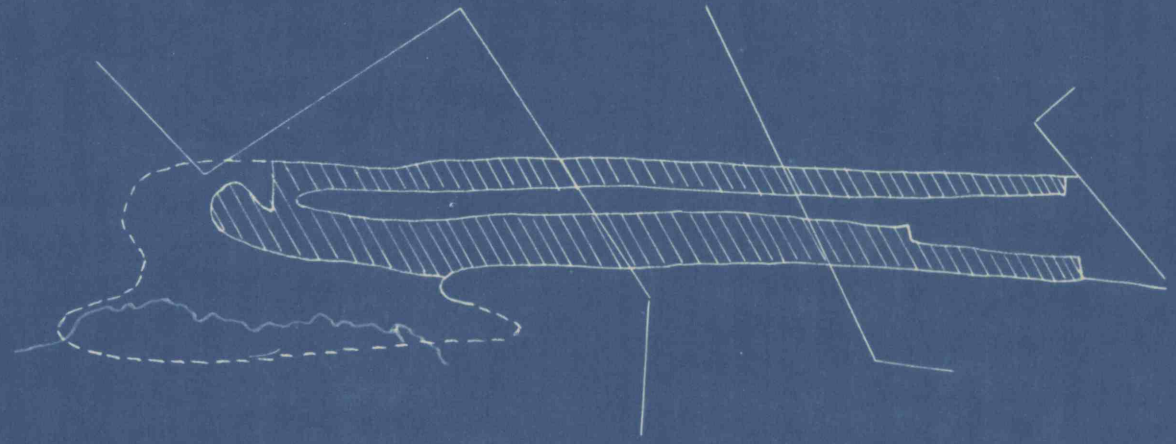

GLENDOWER - HOLMES