


WORKED BY:
PHOENIX PART

— WORKED MARCH 1913
- - - WORKED 1913 TO MARCH 1920
SCALE 1" = 500'

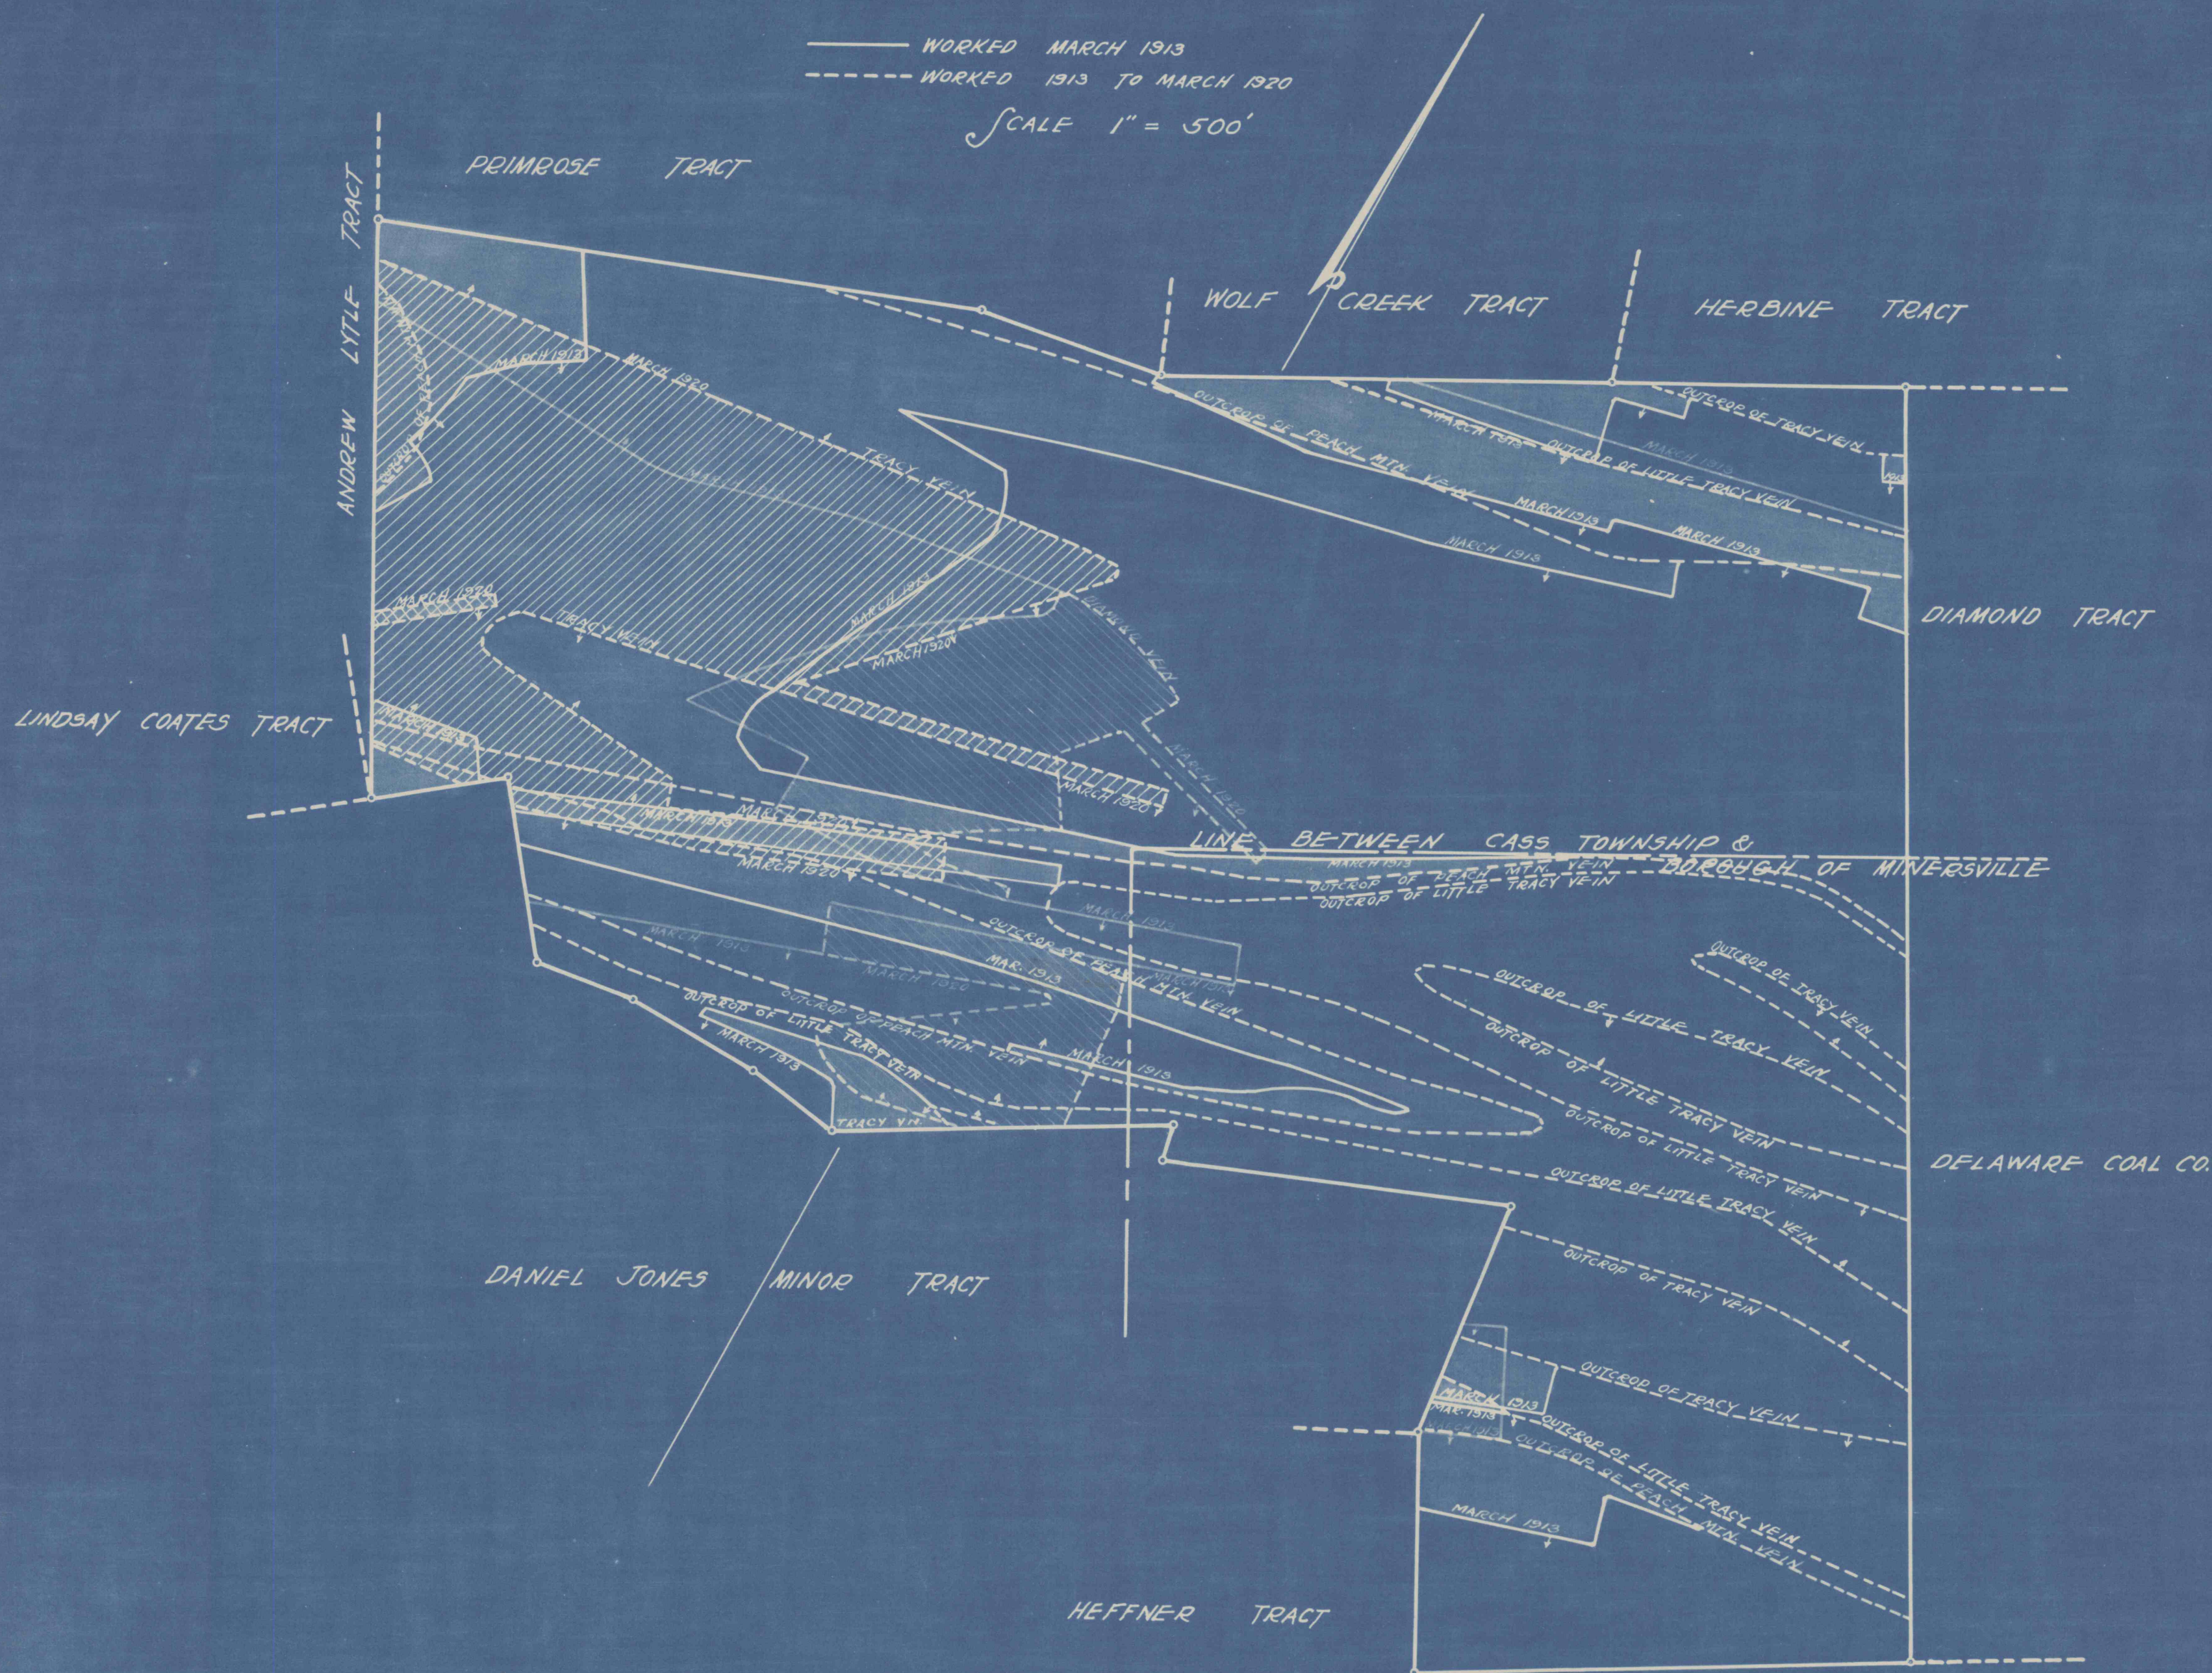

MINERSVILLE TRACT

CASS TOWNSHIP
BOROUGH OF MINERSVILLE

Office copy