


WORKED BY

— WORKED MAR. 1913
- - - WORKED 1913 TO MAR. 1920.
SCALE 1" = 800'

EAST SALEM LANDS

BRANCH TOWNSHIP

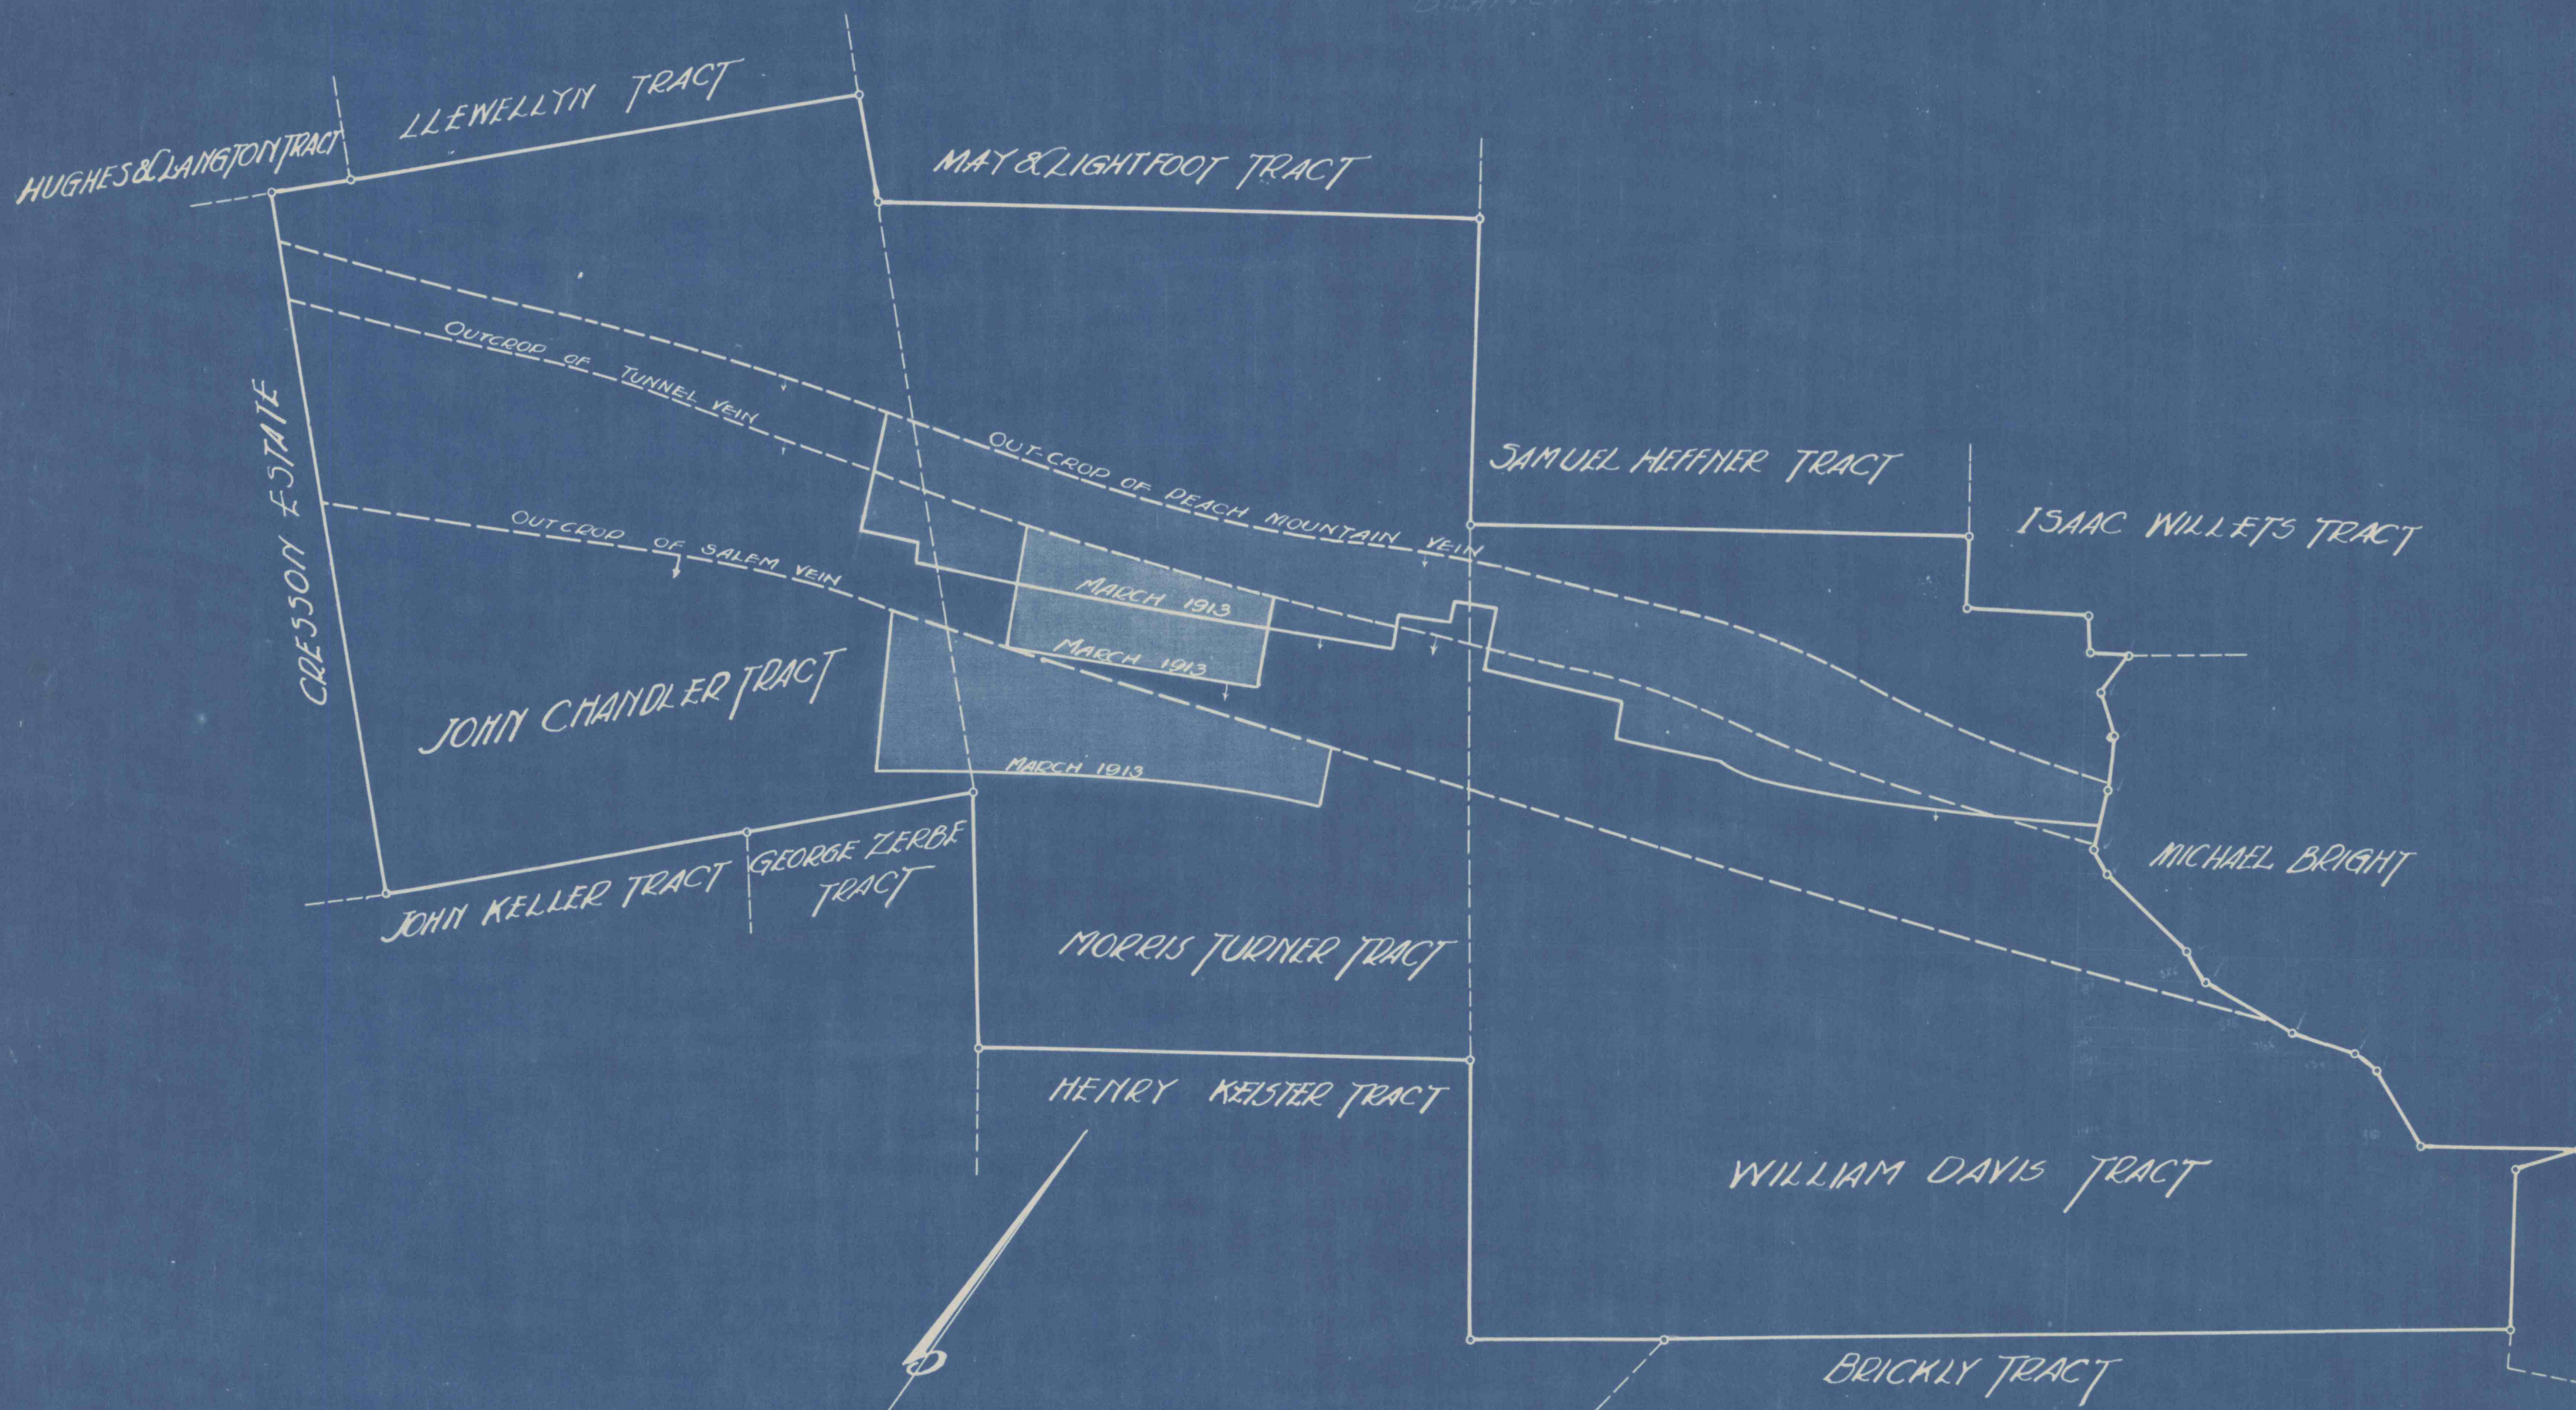

Office Copy