
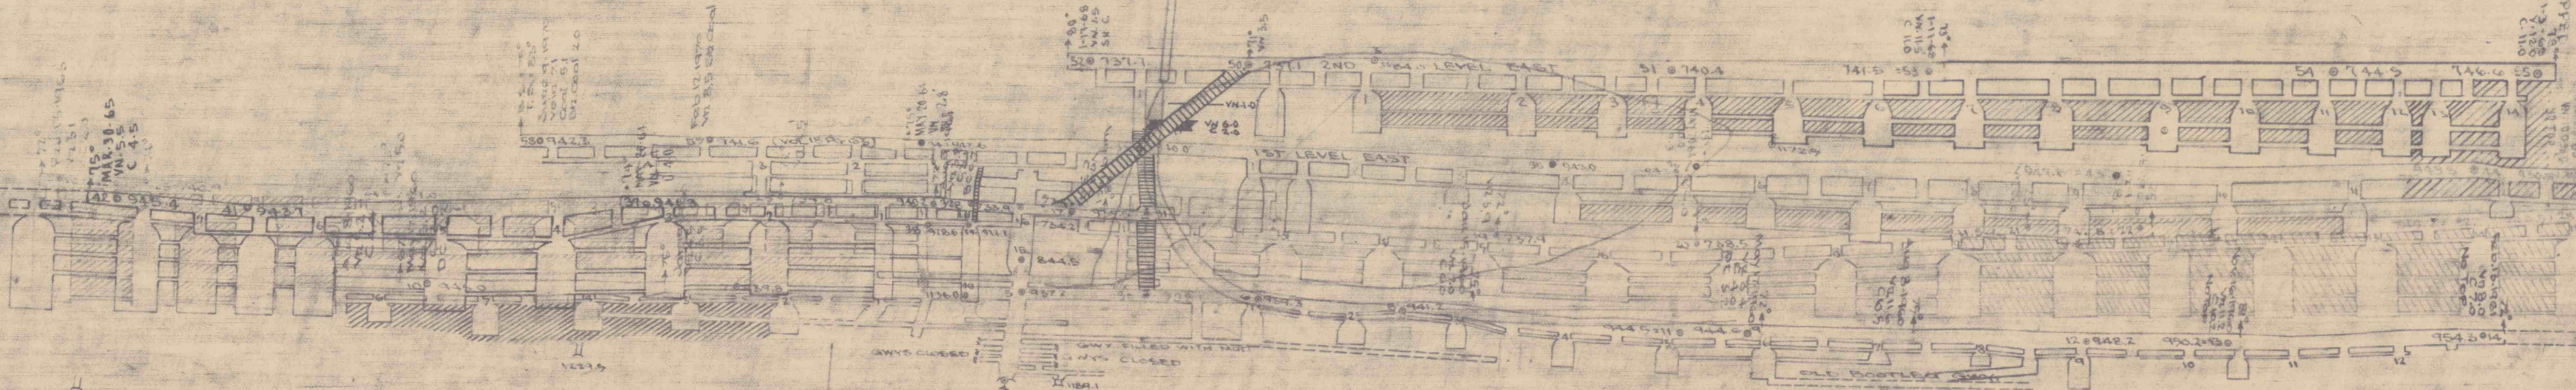


G E O R G E D E W A L T T R A C T

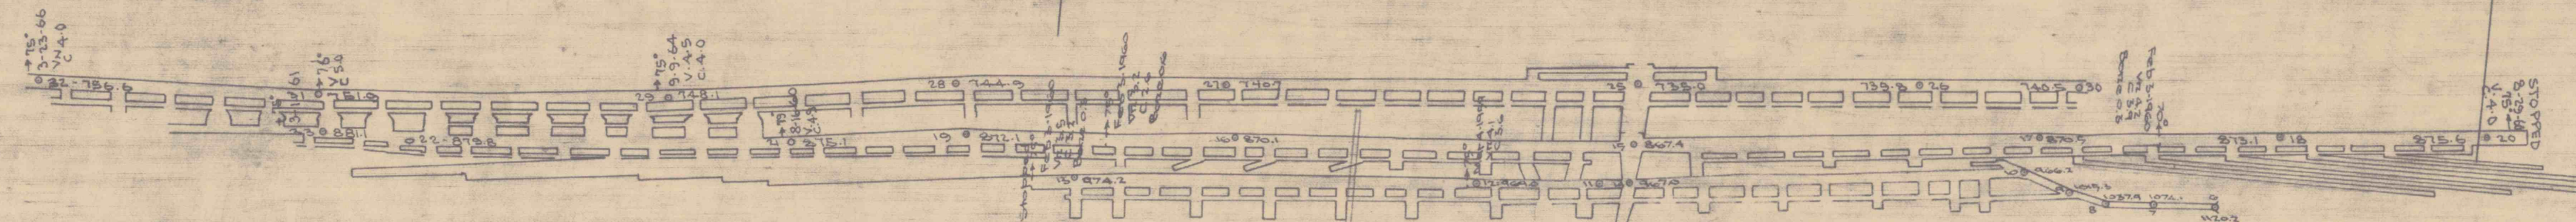

Showing the location and extent of development of the J. and C. Coal Company mine slope situated on the north dip of the Middle Split and Top Split Veins, Hegins Twp., Schuylkill County, Pennsylvania.  
A. B. Riedel, P.E. June 9, 1970  
Scale 1"=100'