


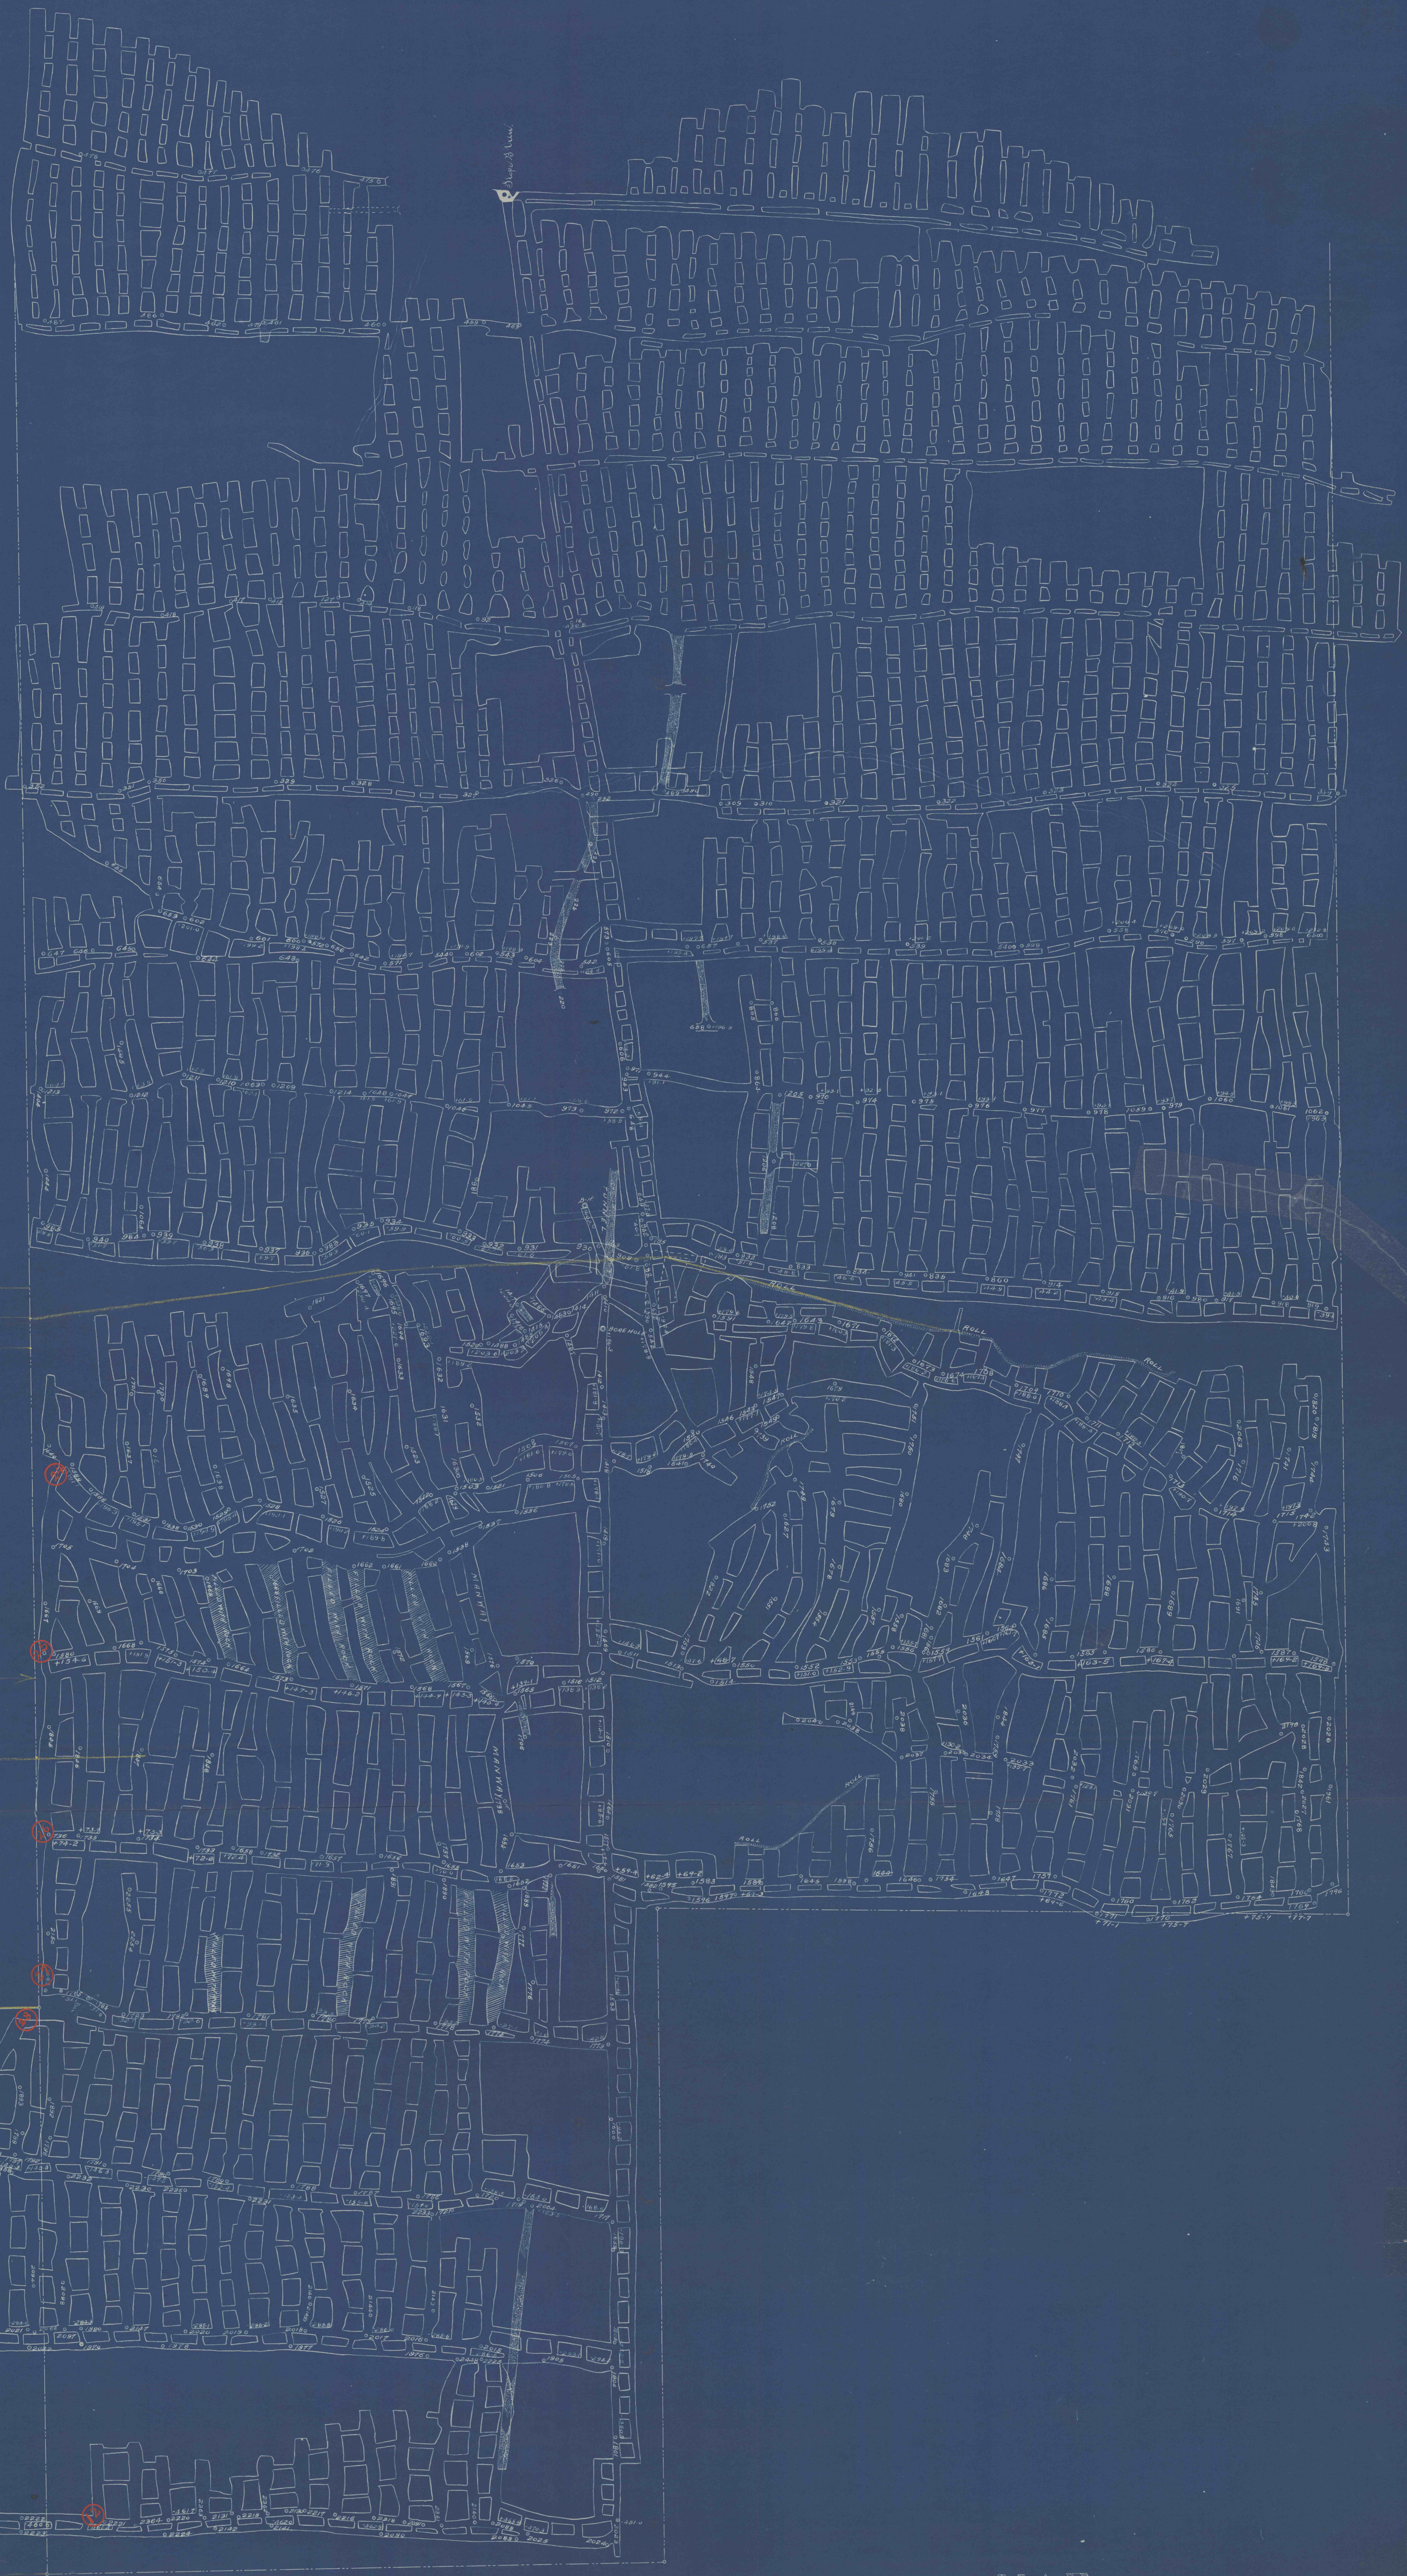

Back Basin

Axis of fault

D.L. & W.

601.0

Barrier Pit

Plumb Lease

MAP
of
B-VEIN
WARRIOR RUN M. CO.

H.S. REETS, ENGR.

SCALE 100 FT. = 1 INCH

POSTED	FEBRUARY	1888
	MAY	1889
	MAY	1890
	NOVEMBER	1891
	MAY	1892
	NOVEMBER	1893
	MAY	1894
	OCTOBER	1895
	JANUARY	1896
	AUGUST	1897
	FEBRUARY	1898
	NOVEMBER	1899
	JUNE	1900
	OCTOBER	1901
	MAY	1902
	NOVEMBER	1903
	MARCH	1904
	OCTOBER	1905