Pittston Vein

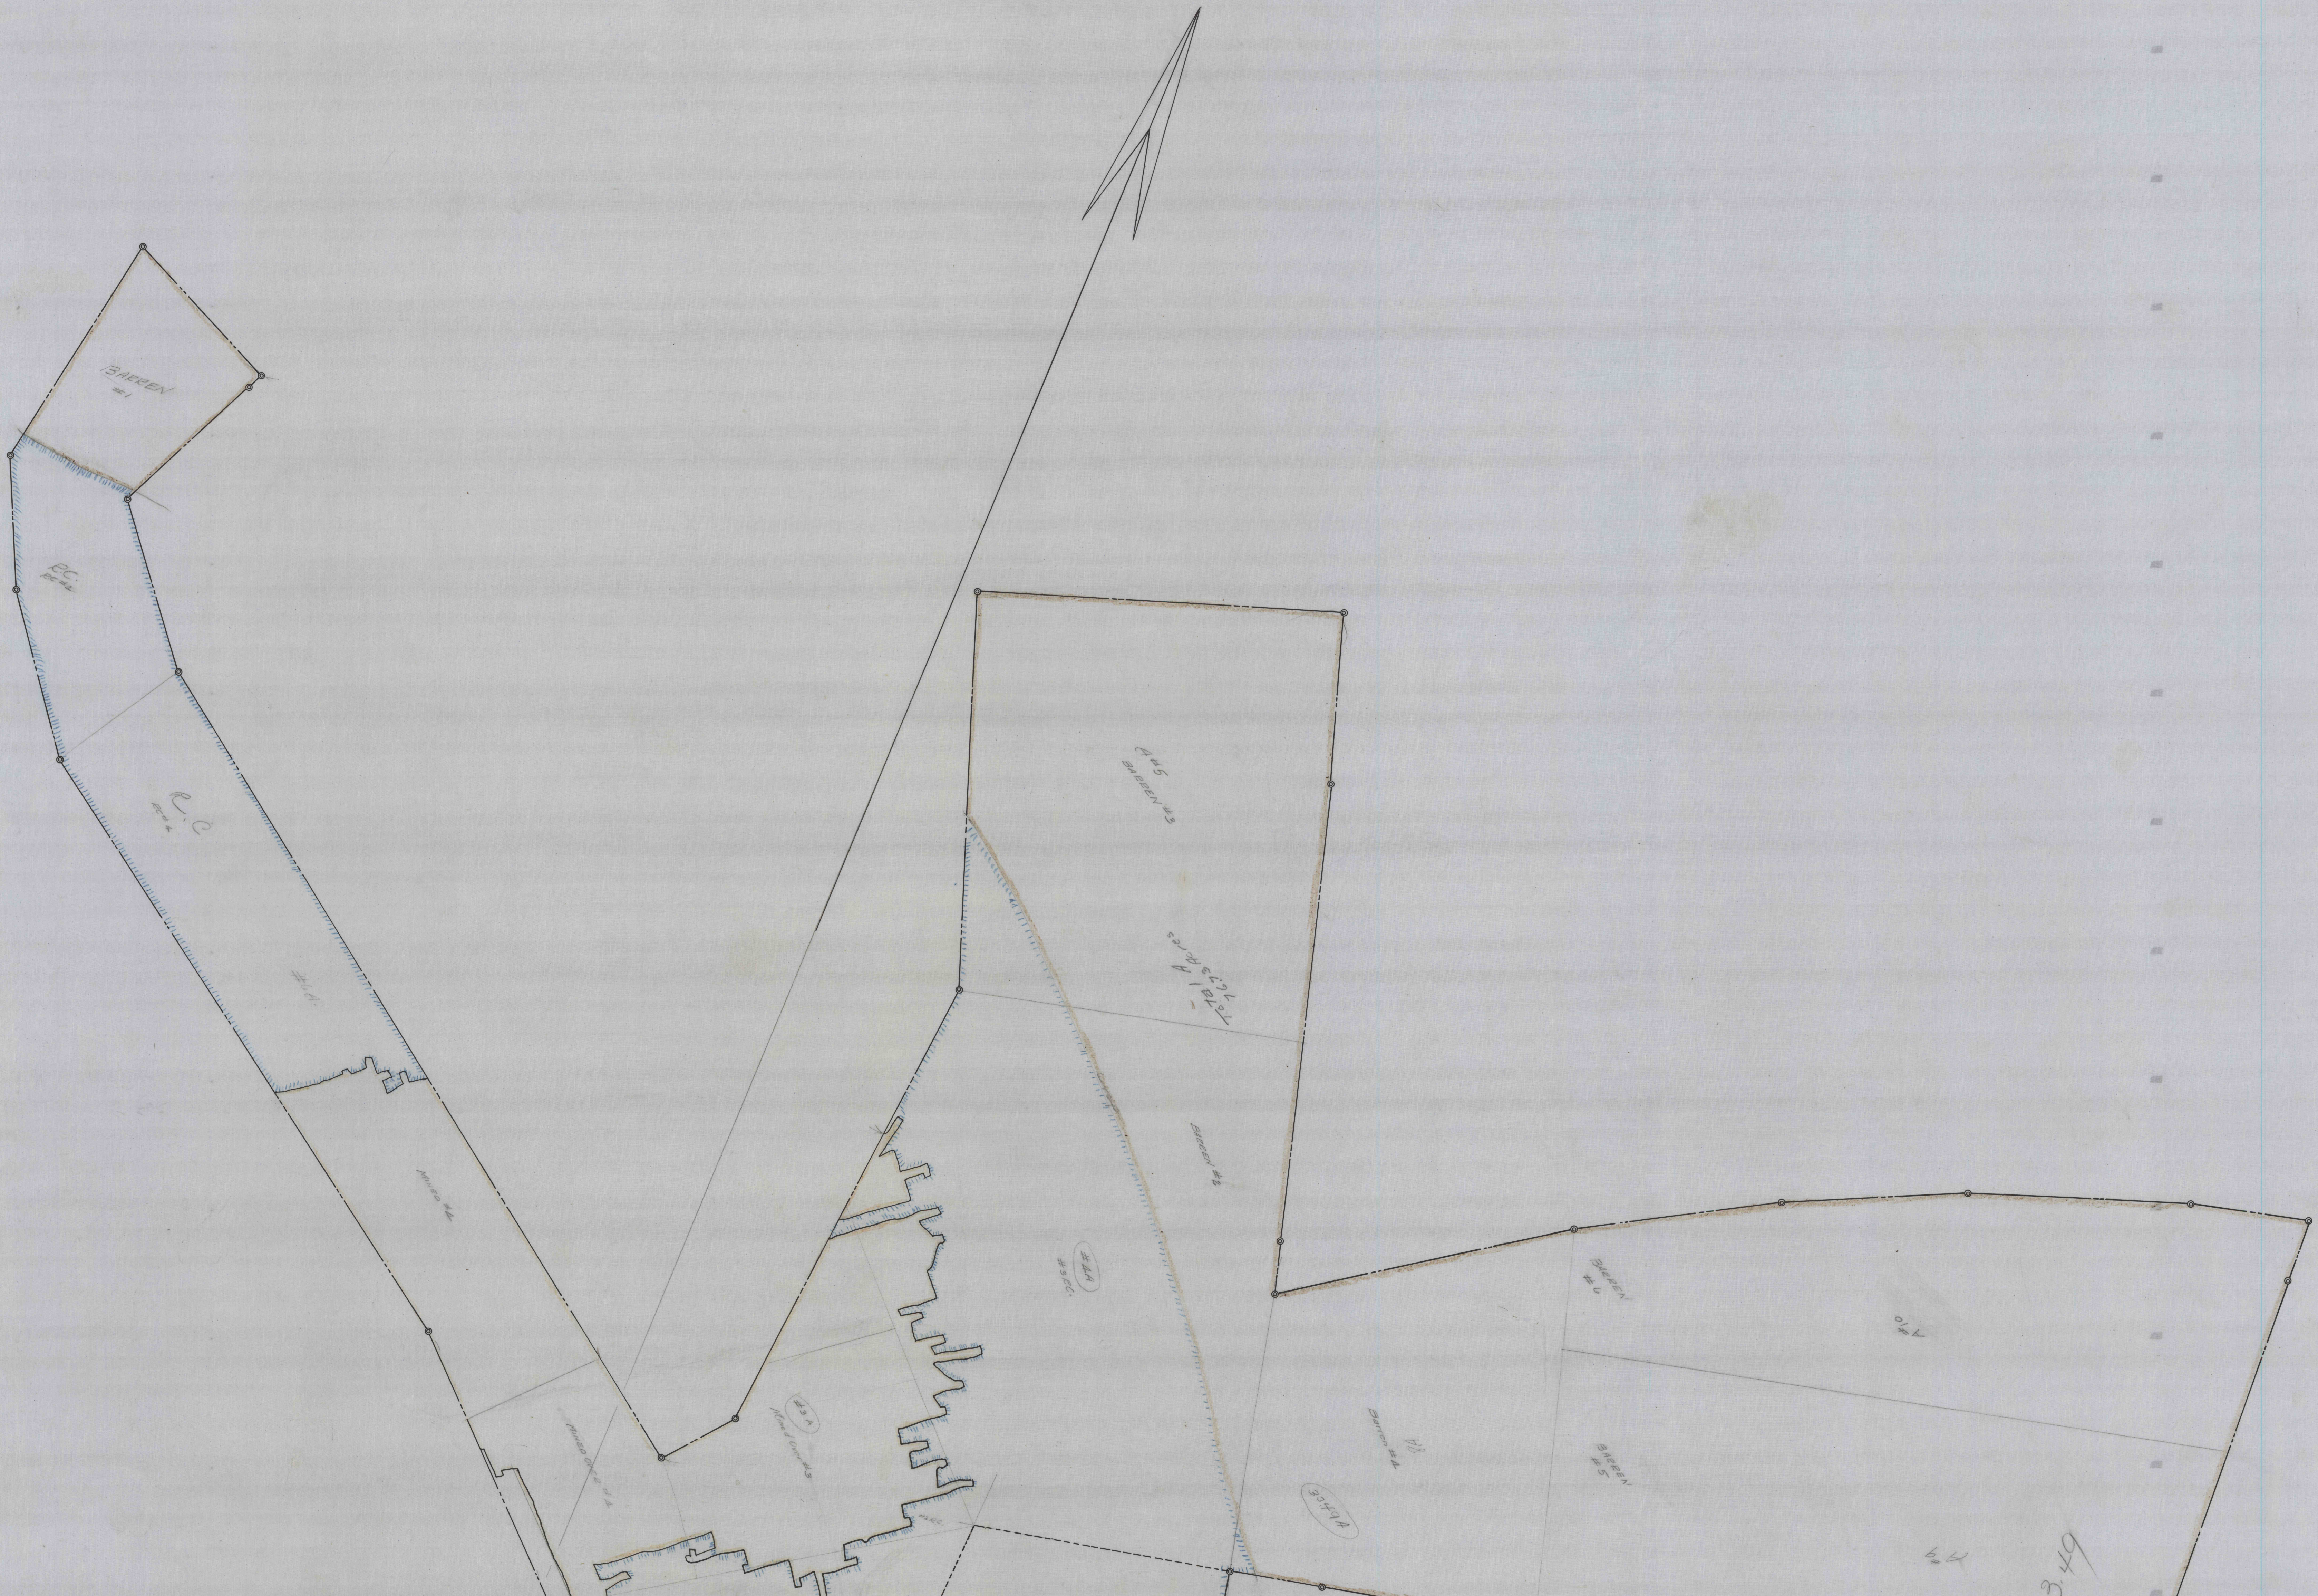
BARREN #1
R.C. RC#4
R.C. RC#4
#6A
MINED #4
MINED OVER #4
A#5 BARREN #3
Total 16.29 Acres
BARREN #2
#4A #3 R.C.
#3A Mined Over #3
#2 R.C.
ROCK COVER
#2 R.C.
MINED OVER (2)
(2)(A)
BARREN #6
A#10
Barren #4
#8
#4 A 34.49
BARREN #5
A#9
33.49
PRICE - DININNY DISPUTE (11.64 Acs)
BARRIER PILLAR
Fault Put in as R.Cover
RC #5
PRICE - MITCHELL DISPUTE (2.82 Acs)
PRICE - STRONG - BOLIN THOMPSON - DISPUTE (1.24 Acs)
PRICE - FELTS #1 DISPUTE (0.13 Acs)
PRICE - FELTS #2 DISPUTE (0.59 Acs)
R.COVER
ELI K. PRICE (110.22 Acs)
MINED OVER (1)
(1) A.
PRICE - NEWTON - BARNES DISPUTE (4.56 Acs)
R.COVER (1)
(1) RC
Virgin #1

SENECA COLLIERY
TOP PITTSTON VEIN

POSTED TO 12-19-25

LEGEND.—

		SYMBOL	
▭	First Mined	SYMBOL	M-
▨	Rock Cover	"	C-
☒	Faulted	"	F-
▭	Barren	"	B-
▭	Virgin	"	V-

RR-322

PRICE TRACT EST