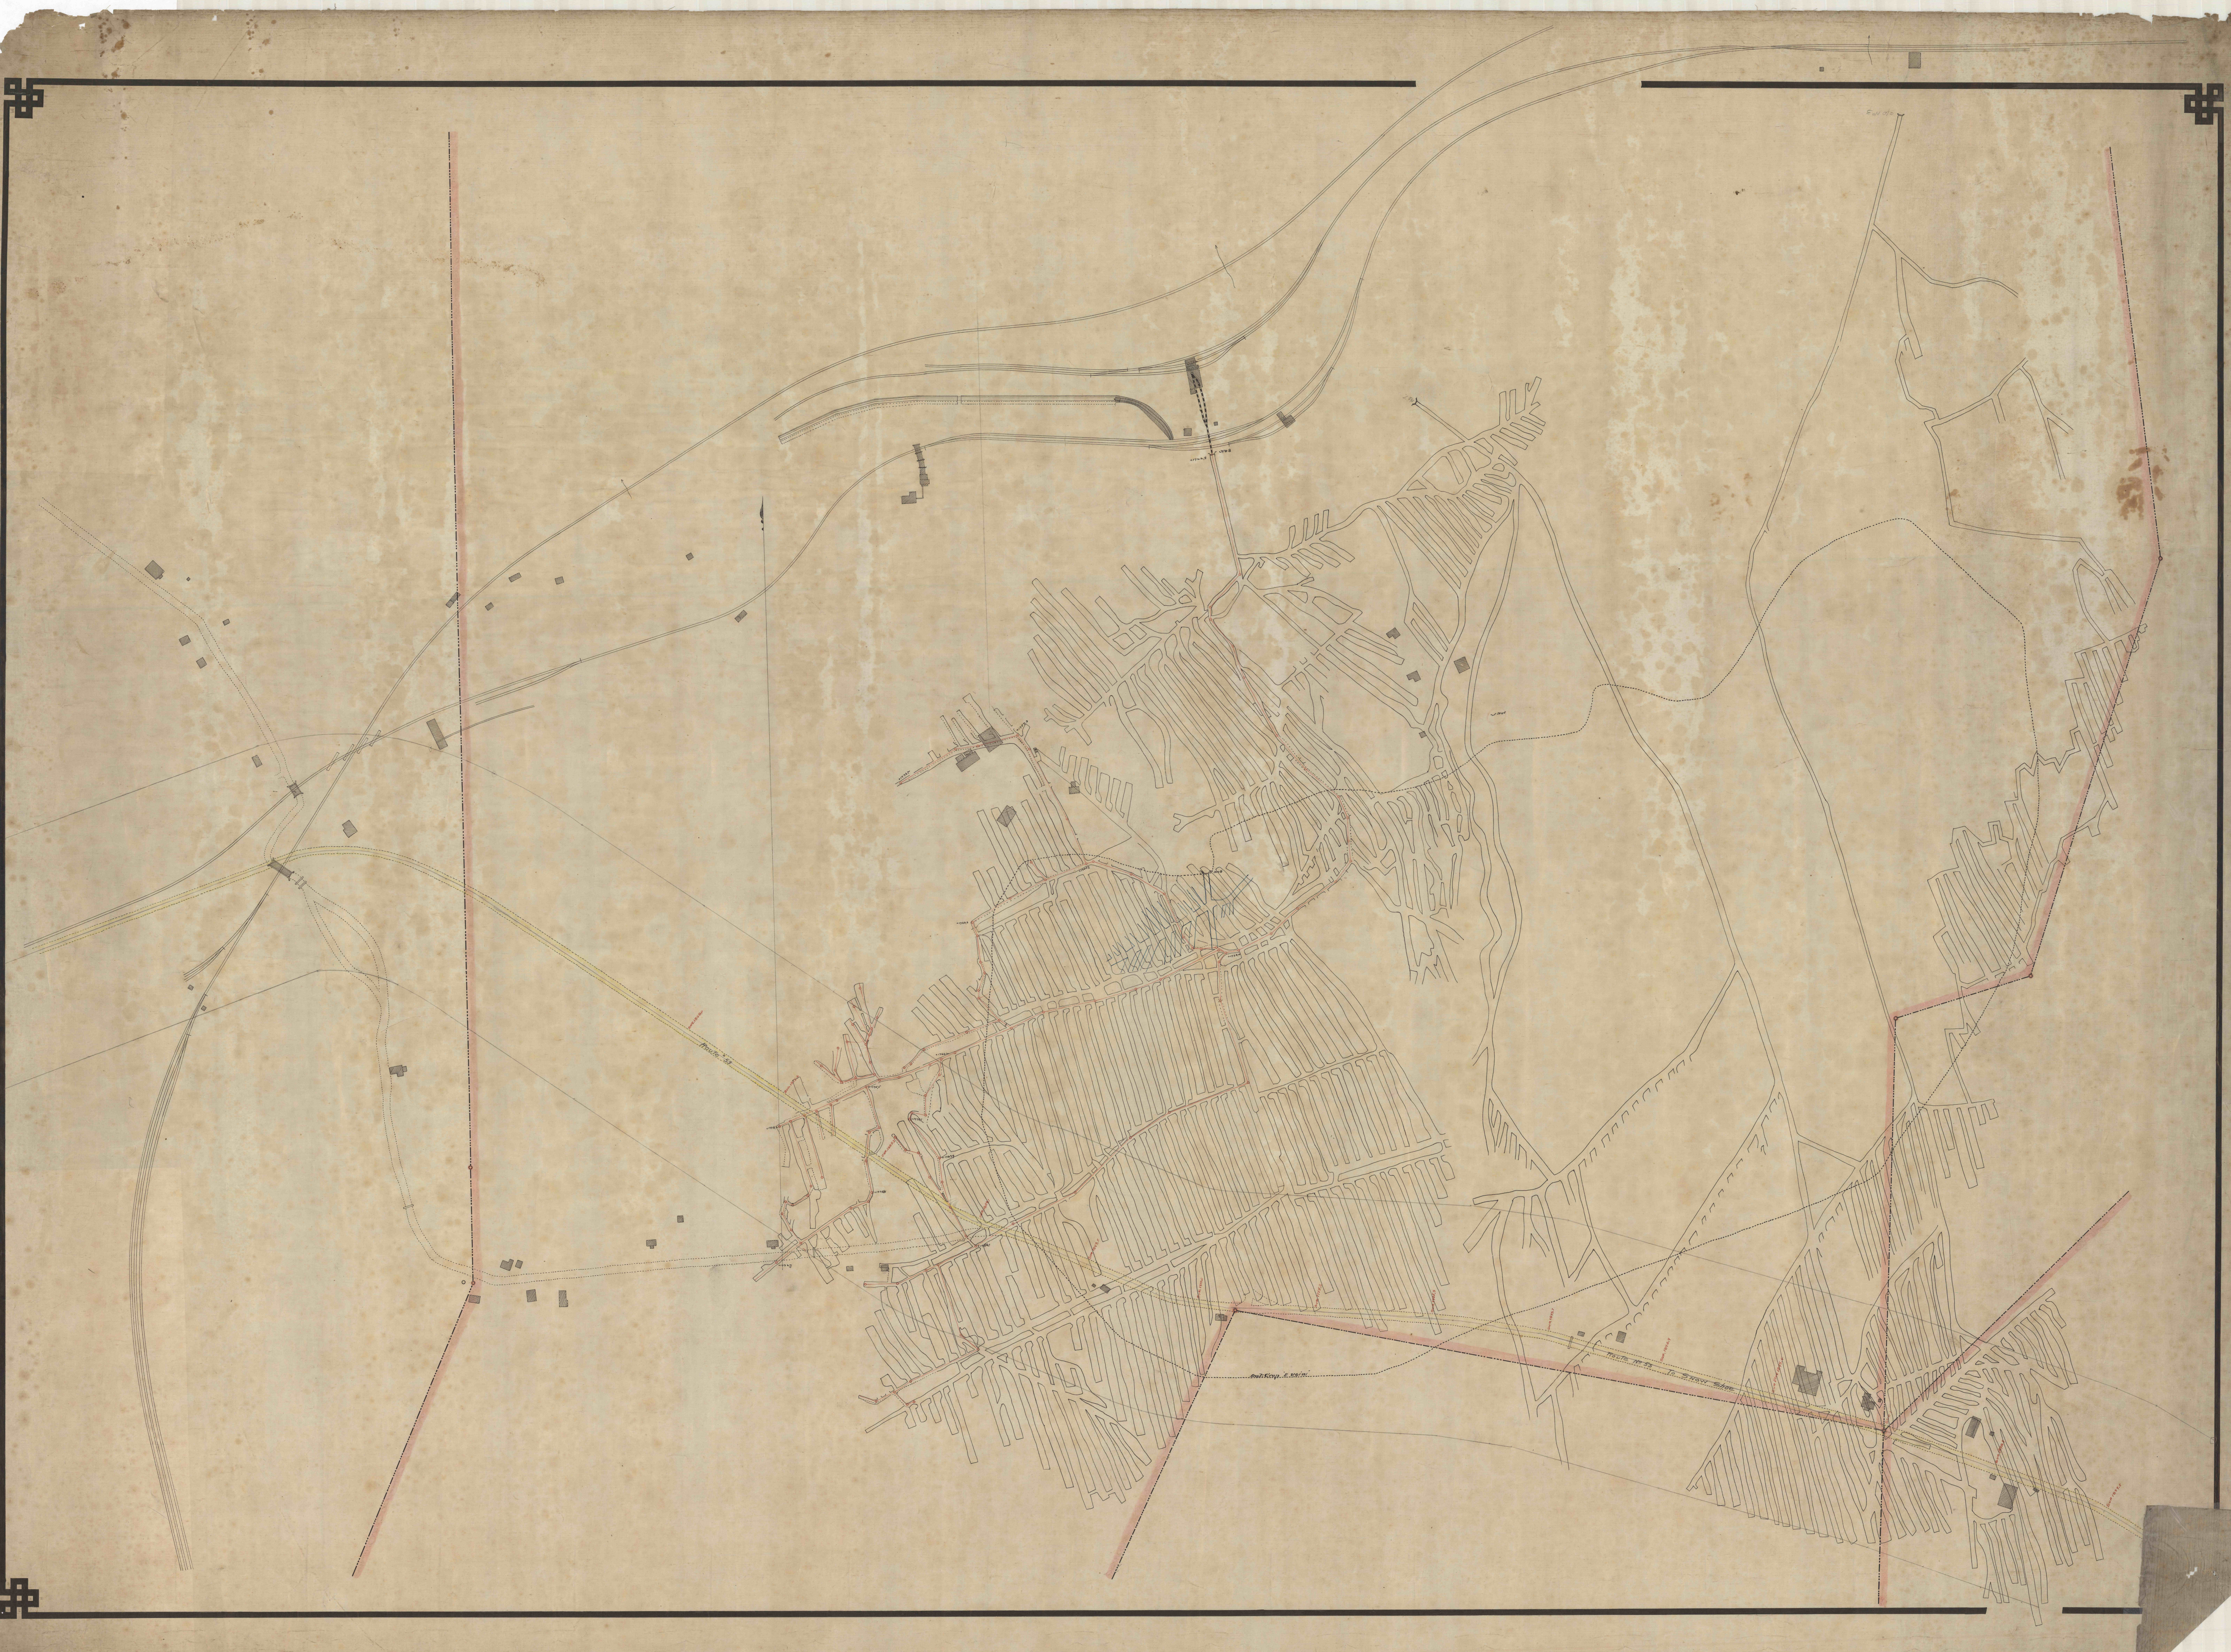
Route No 53
Out Crop "E vein"
Route No 53 To Snow Shoe
Sur. 1897.5
Sur. 1910.0
Sur. 1915.2
Sur. 1905.3
Sur. 1893.7
Sur. 1892.9
Sur. Elev. 1895.4
+1766.1