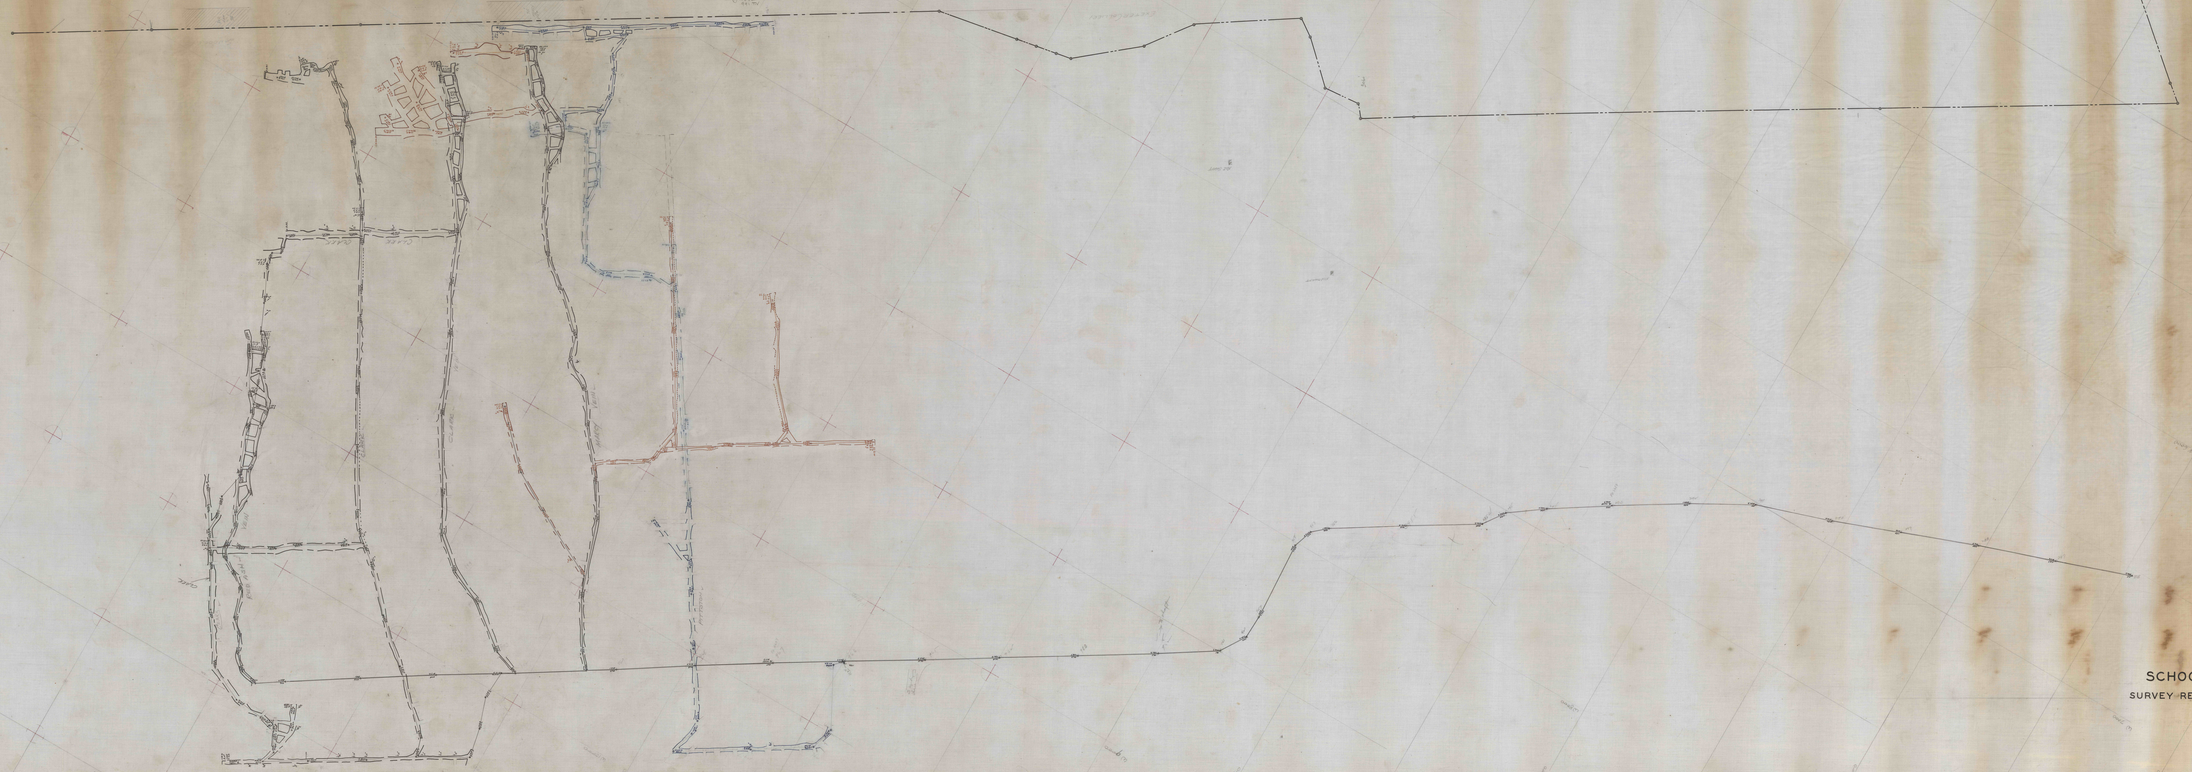


SCHOOLEY COLLIERY

SURVEY REFERENCE TRACING FROM EWEN (HOYT SHAFT)