


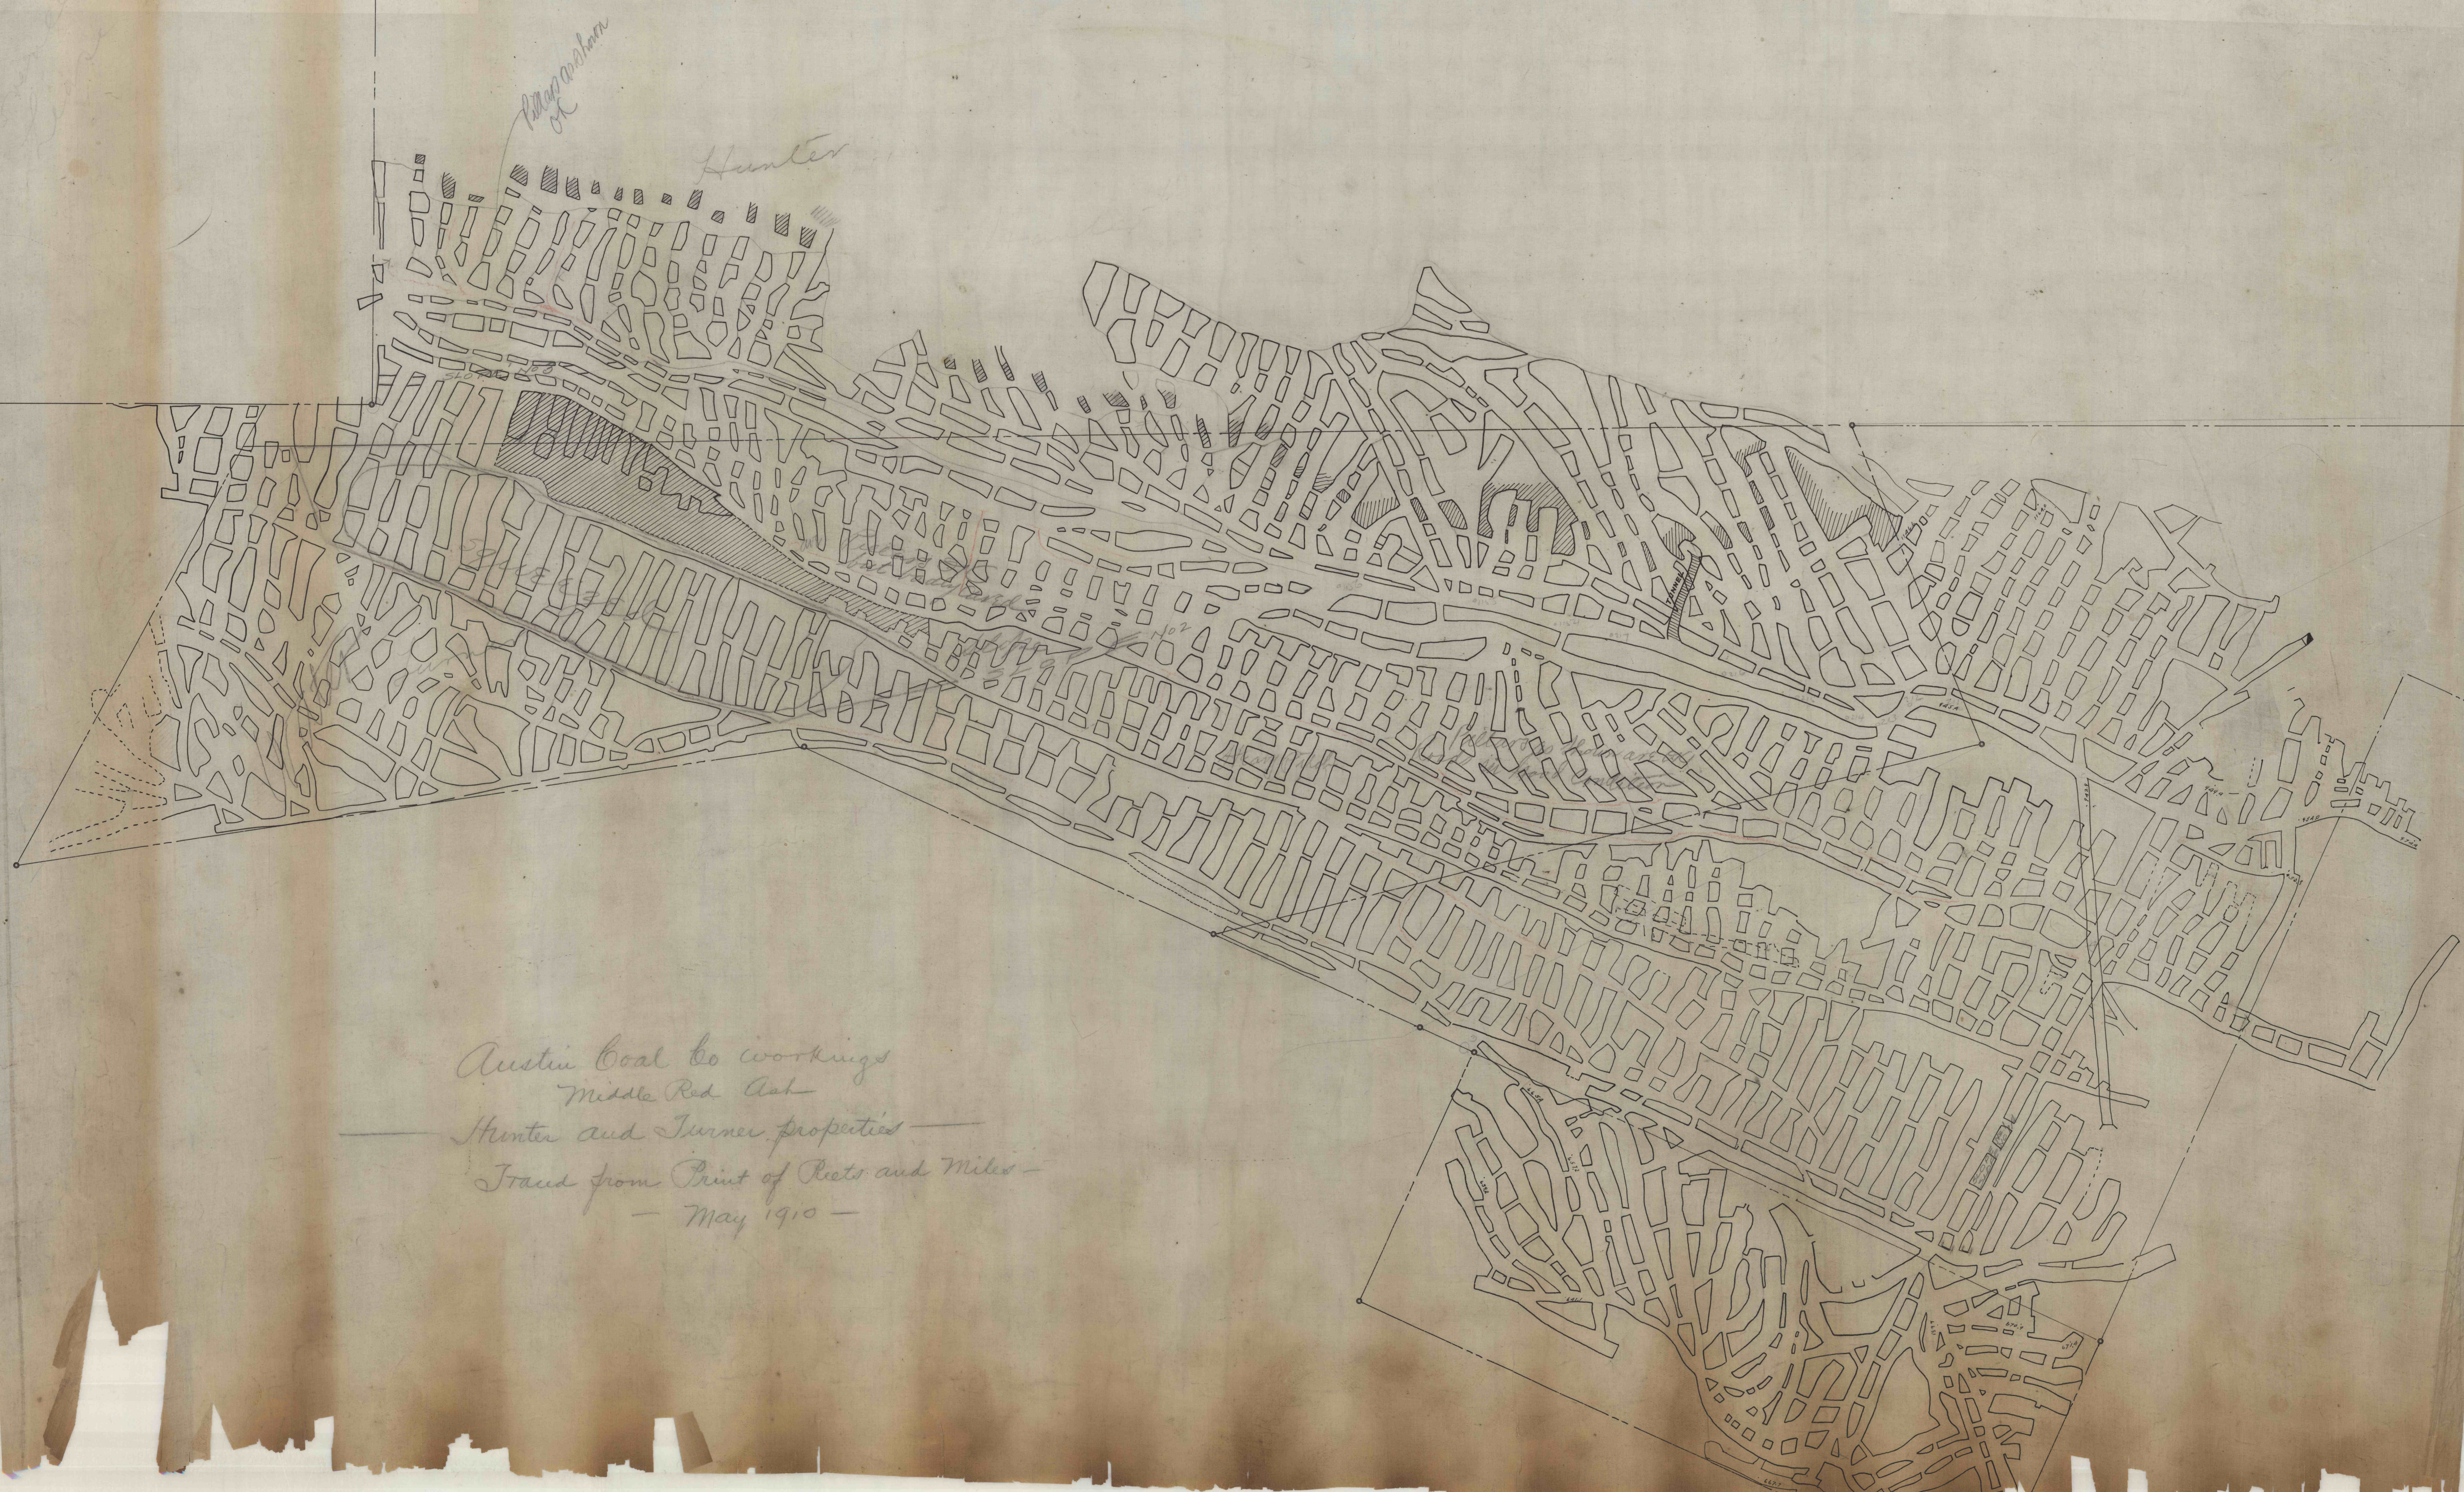

Austin Coal Co. workings
Middle Red Ash
Hunter and Turner properties
Traced from Print of Rees and Miles
— May 1910 —

64017

1079