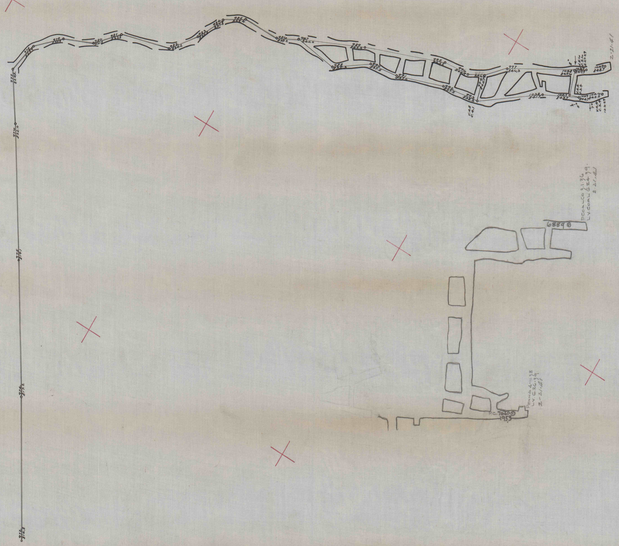

KINTZ DRIFT

SCHOOLEY

RED ASH VEIN