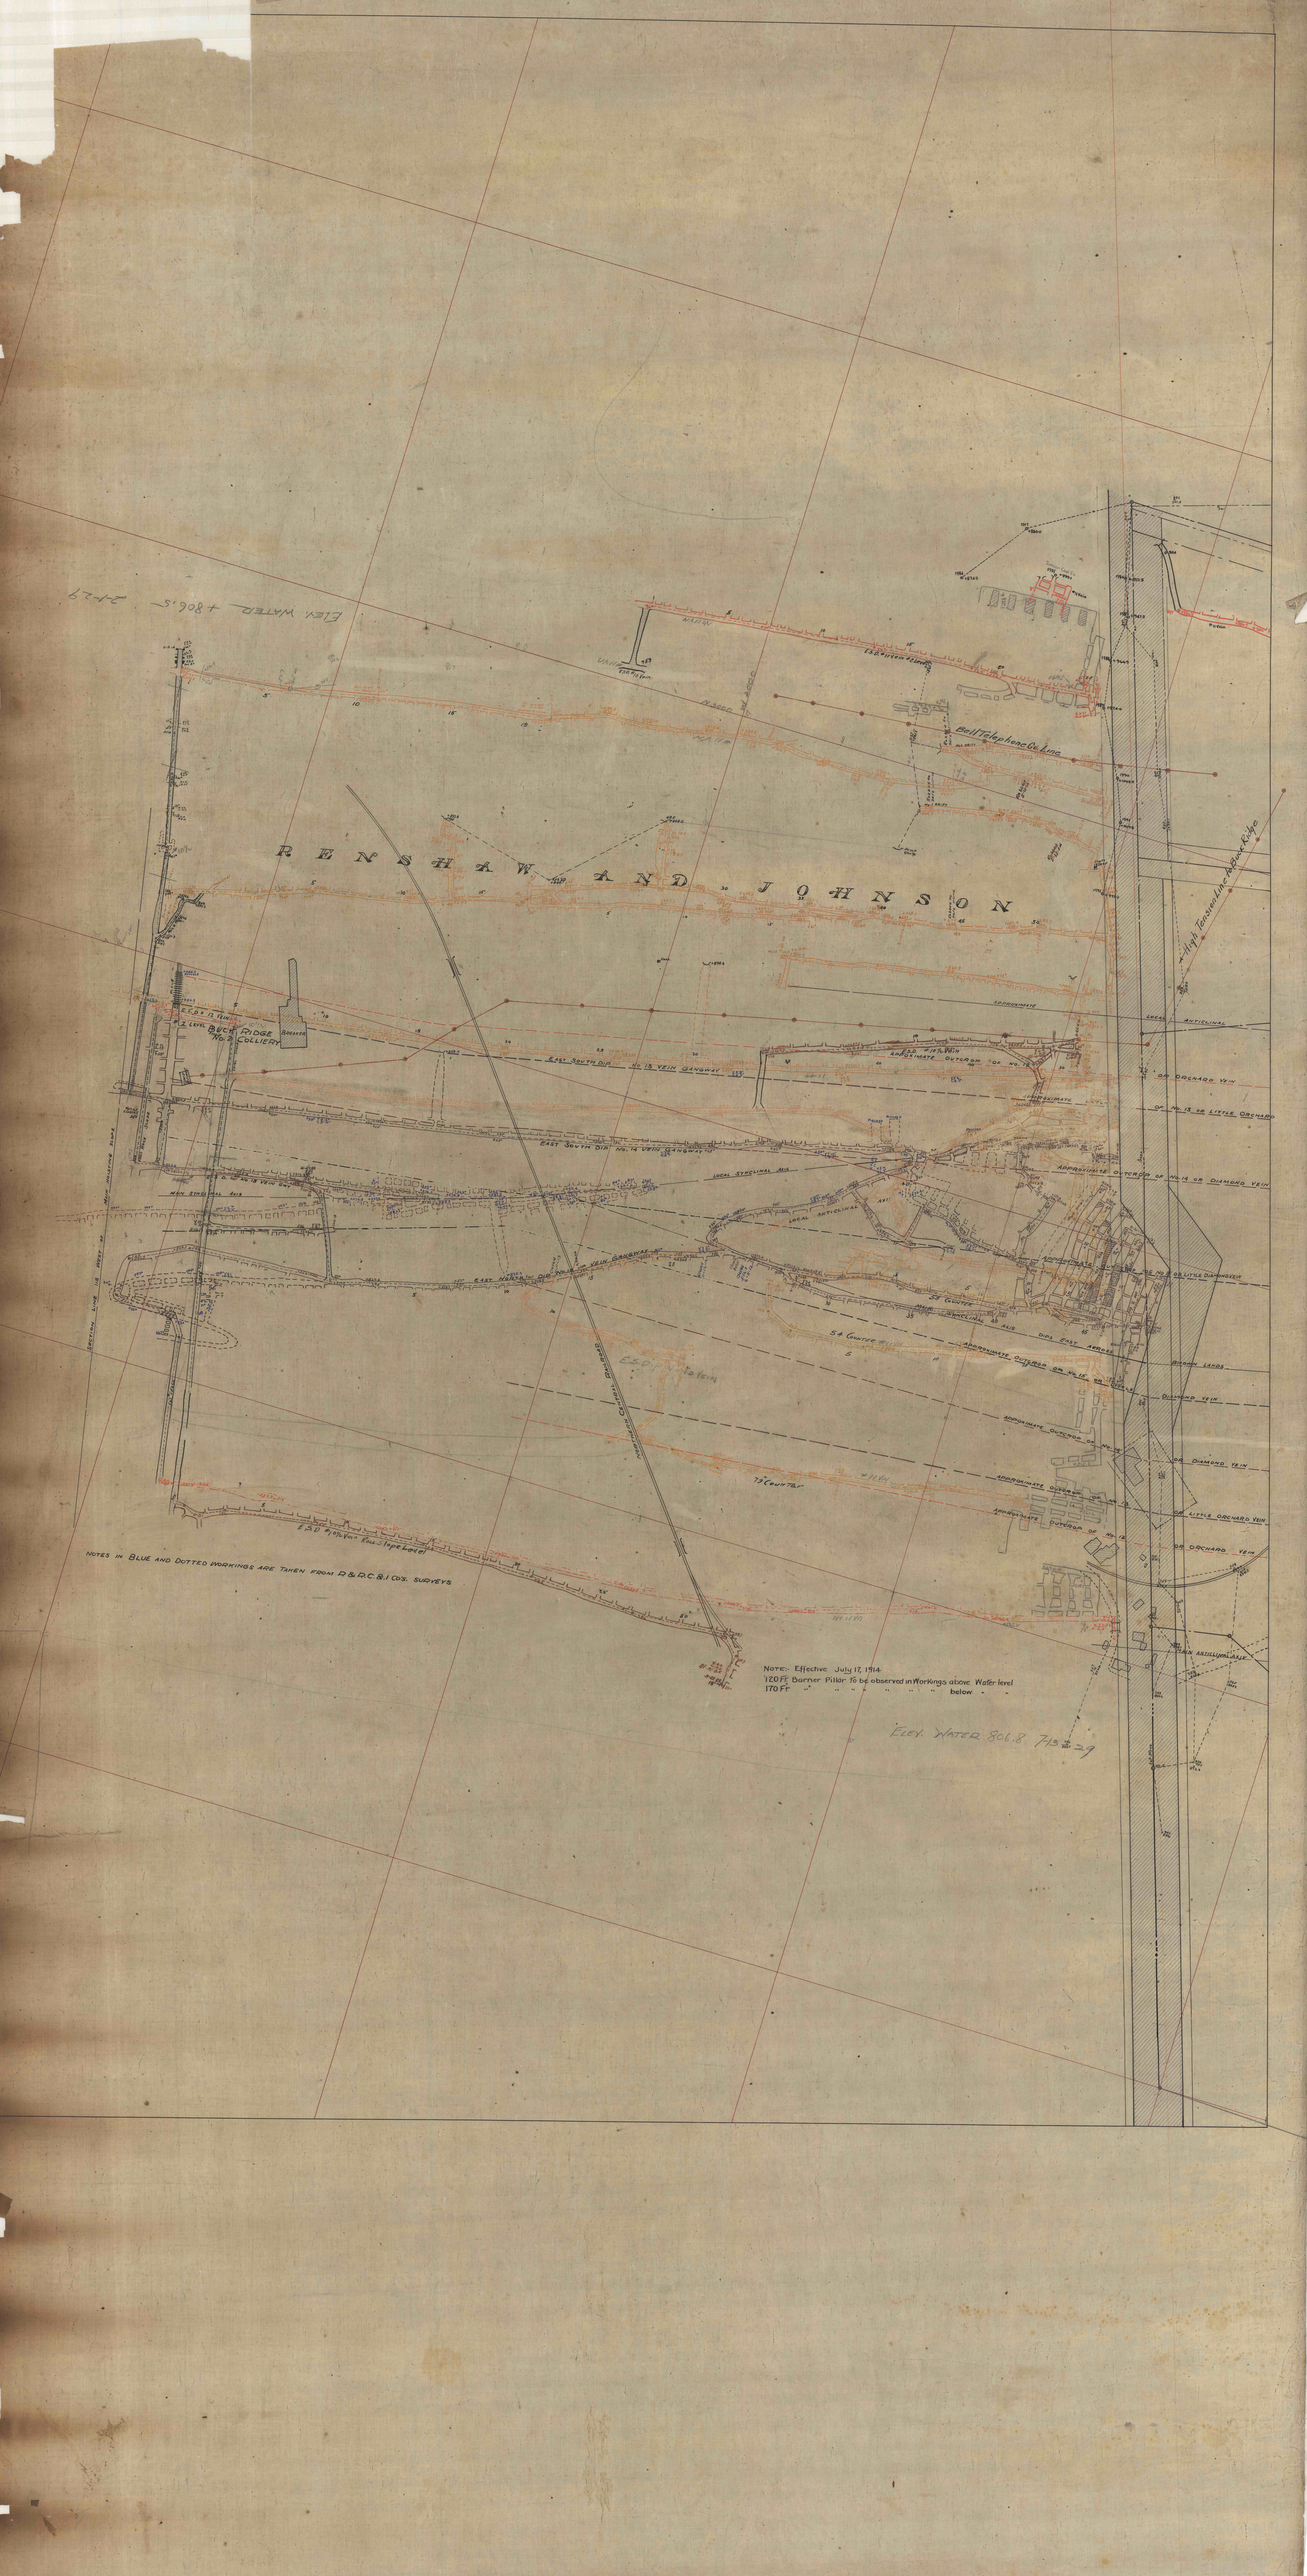
RENSHAW AND JOHNSON
Bell Telephone Co. Line
E.S.D. 13 Vein
No. 2 Level
Black Ridge Colliery
East South Dip No. 13 Vein Gangway
East South Dip No. 14 Vein Gangway
Main Rise No. 13 Vein
Main Rise No. 14 Vein
Local Synclinal Axis
Local Anticlinal Axis
Approximate Outcrop of No. 13 or Diamond Vein
Approximate Outcrop of No. 14 or Little Diamond Vein
Approximate Outcrop of No. 15 or Orchard Vein
Approximate Outcrop of No. 16 or Little Orchard Vein
