


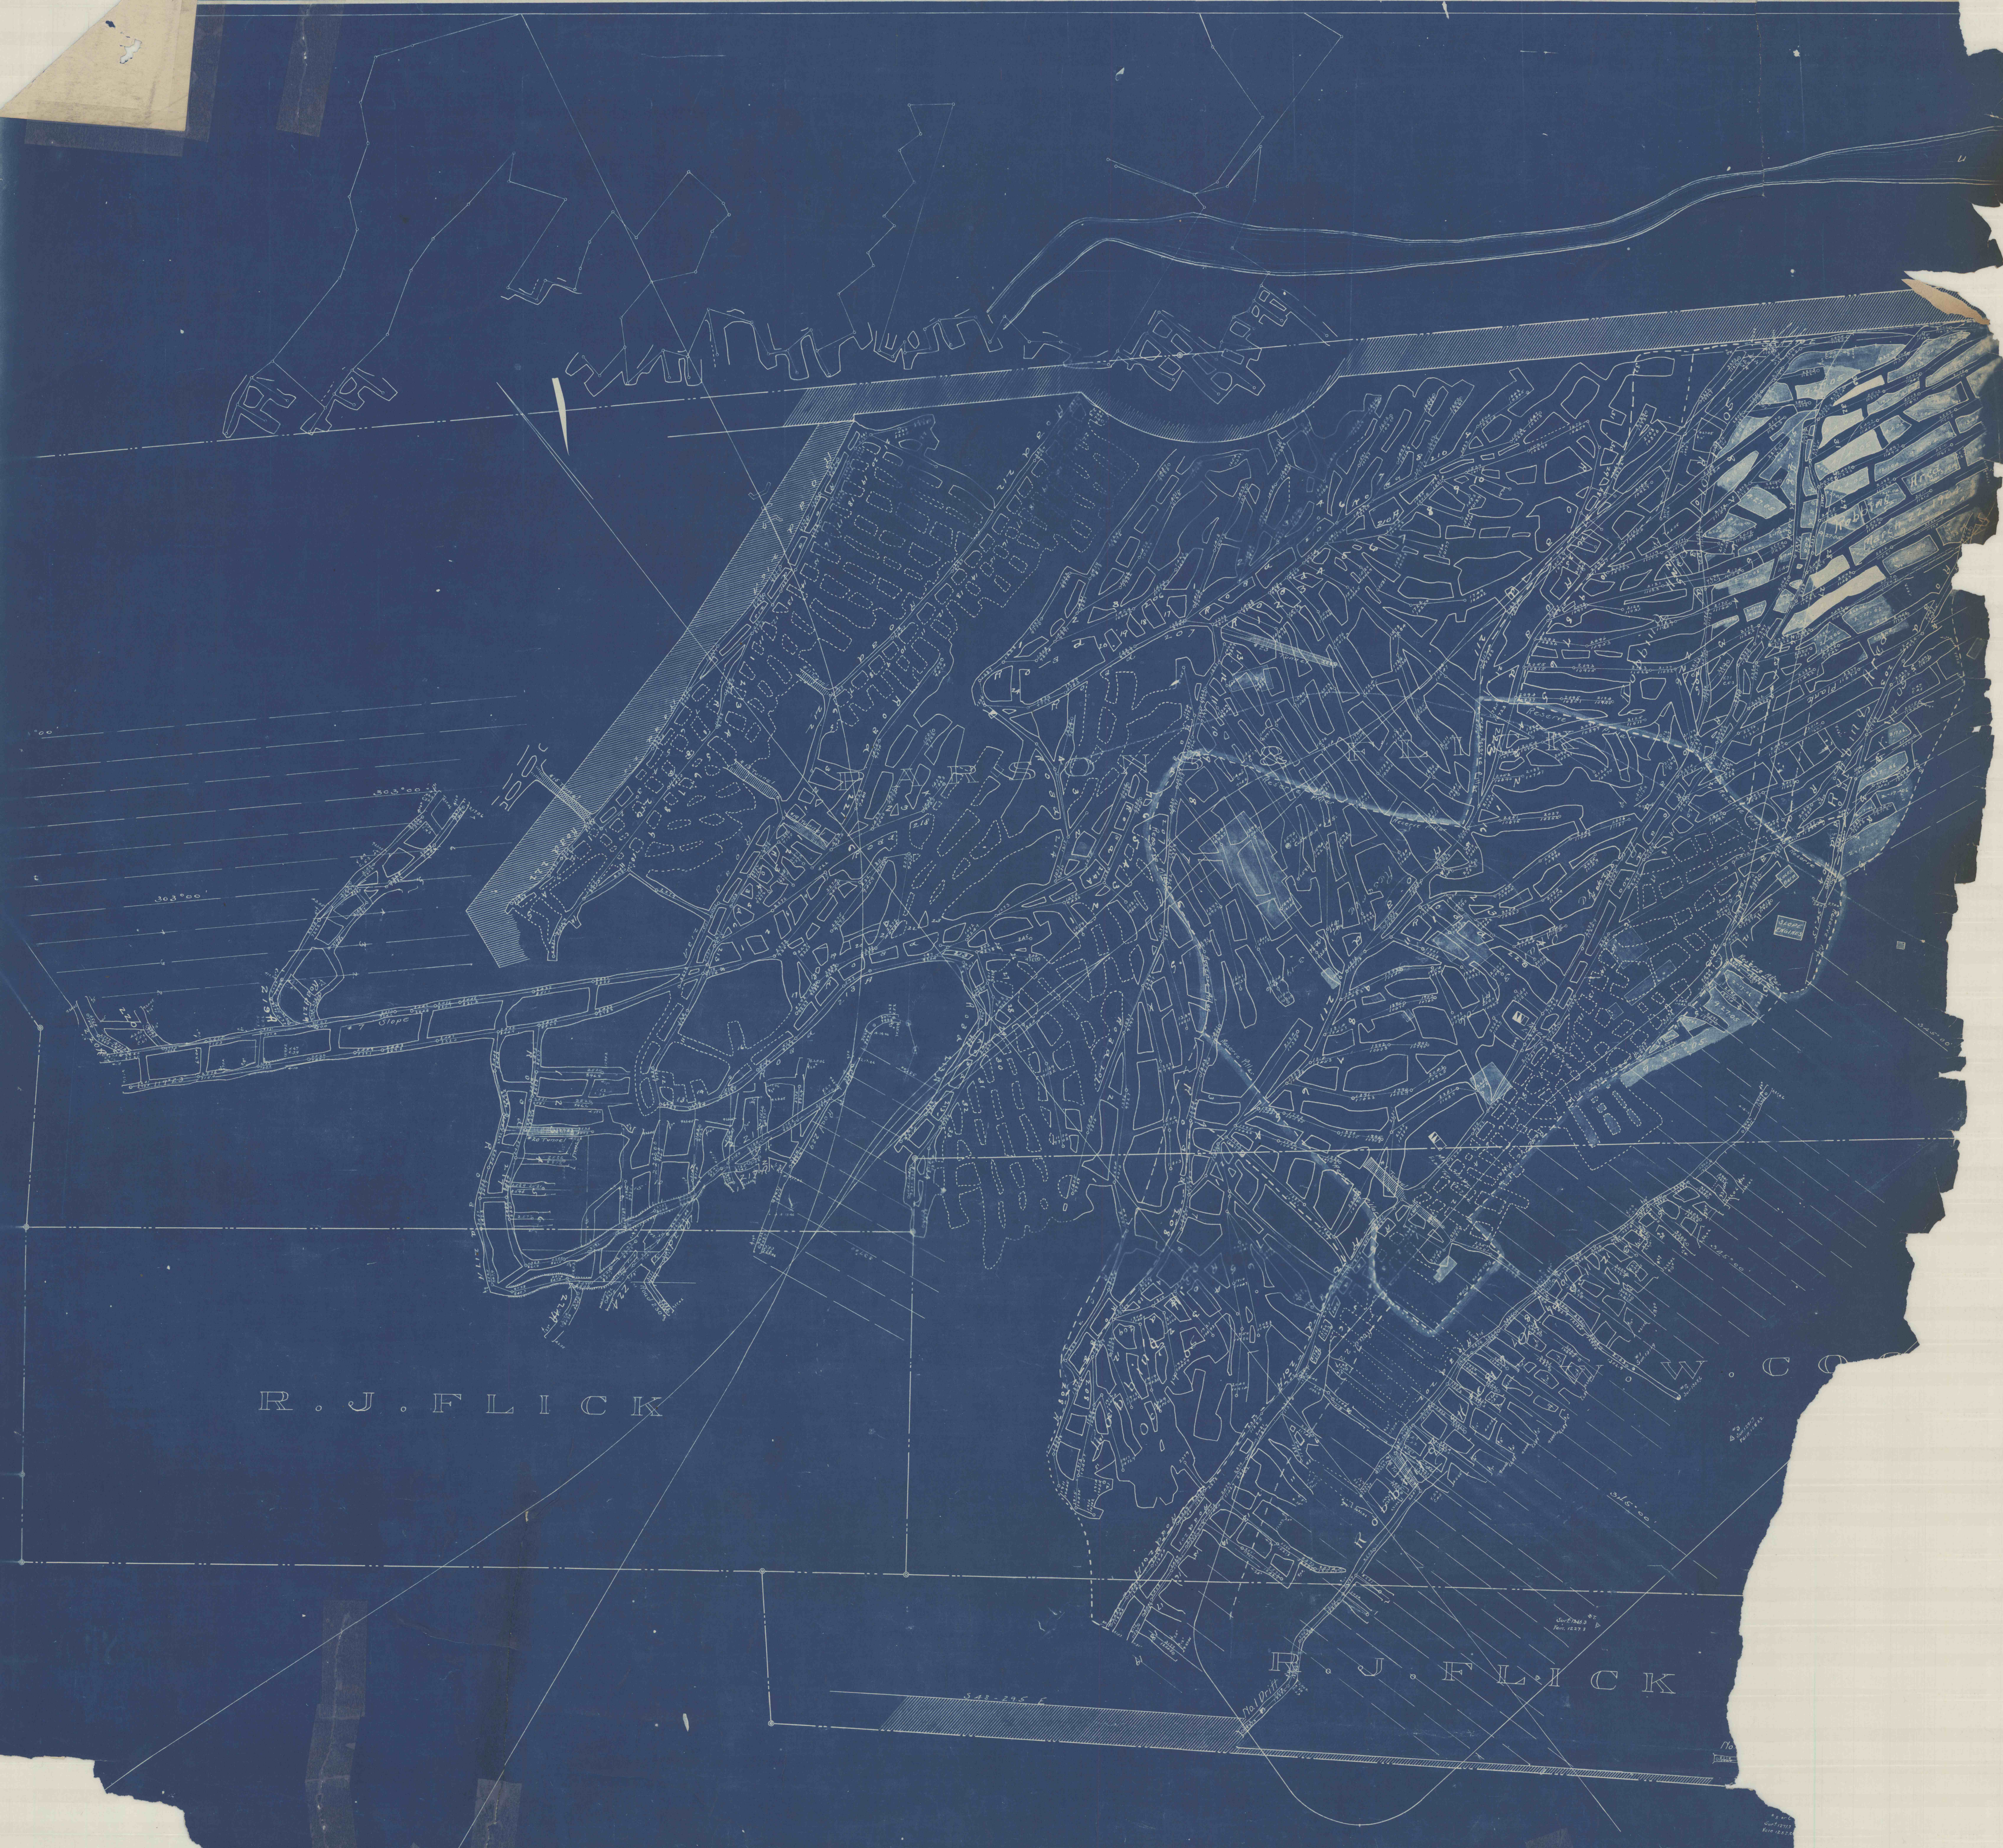

R. J. FLICK

R. J. FLICK