


1118

1119

22-348

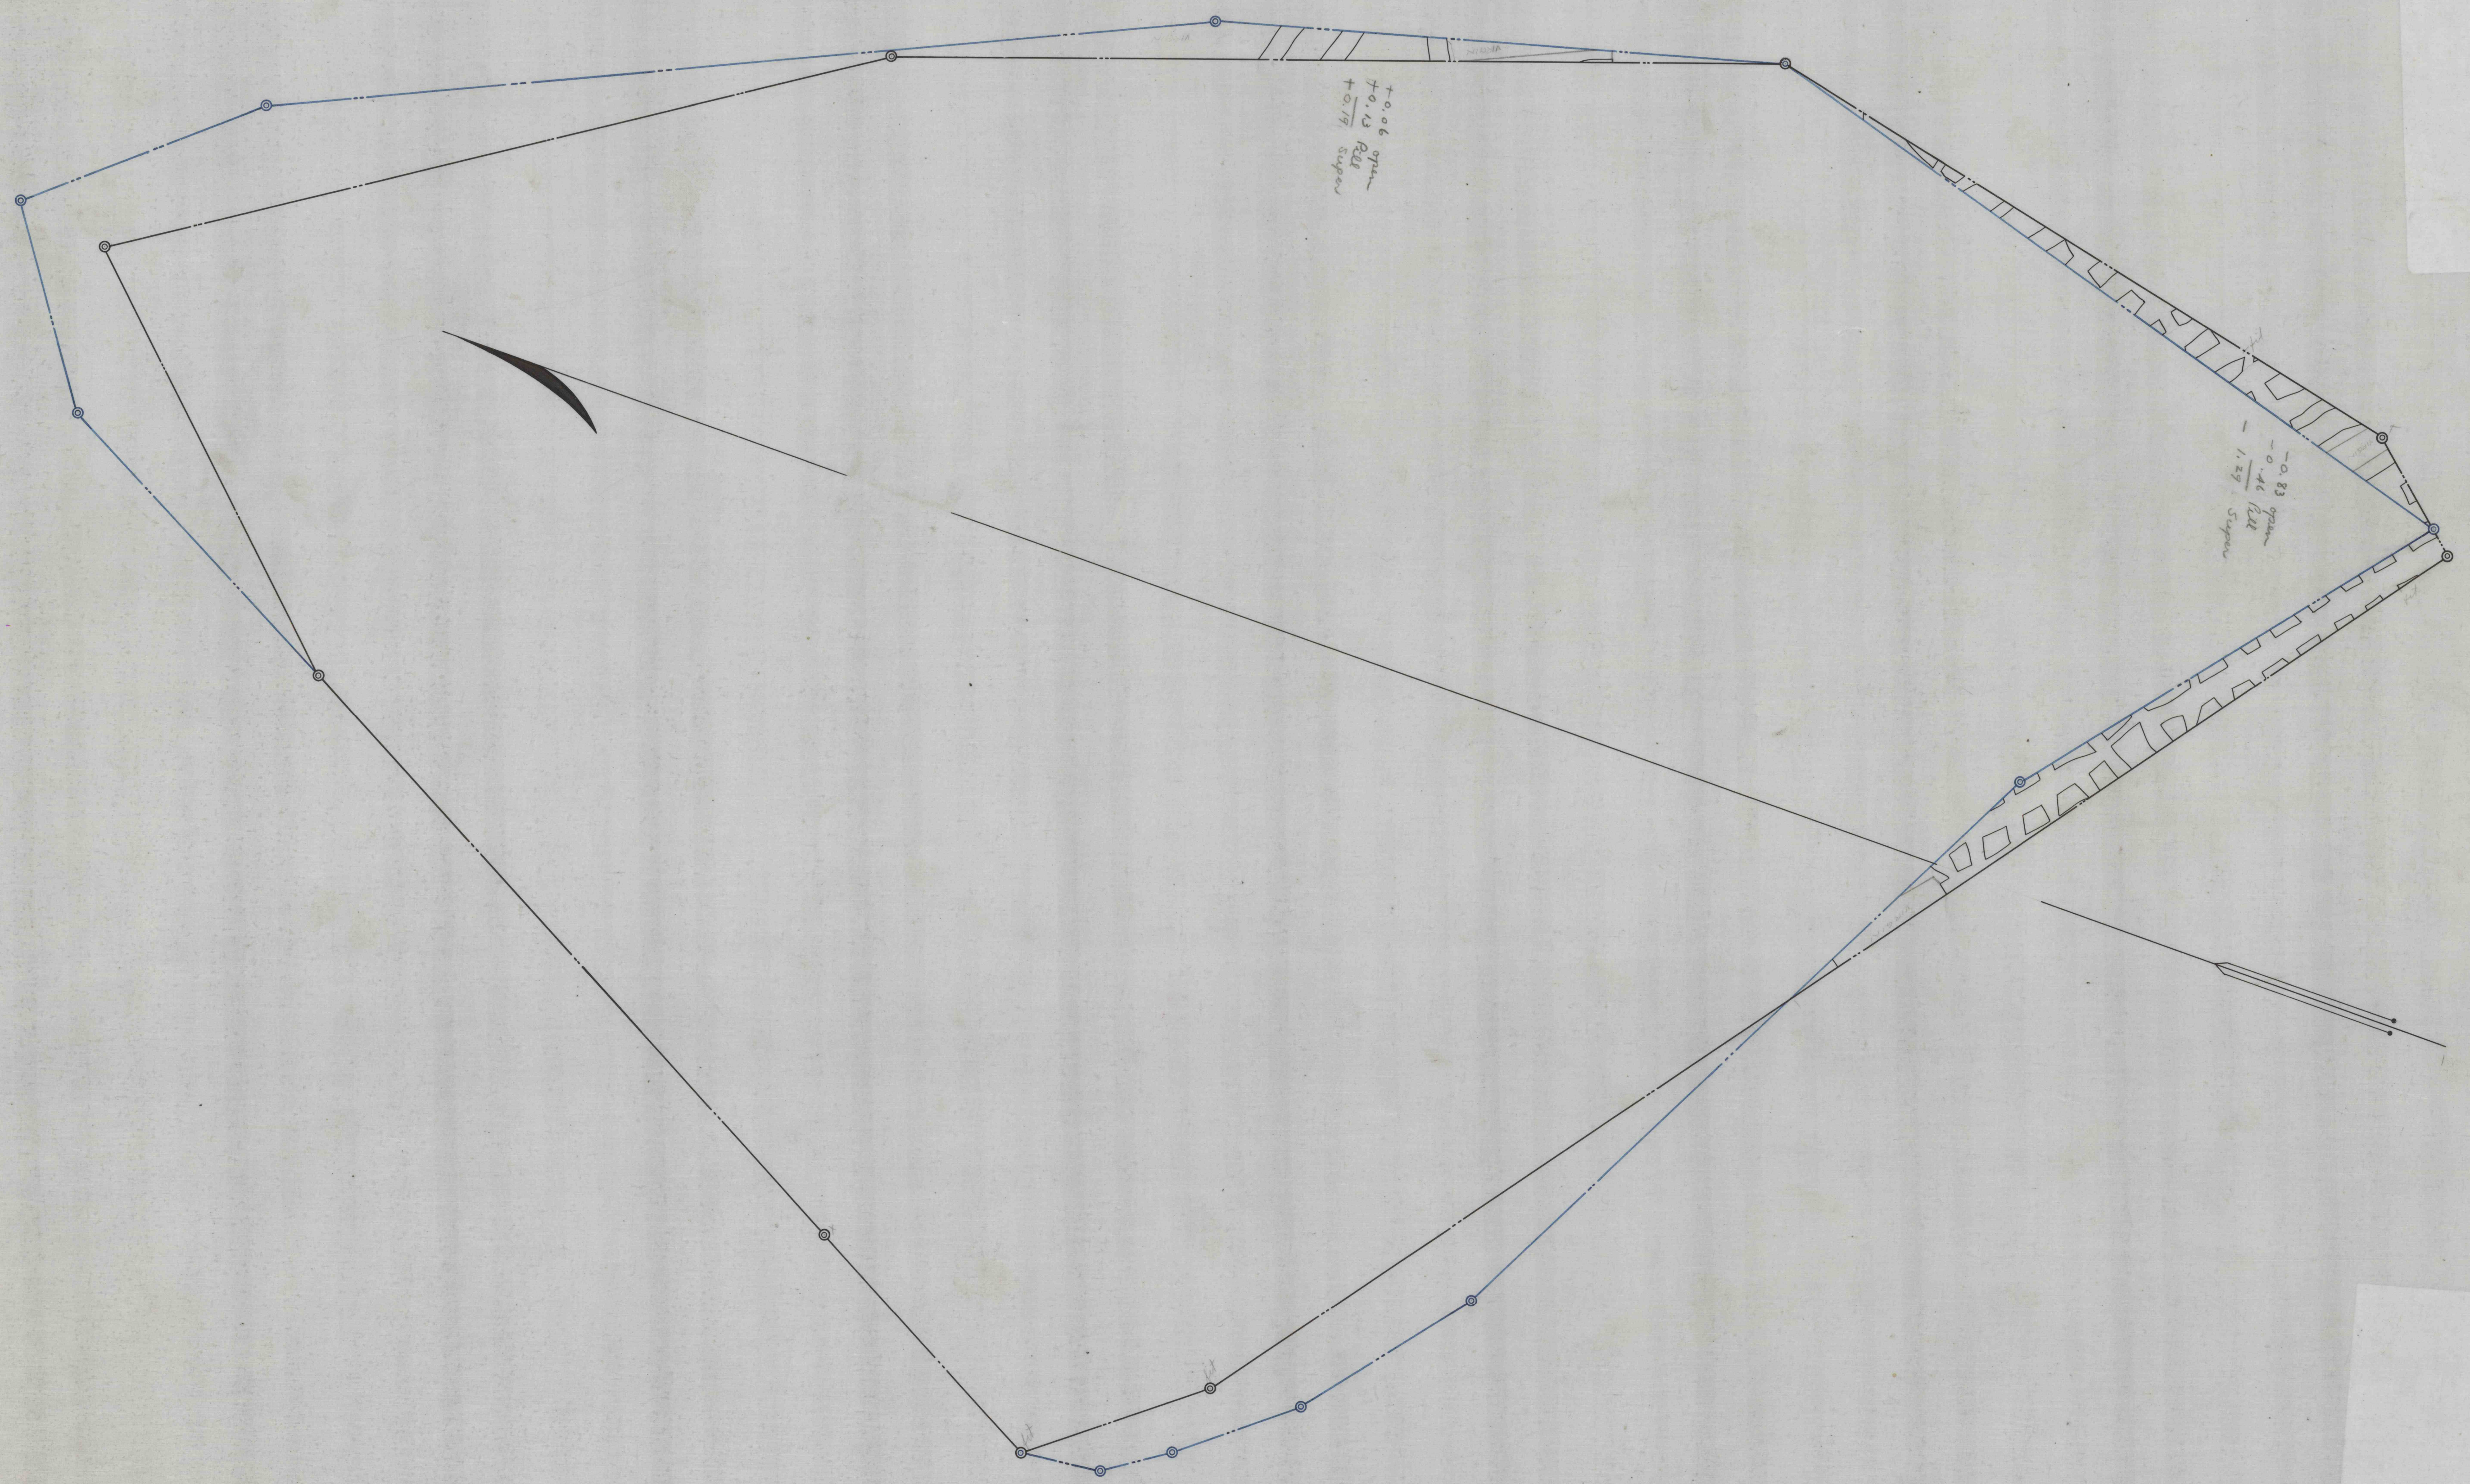

SCOVELL'S ISLAND
MARCY VEIN
SHOWING
RIVER WARRANT LINES & WARRANT LINES \approx 1802.
POSTED TO JUNE 1 1911

1118-1119
22-348

1119