Revised May 27, 1919
Blocks.
0.36 As. } Not minable
0.36 " } account of
0.38 " } water.
0.25 "
1.35 "

Blocks (Minable)
0.43 As.
0.18 "
0.61 "

Solid. Minable
0.73 As.

Solid- Not Minable
2.20 As.

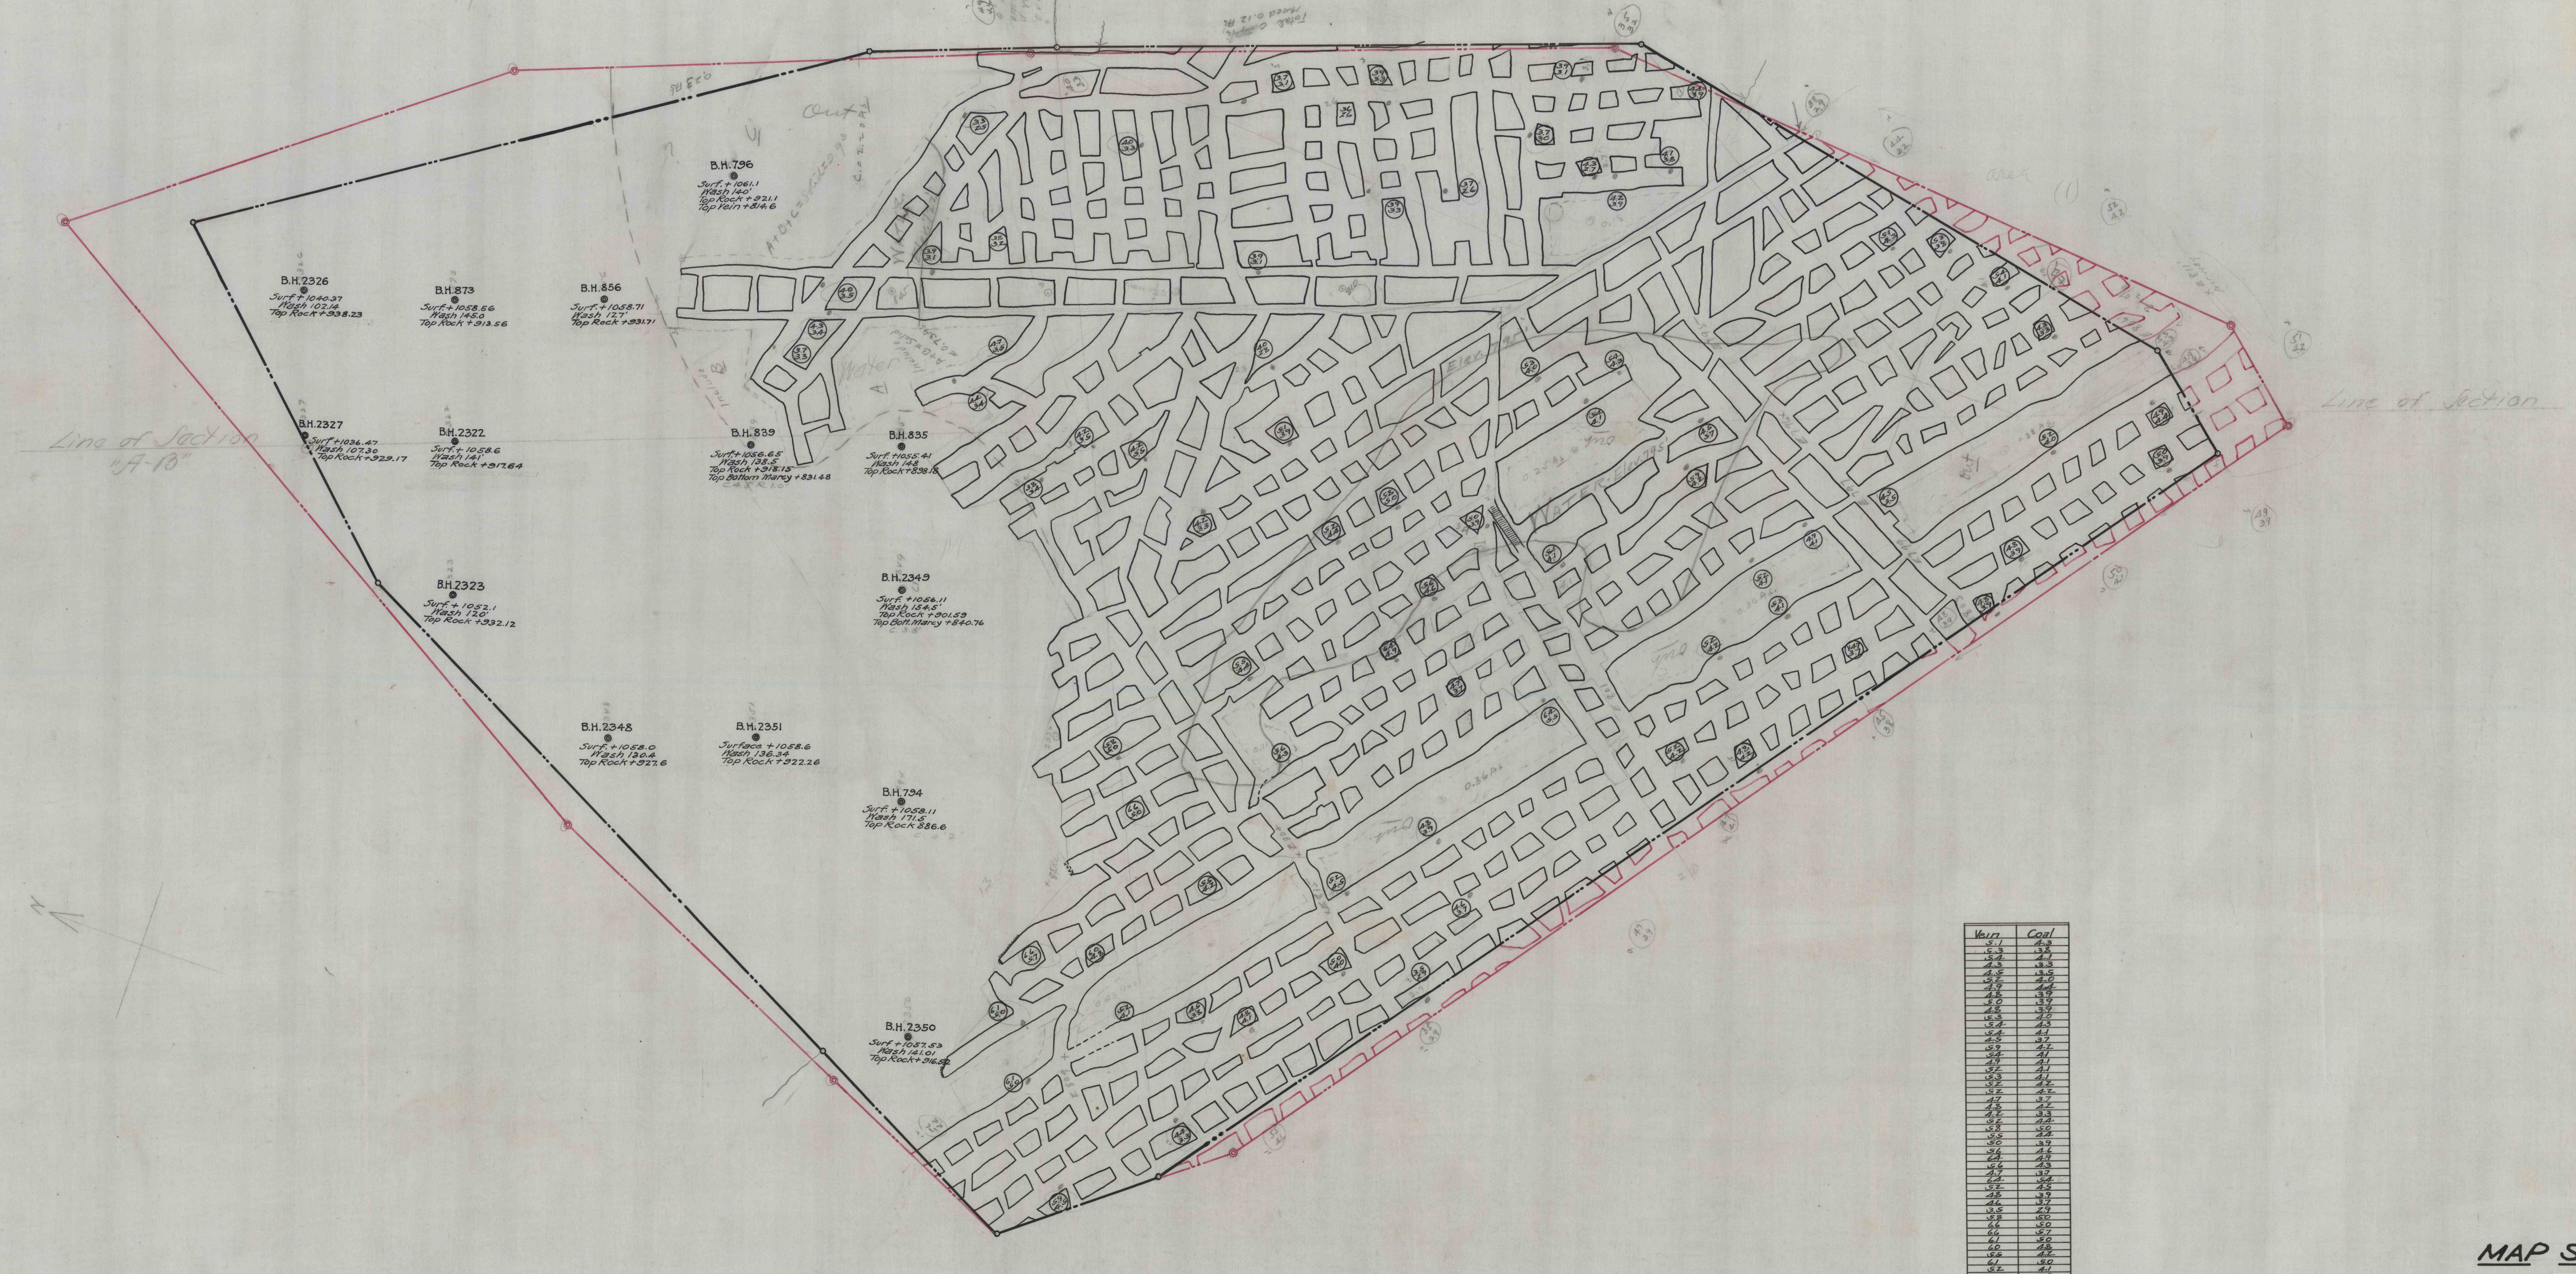

Vein	Coal
5.1	4.3
5.3	3.8
5.4	4.1
4.3	3.3
4.5	3.5
5.2	4.0
4.9	4.4
4.8	3.9
5.0	3.9
4.8	3.9
5.3	4.0
5.4	4.3
5.4	4.1
4.5	3.7
5.9	4.2
5.4	4.1
4.9	4.1
5.2	4.1
5.3	4.1
5.2	4.2
5.2	4.2
4.7	3.7
4.8	4.2
4.2	3.3
5.2	4.4
5.8	5.0
5.5	4.4
5.0	3.9
5.6	4.6
6.4	4.9
5.6	4.3
4.7	3.7
6.4	5.4
5.2	4.5
4.8	3.9
4.6	3.7
3.5	2.9
5.8	5.0
6.6	5.0
6.6	5.7
6.1	5.0
6.0	4.8
5.5	4.2
6.1	5.0
5.2	4.1
4.5	3.8
4.8	4.1
5.0	4.0
5.9	4.5
4.4	3.3
3.7	3.3
4.3	3.4
4.7	3.5
4.4	3.4
3.8	3.4
4.2	3.5
4.2	3.5
4.0	2.8
5.1	3.9
4.0	3.5
3.9	3.1
3.3	2.5
3.8	3.2
4.0	3.3
3.9	3.1
3.7	3.1
3.6	2.6
3.9	3.8
3.9	3.3
3.7	2.6
3.7	3.0
3.9	3.1
4.3	2.7
4.2	3.9
4.1	3.8
4.4	3.9
Total 76: 366.2	294.2
Average: 4.8	3.9

MAP SHOWING
SCOVILLES ISLAND
BOTTOM MARCY VEIN

BLACK LINES – RIVER WAR. SURVEY
RED " LEASE OF DEC. 10 1887
BASED ON THE POSTING OF JULY 1, 1919
L.V.C.CO. ENGR. DEPT. LACKAWANNA DIV.
SCALE 1 INCH = 100 FEET OCT. 1919

22-348