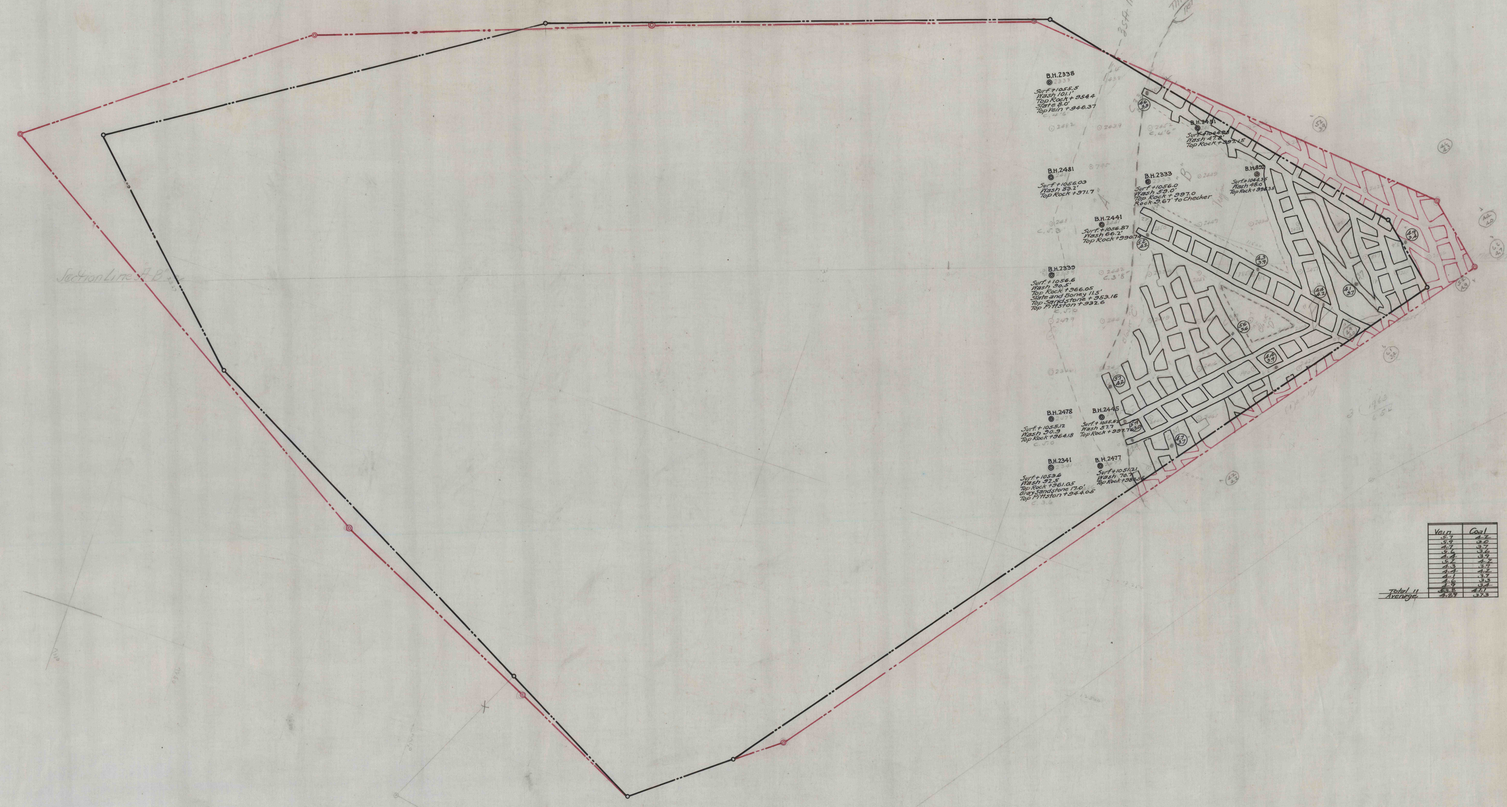

MAP SHOWING
SCOVILLES ISLAND
PITTSTON VEIN
BLACK LINES - RIVER WAR. SURVEY
RED " LEASE OF DEC. 10 1887
BASED ON THE POSTING OF JULY 11 1919
L.V.C.CO. ENGR. DEPT. LACKAWANNA DIV.
SCALE 1 INCH = 100 FEET OCT. 1919

22-348

7