
Glendower #42

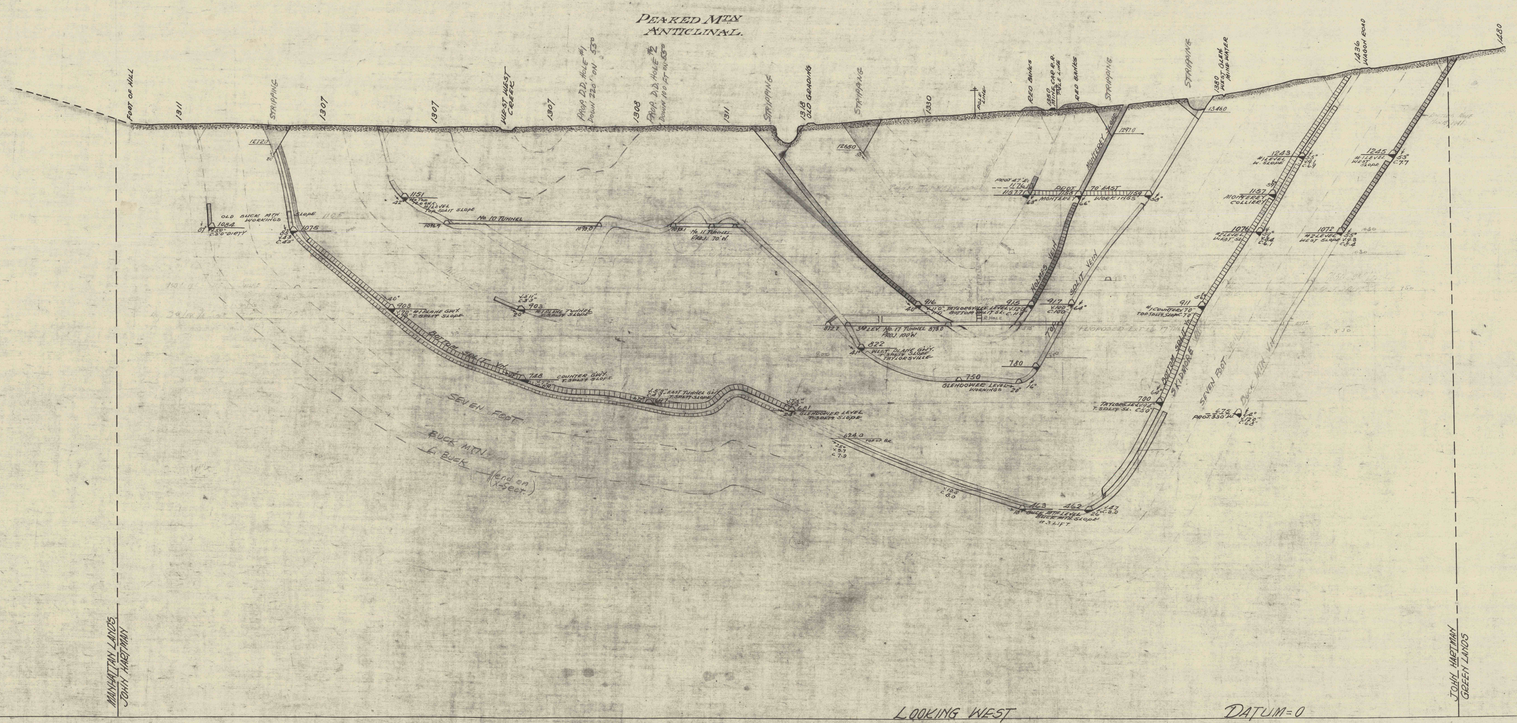

GLENDOWER COLLY.

Cross Section THRU OLD MONTEREY SLOPE.

SCALE 1"=100' MAY, 1922.

JECT 42

Glendower #42