


TRACING NO 7
F160-Nº4

MIDDLE HILLMAN VEIN

TRACING NO 1
F160-Nº4

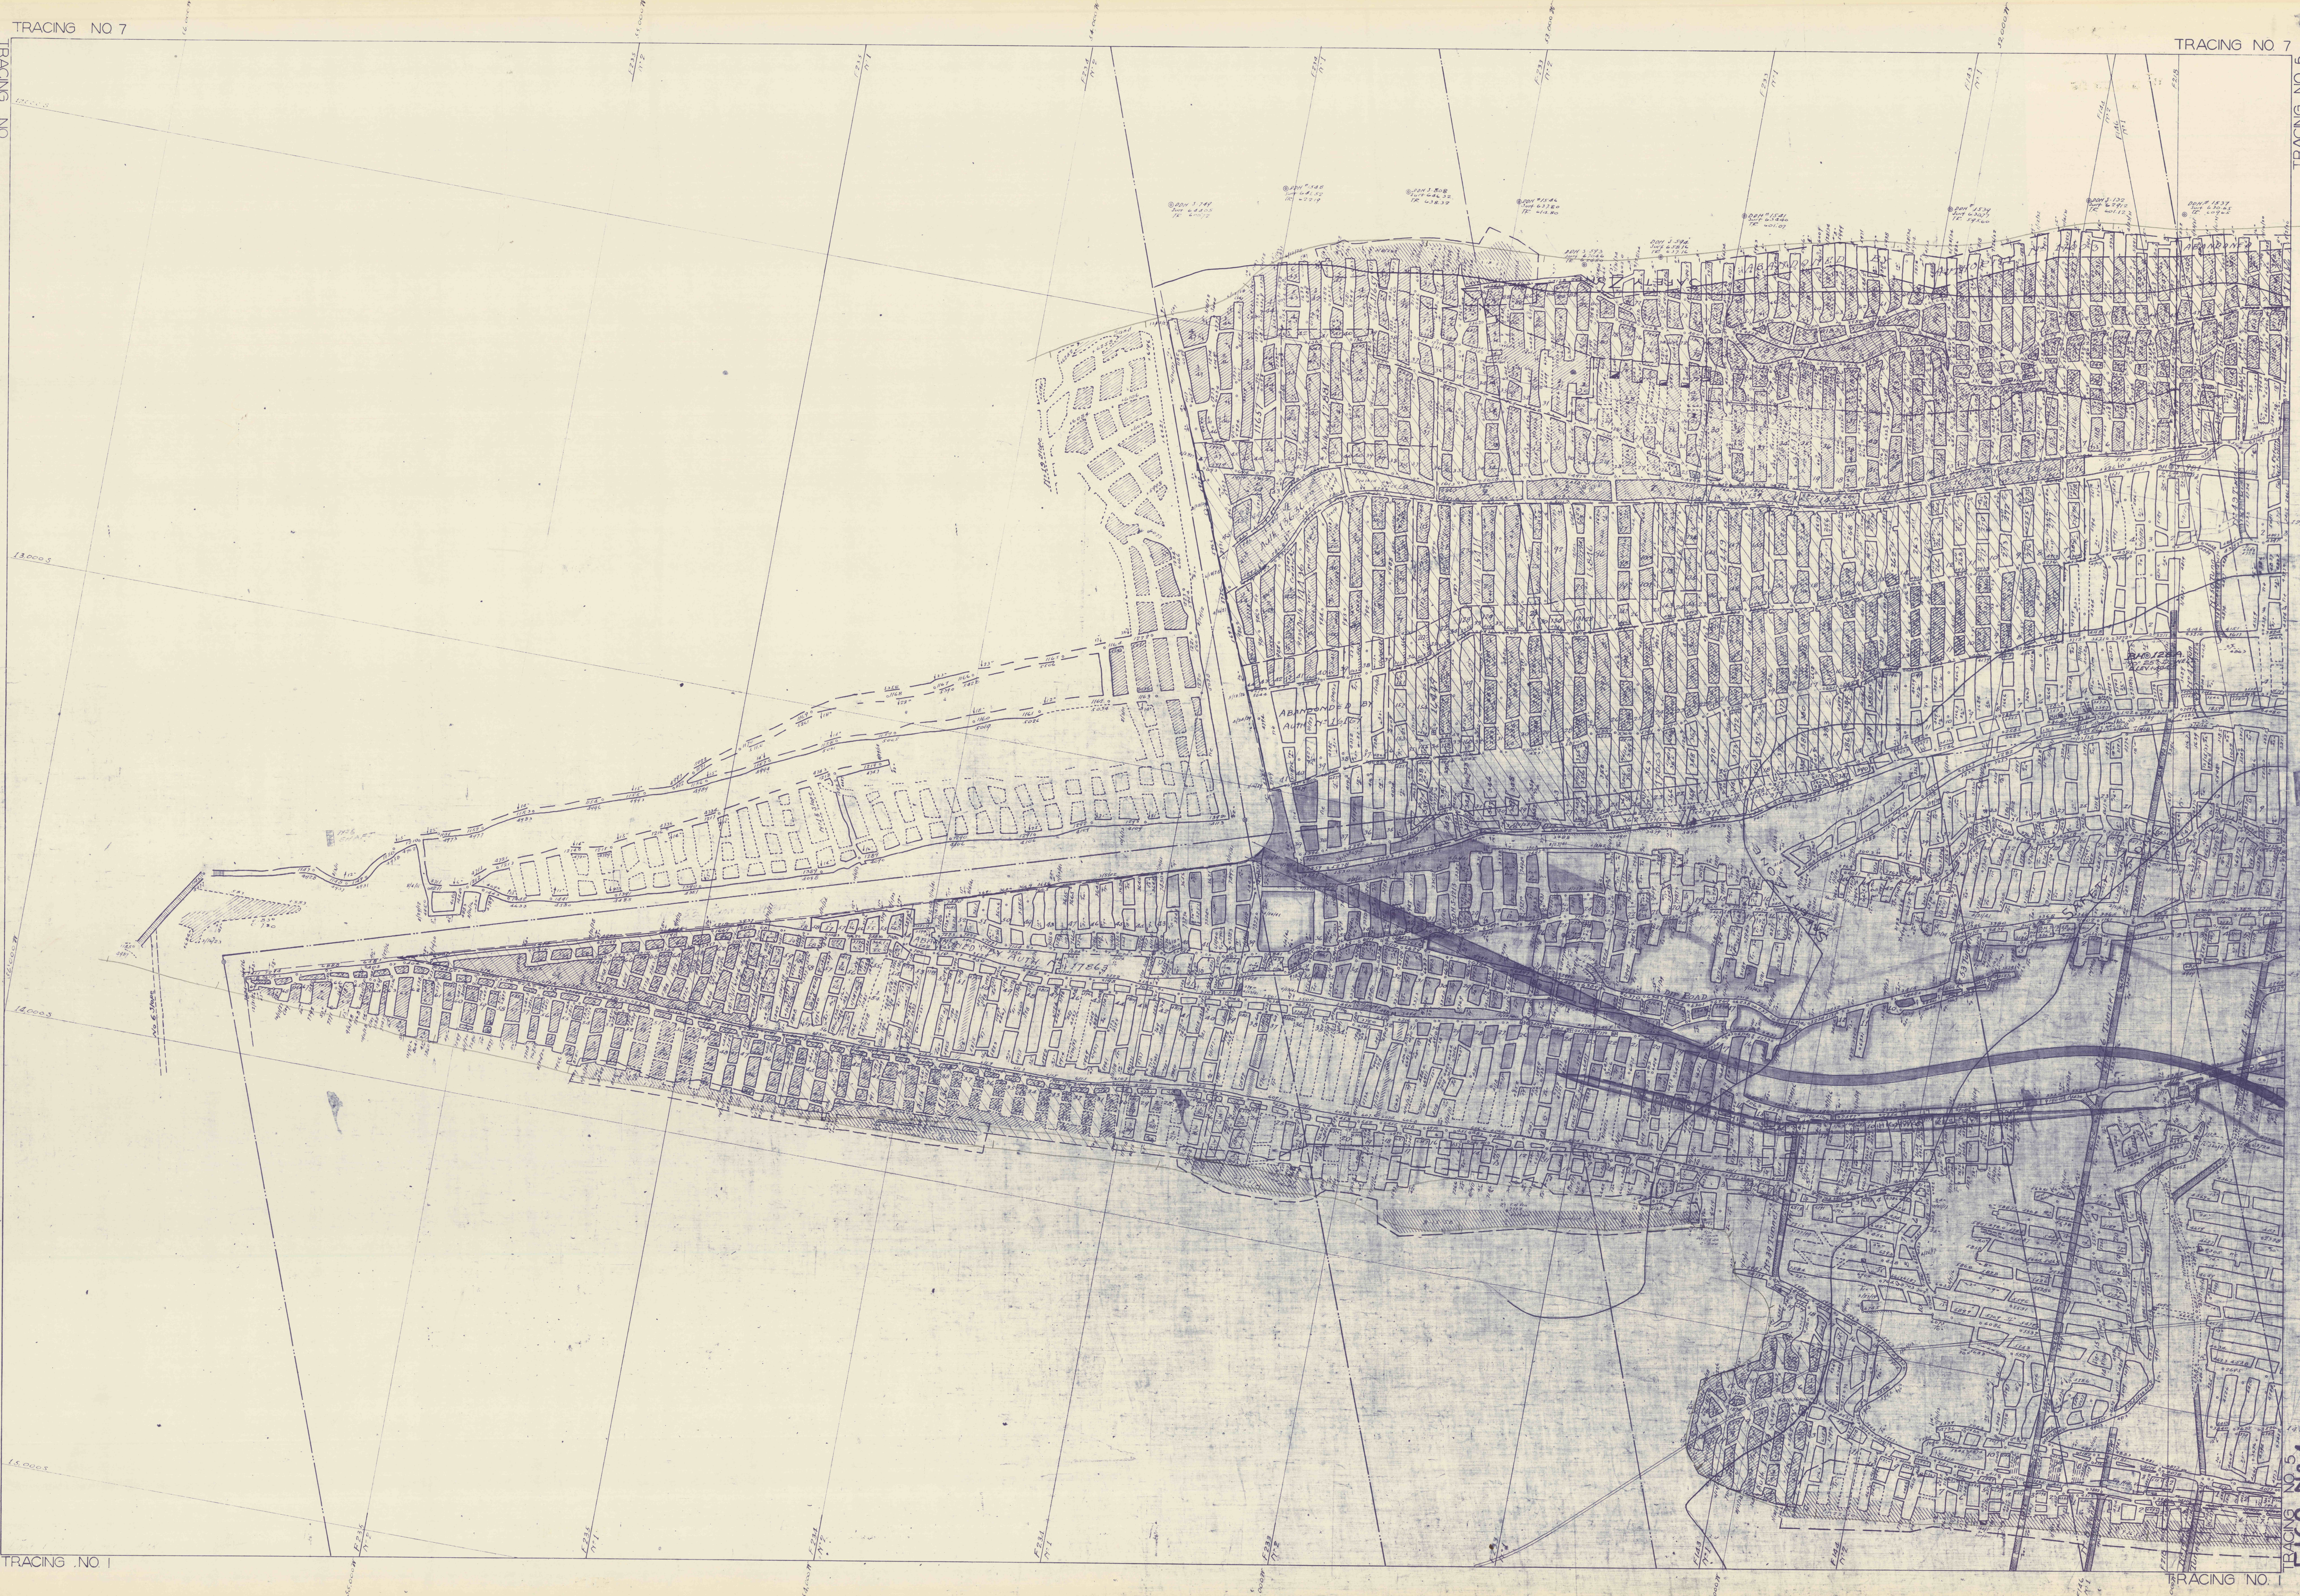

TRACING NO 7
F160-Nº4

MIDDLE HILLMAN VEIN

TRACING NO 5
F160-Nº4

TRACING NO 1