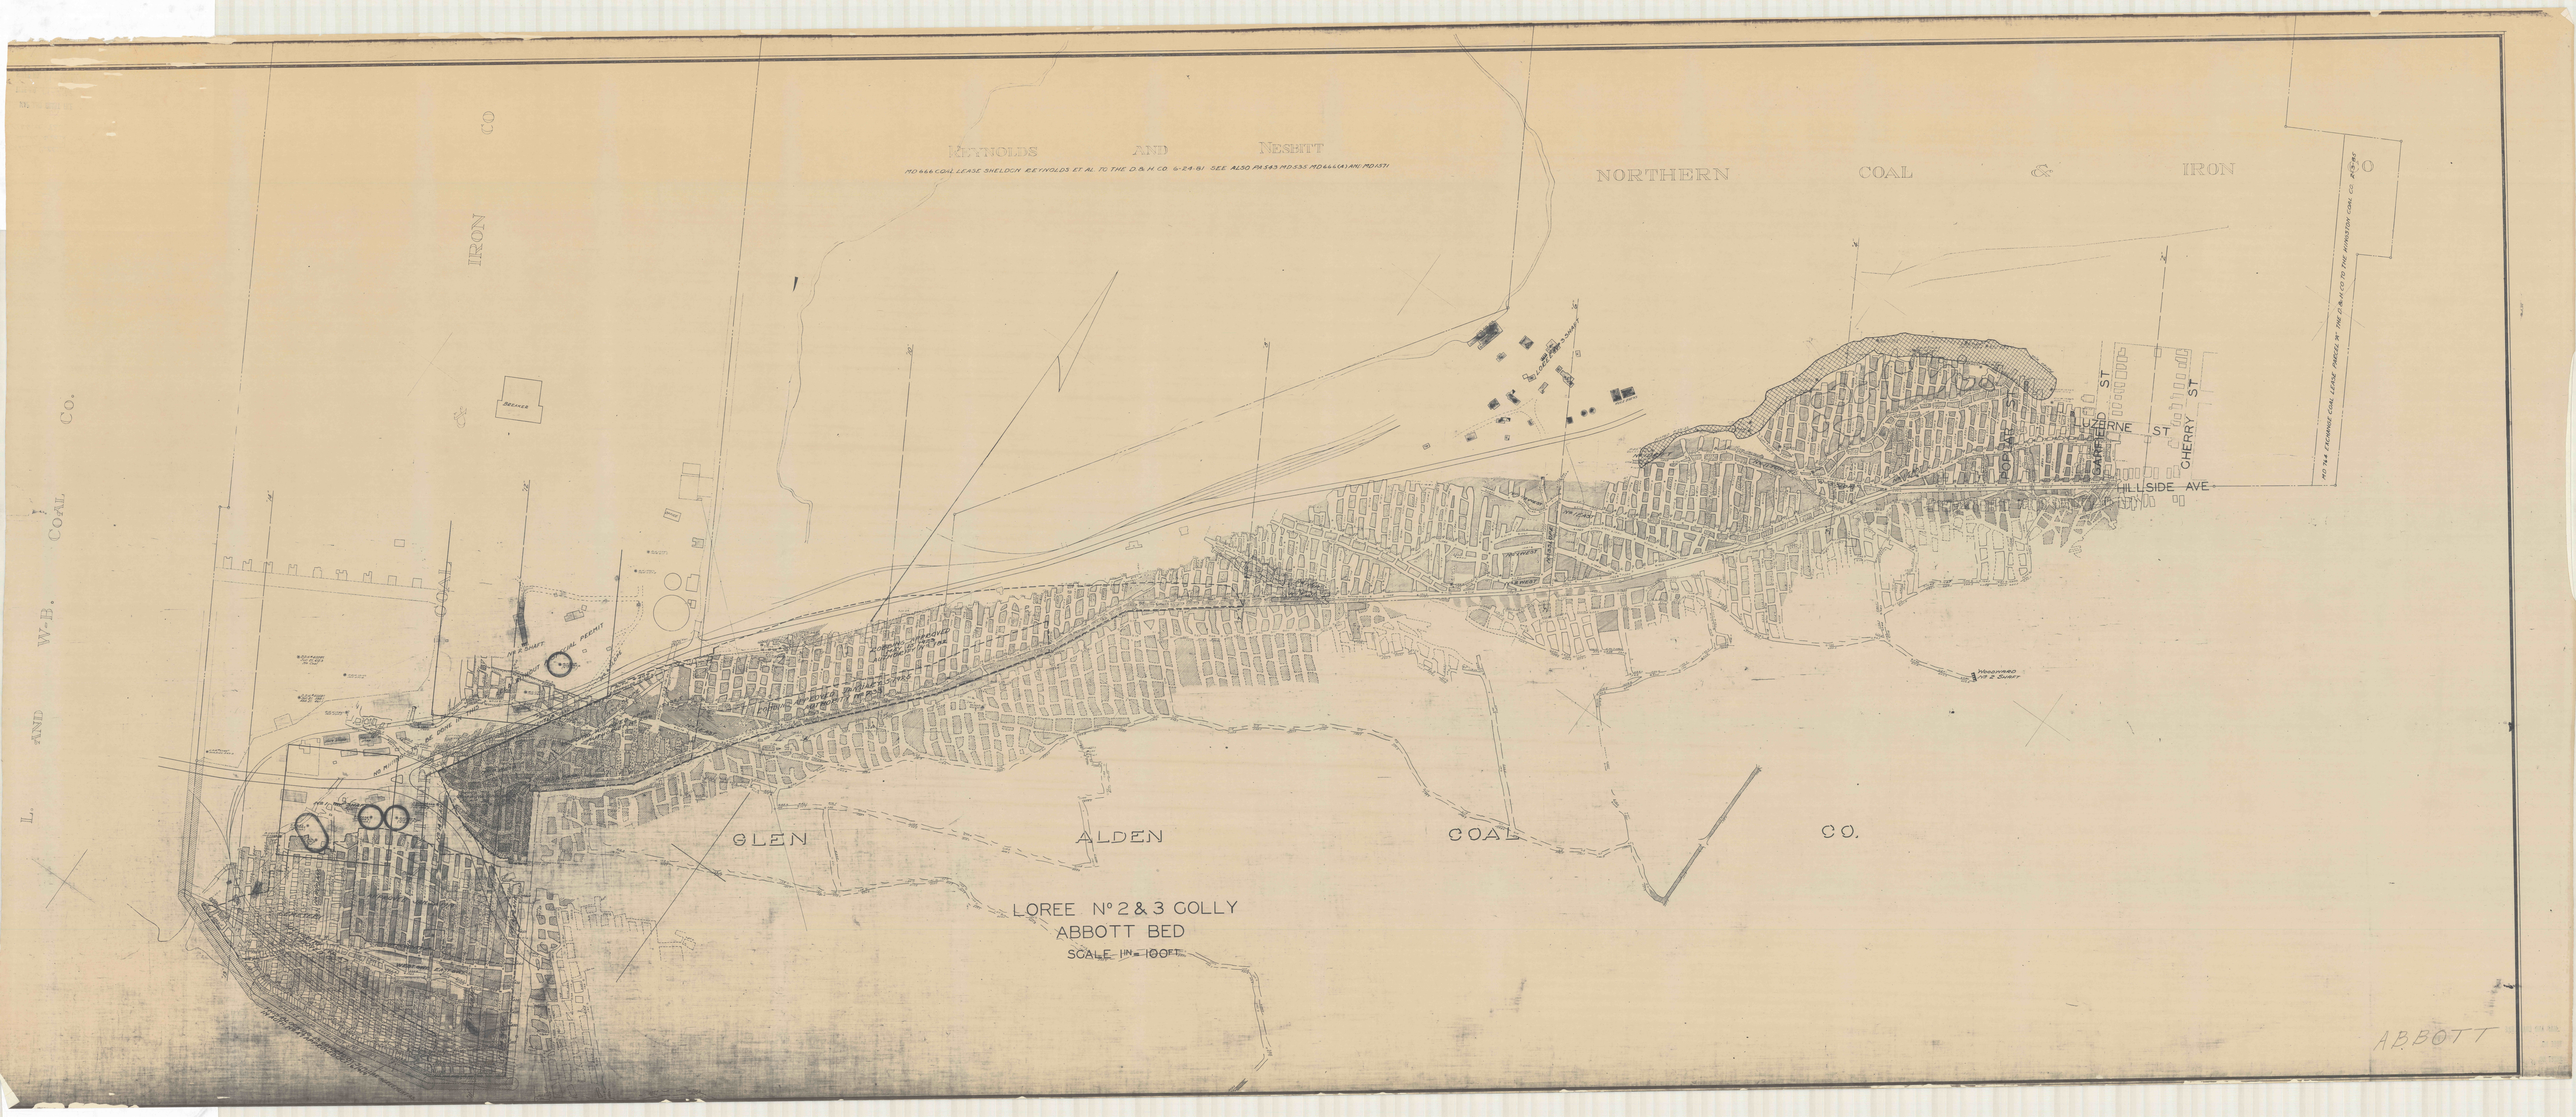
REYNOLDS AND NESHIT
MD 66 & L COAL LEASE SHELDON REYNOLDS ET AL TO THE D. & H. CO. 6-24-81 SEE ALSO PA 343 MD 535 MD 66 & L (A) AND MD 1371
NORTHERN COAL & IRON CO
IRON CO
L. AND W.B. COAL CO.
GLEN ALDEN COAL CO.
POPLAR ST
CARFIELD ST
LAURINE ST
CHERRY ST
HILLSIDE AVE
LOREE N° 2 & 3 COLLY
ABBOTT BED
SCALE IN = 100 FT.
ABBOTT