


W 6000
51000

W 6000
0
0
0

NORTH

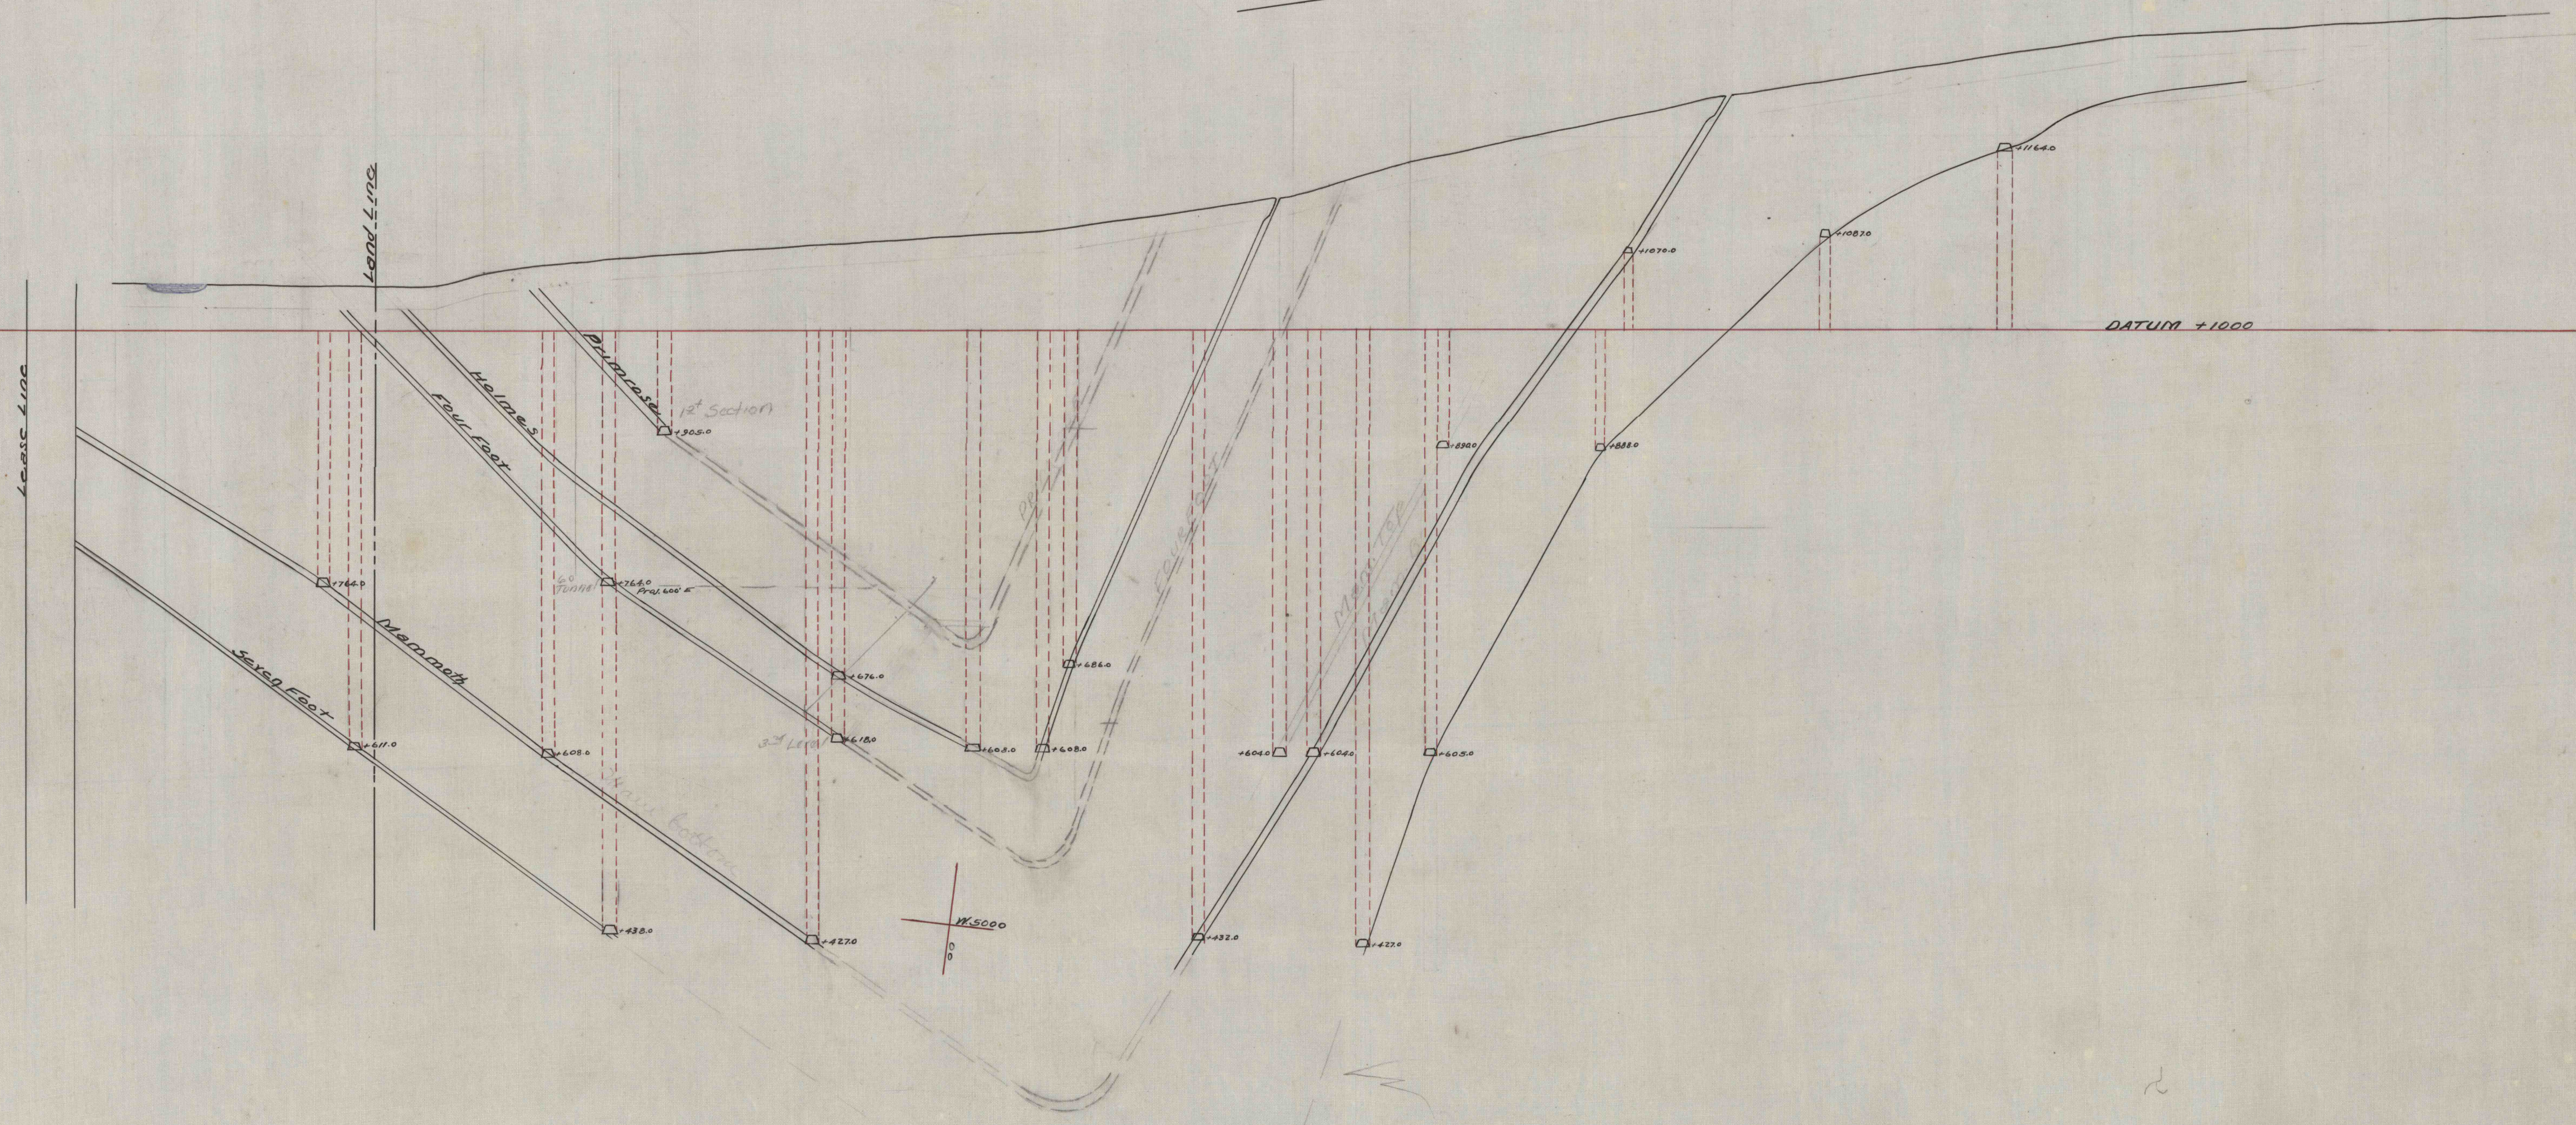

W 5000
51000

W 5000
0
0
0

CROSS SECTION
SIOUX NO 3 COLLIERY
850 FT WEST OF SLOPE

Eng. Dept. L. M. H. DIV. L. V. C. Co.
Scale 100' = 1" Centrolino, Pa.
Dec. 1920