


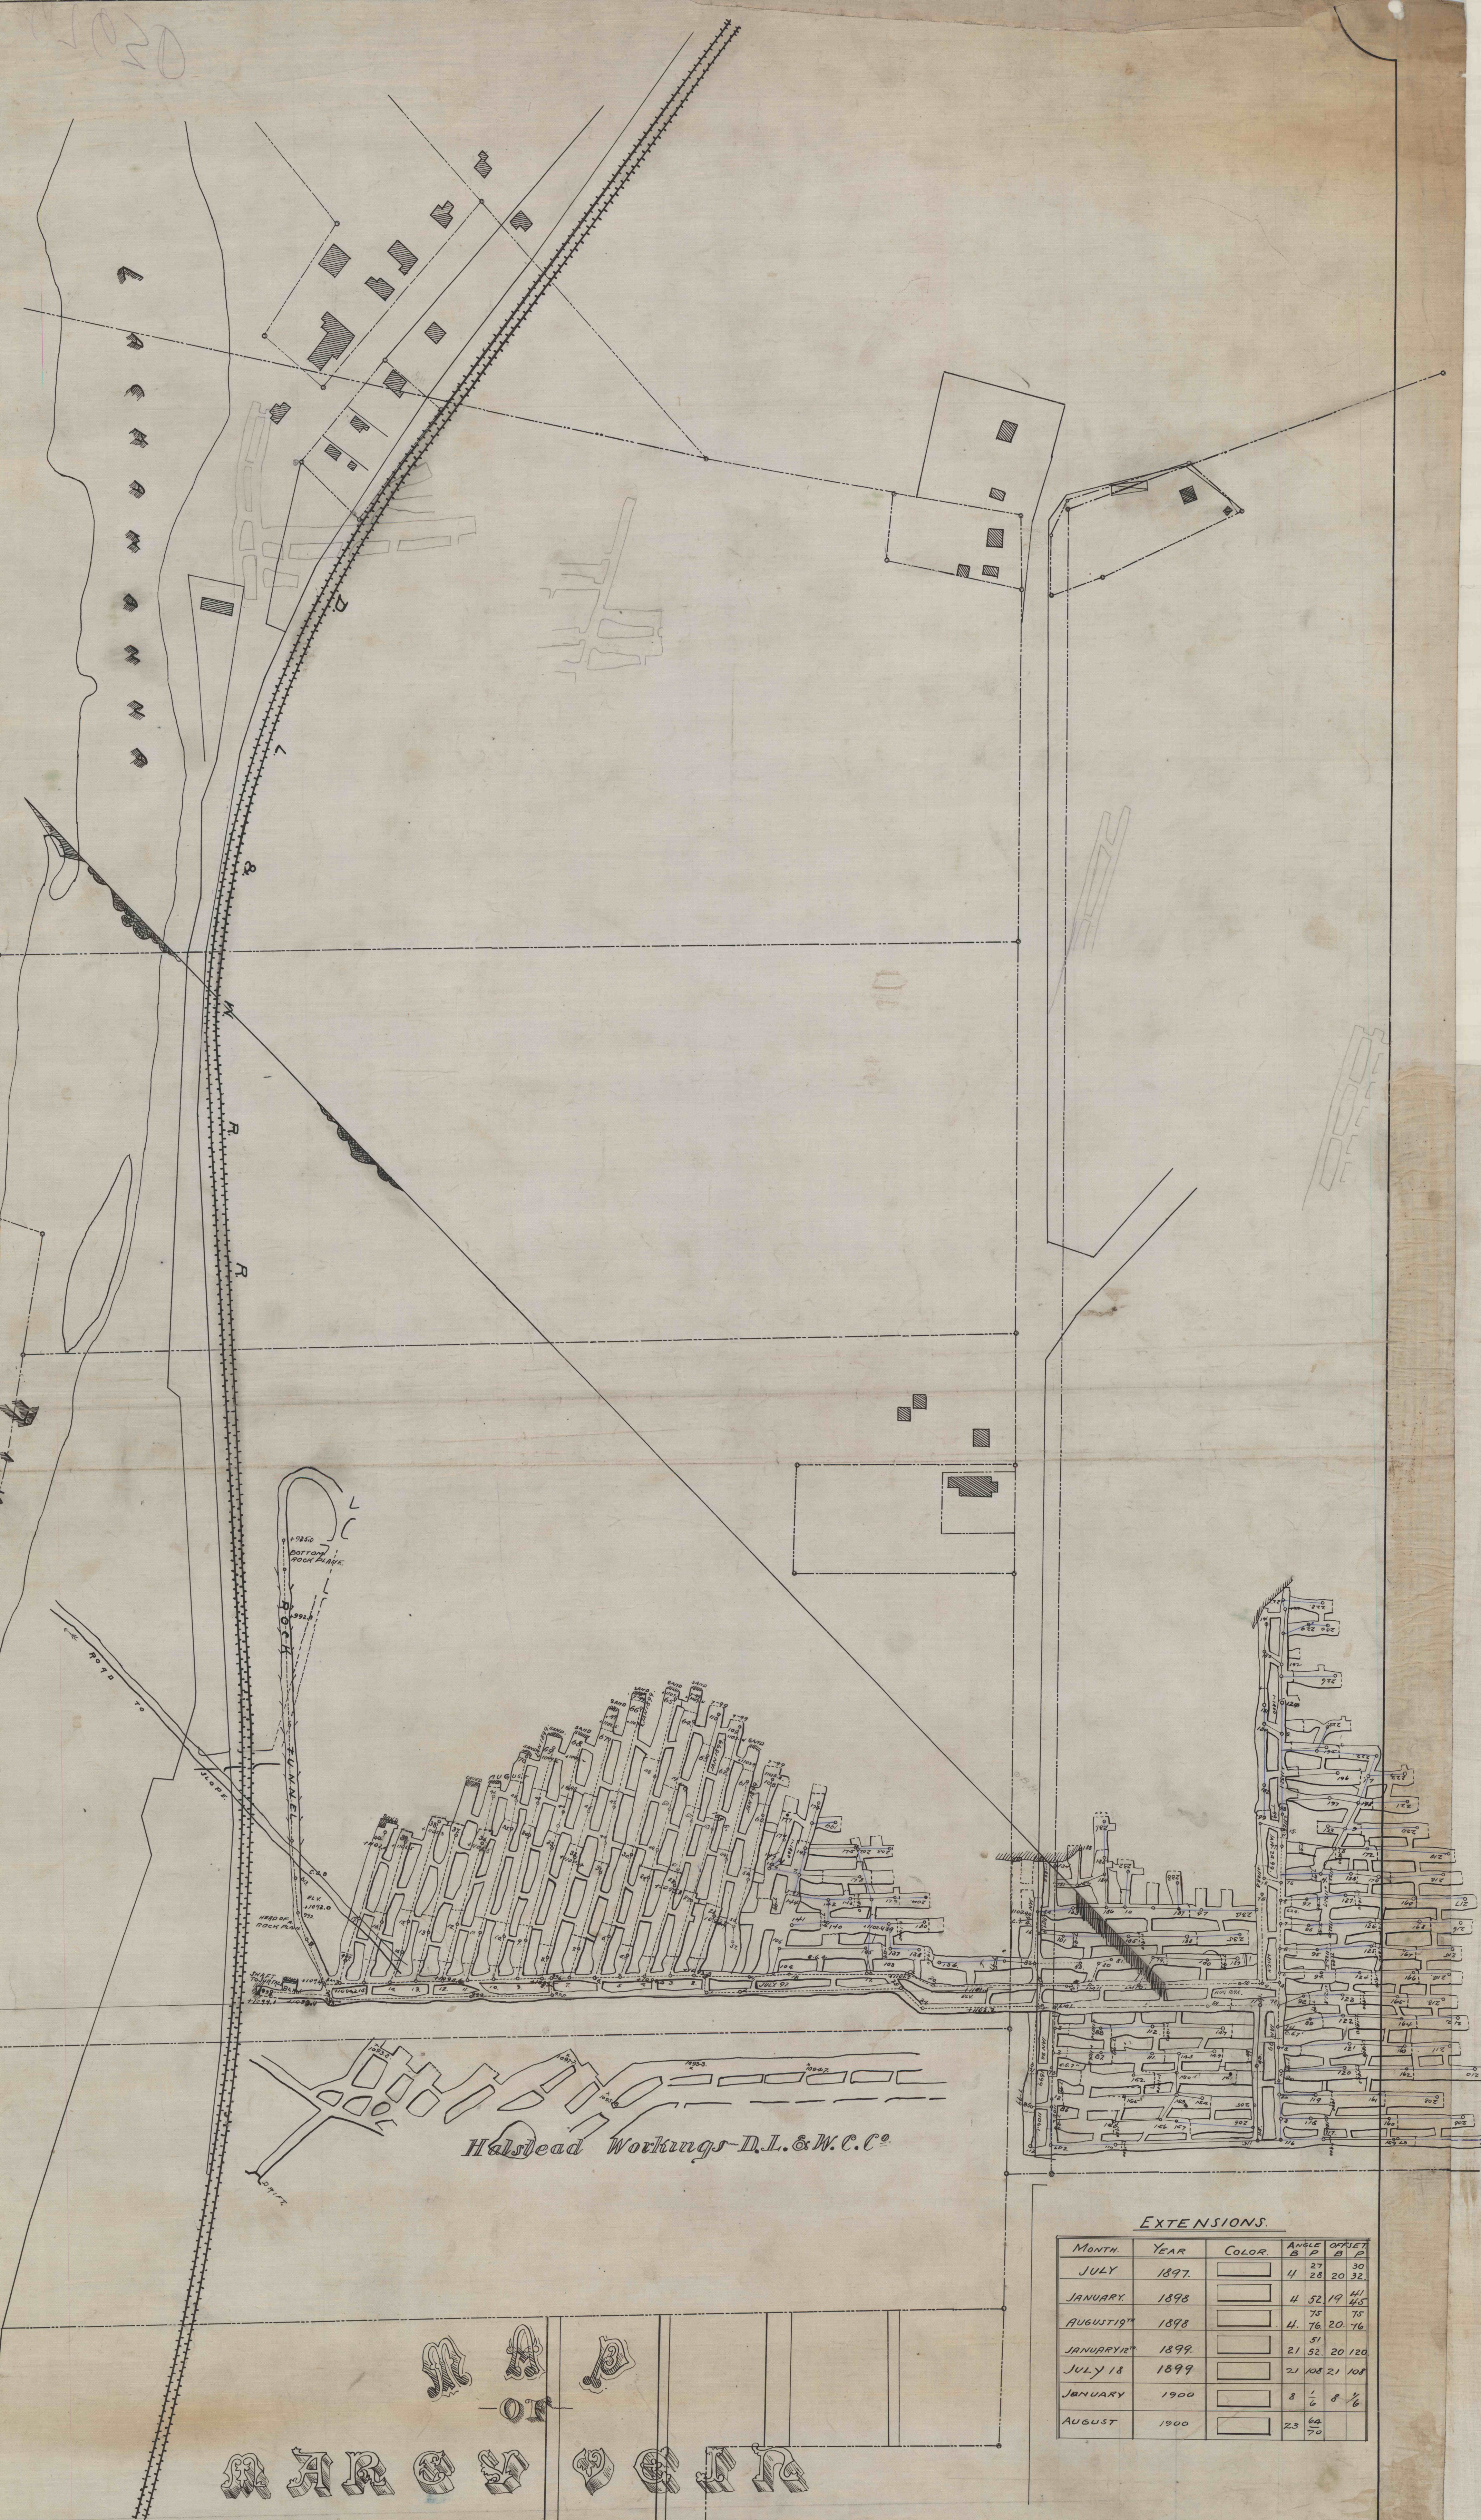

Halstead Workings D.L. & W.C.C.

MARSH PETER  
WM. A. COLLIERY

EXTENSIONS.

| MONTH   | YEAR | COLOR | ANGLE<br>B P | ORIENT<br>B P |
|---------|------|-------|--------------|---------------|
| JULY    | 1897 |       | 4 27         | 30            |
| JANUARY | 1898 |       | 4 52 19      | 41 145        |
| AUGUST  | 1898 |       | 4 76 20      | 70            |
| JANUARY | 1899 |       | 21 51        | 20 120        |
| JULY    | 1899 |       | 21 108 21    | 108           |
| JANUARY | 1900 |       | 8 6          | 8 1/6         |
| AUGUST  | 1900 |       | 23 60 70     |               |

SCALE 1"=100 FT