


25-176

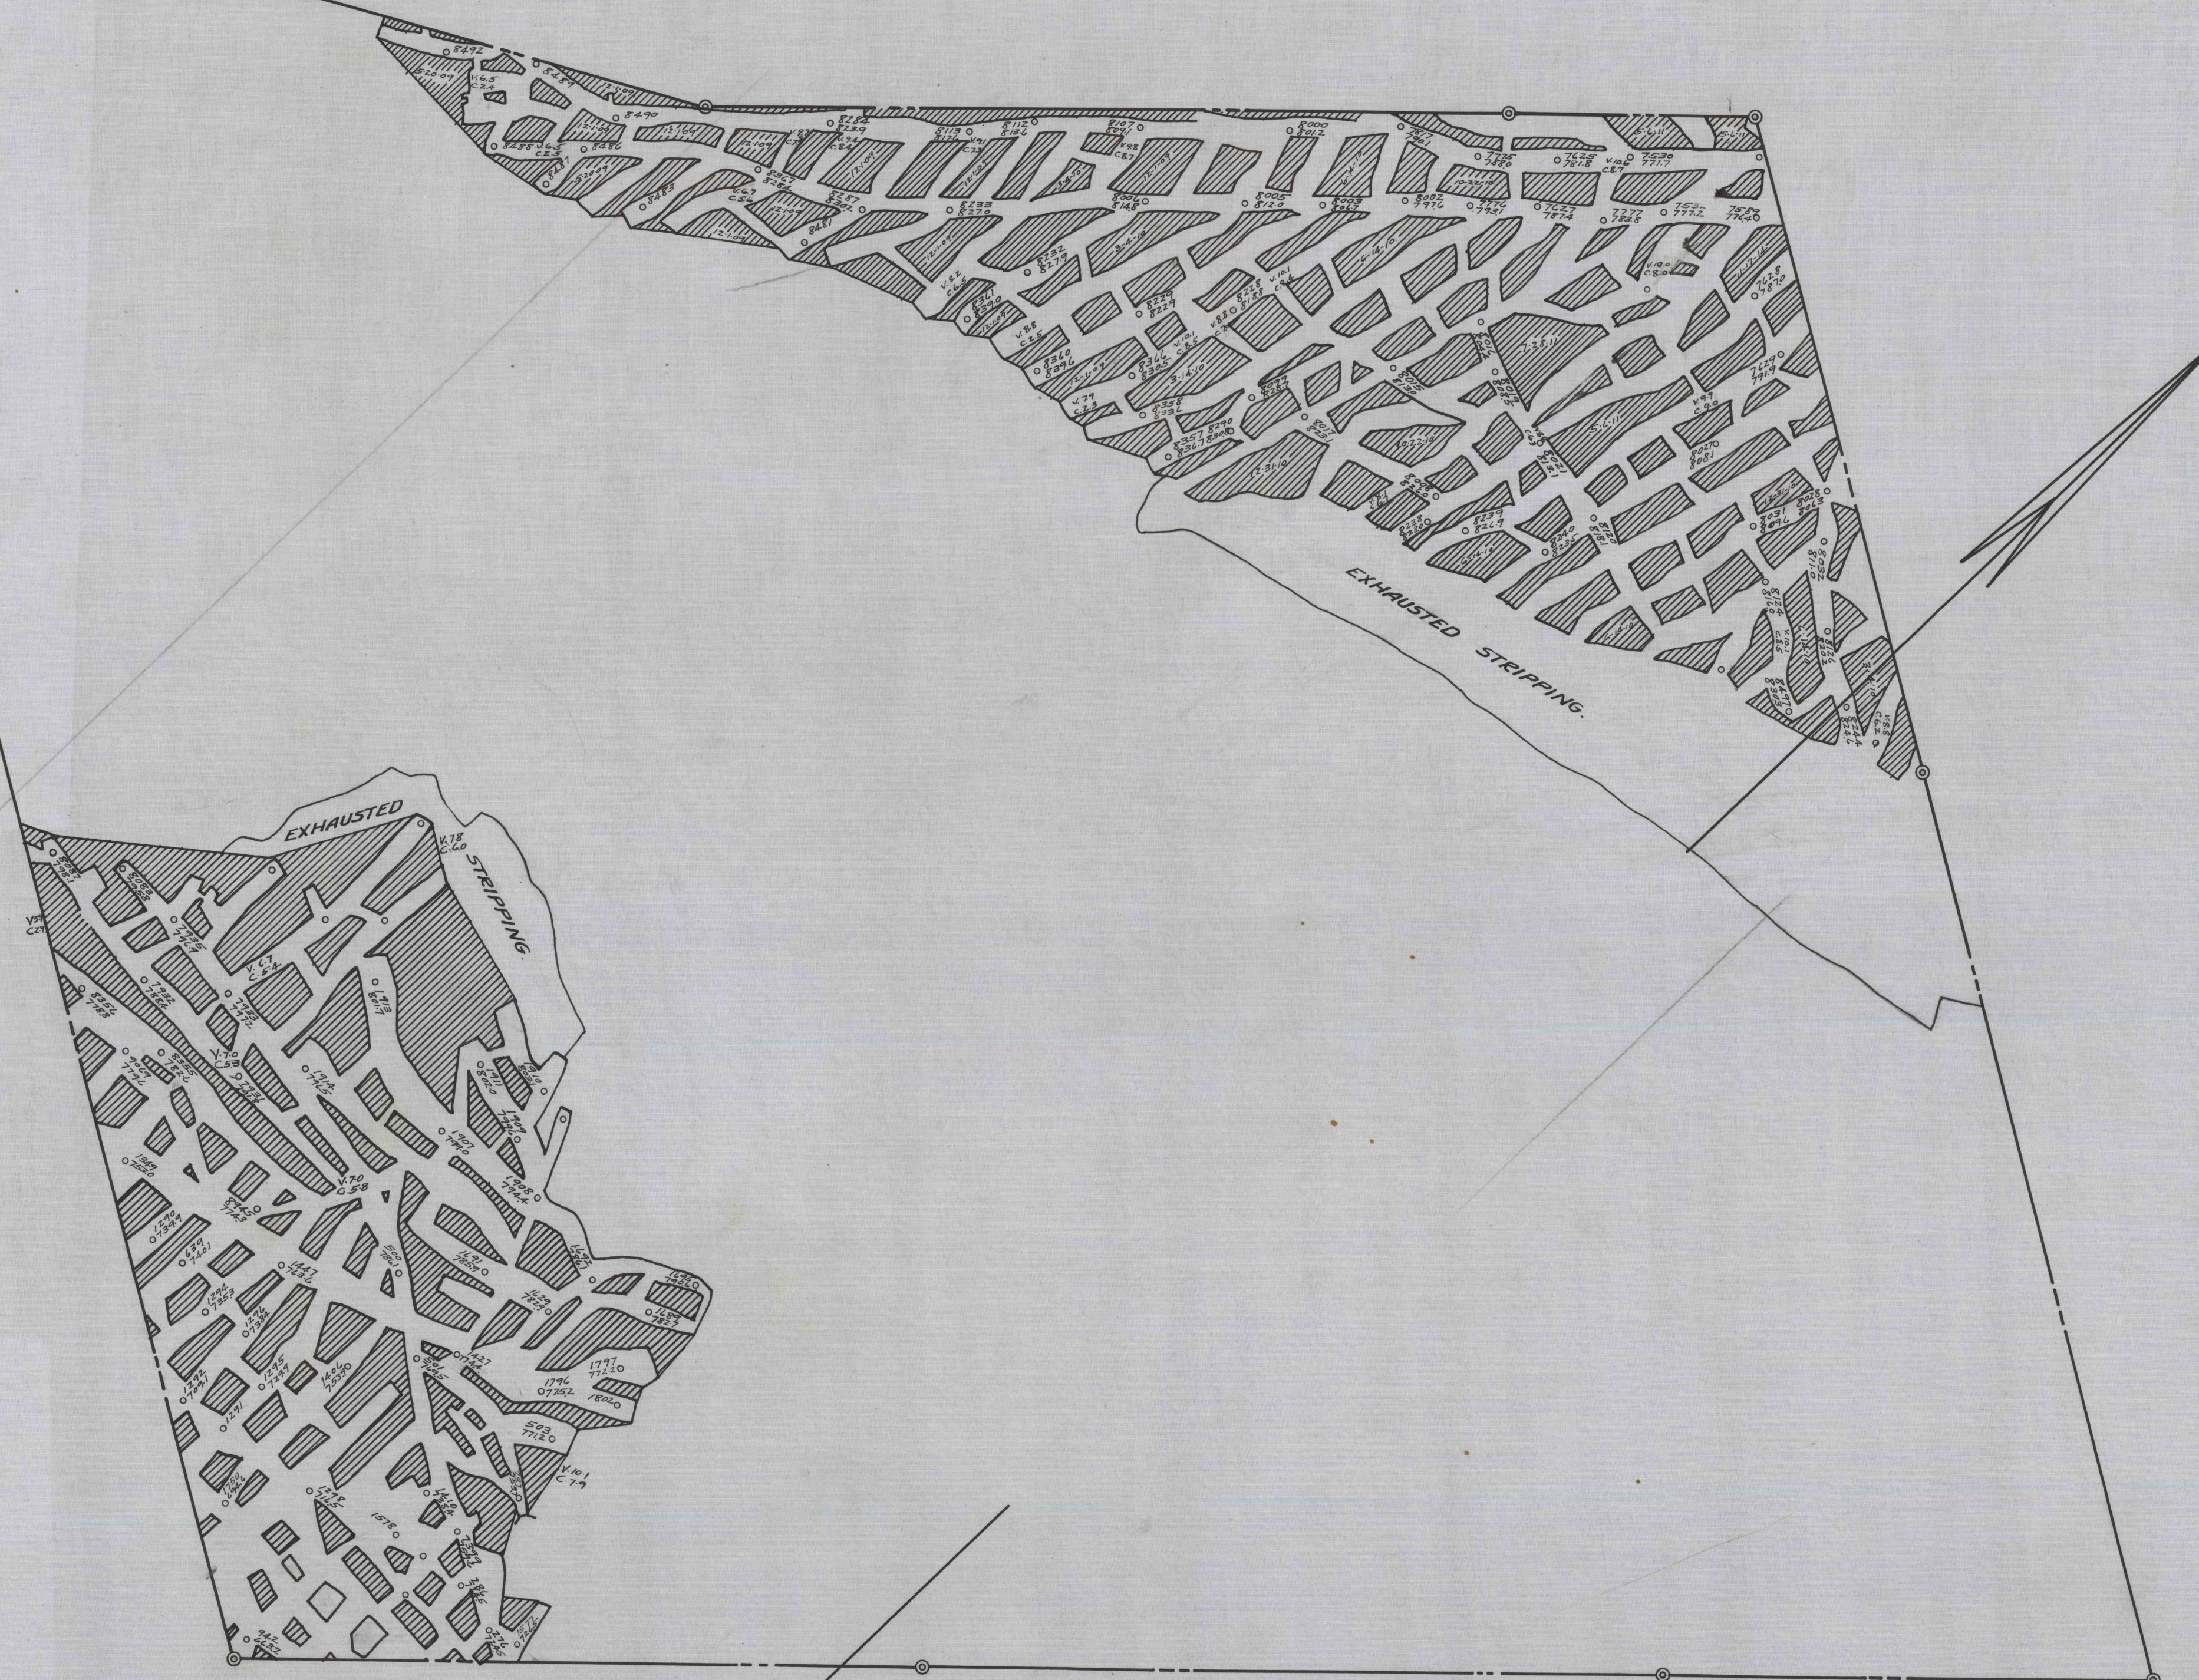

HEIDELBERG COLLIERY
R. SEARLE TRACT
MARCY VEIN WORKINGS
ACCORDING TO SURVEYS OF
THE L.V. COAL CO.
LACKA.DIV. L.V.C.CO. POSTED TO *June 1 1927*
SCALE 1"=100' DATUM=TIDE

25-176