

0150

Put on top of

Top Marcy


Area = 28846

● BH 210
Top Marcy



Thin Coal

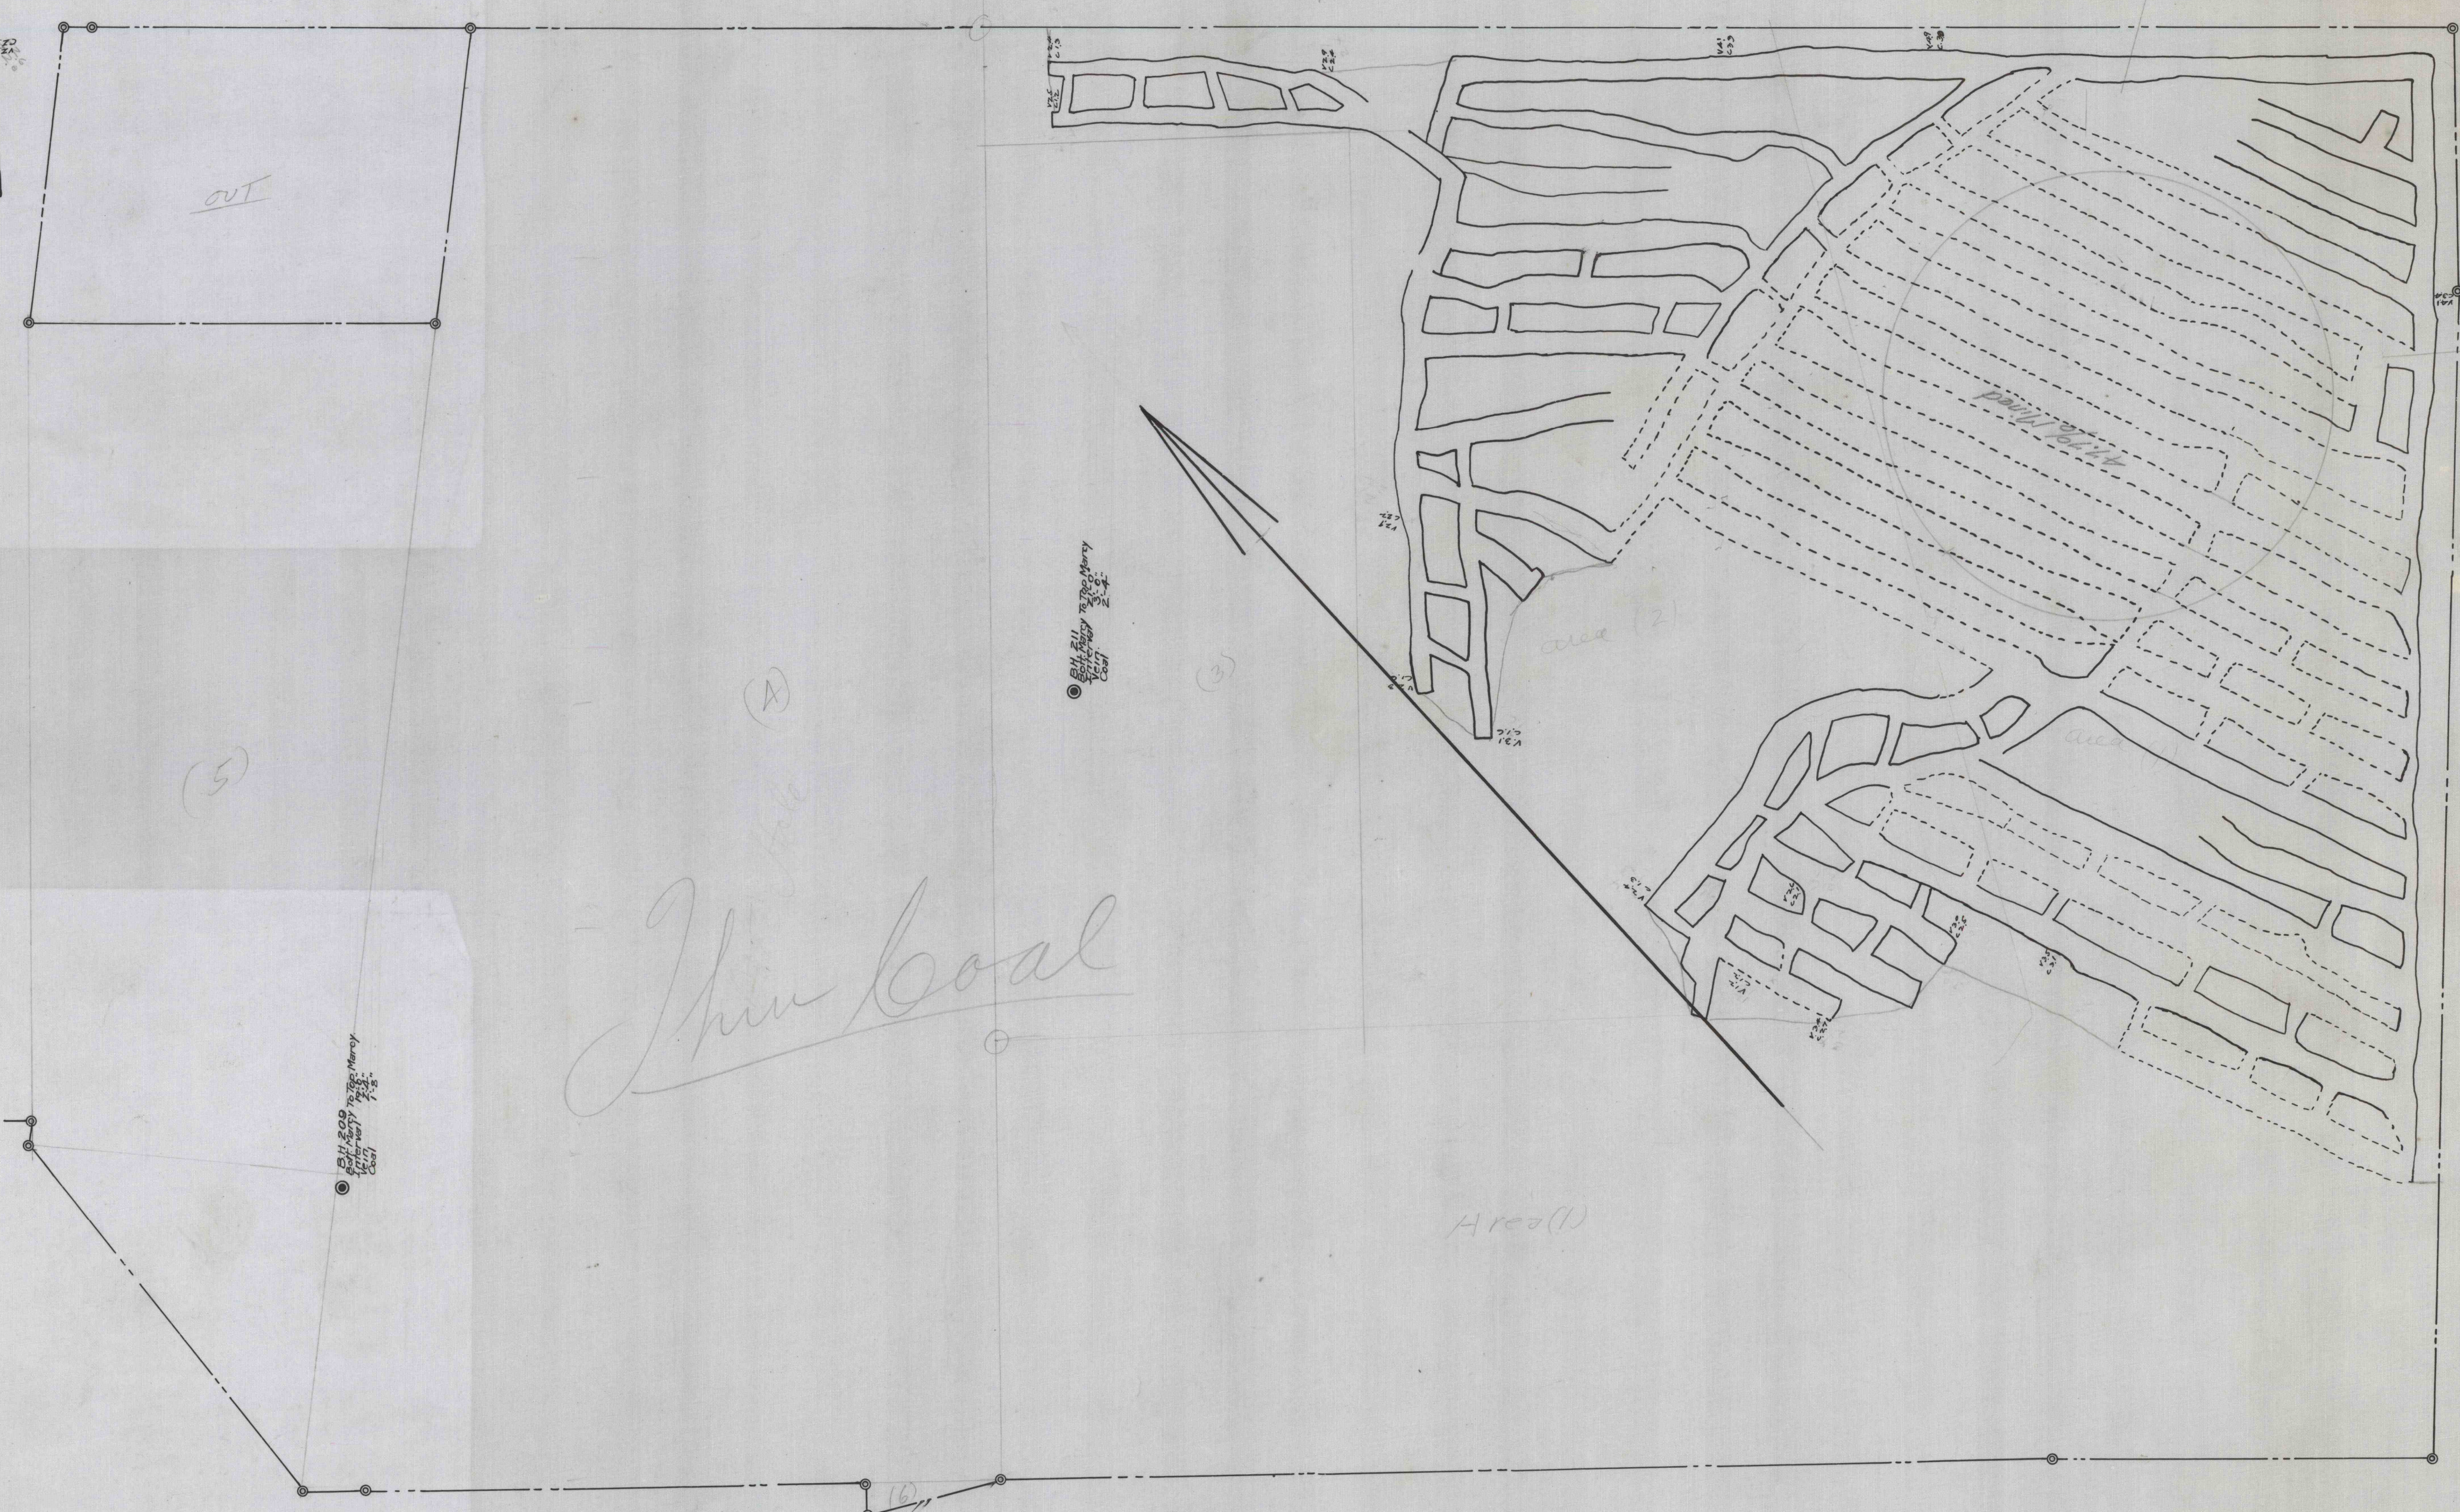

SENECA COLLIERY
TOP MARCY VEIN
CHURCH HILL TRACT
SCALE 1"=100' OCT. 1, 1910