




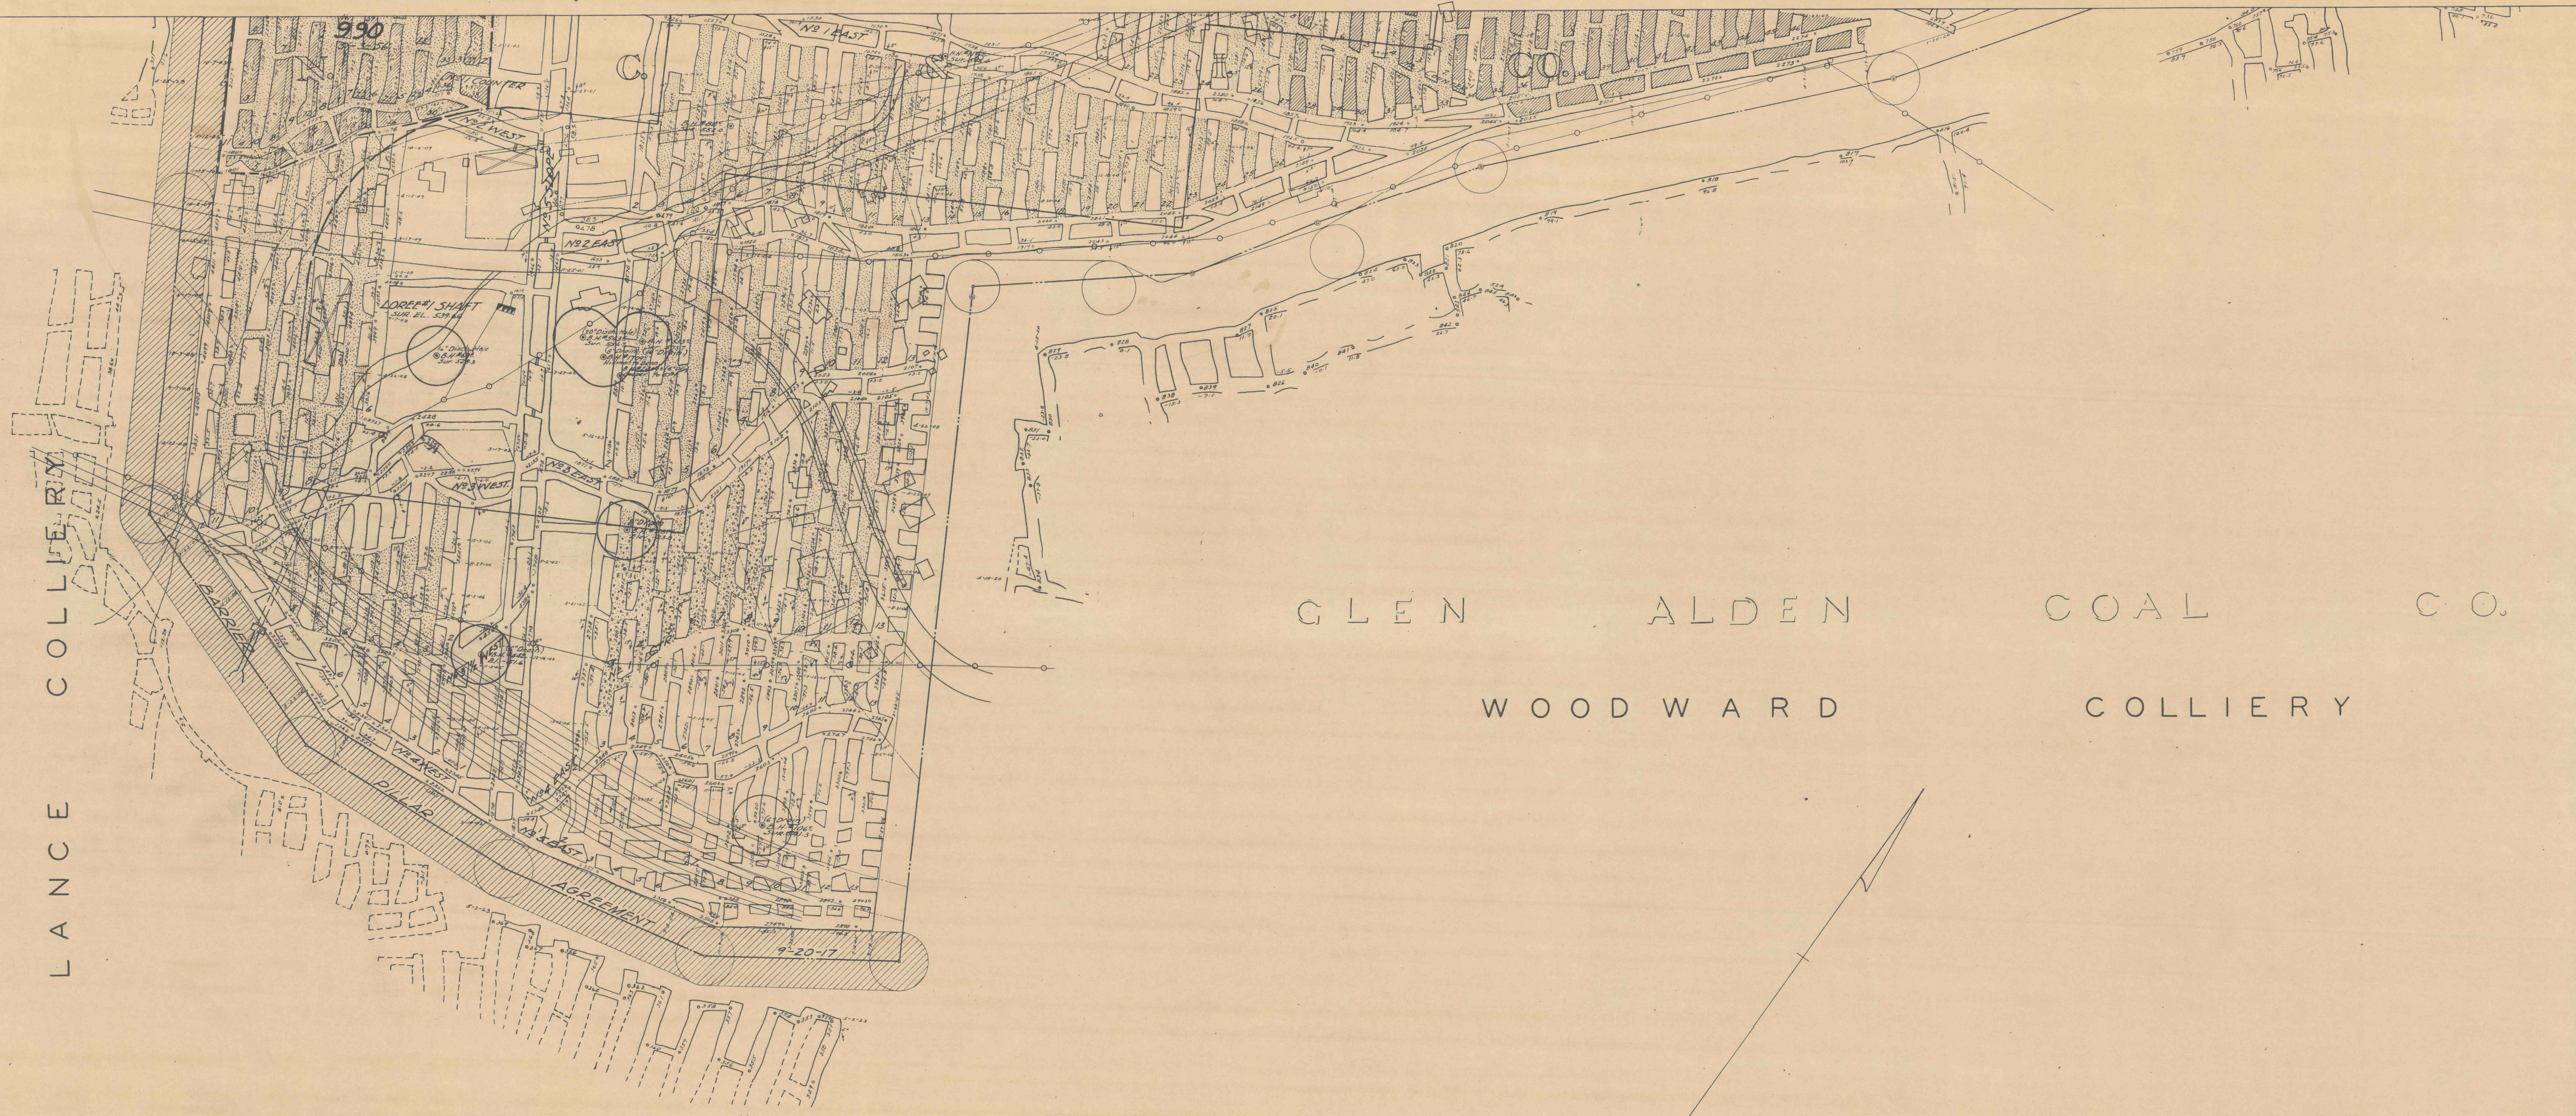

G L E N A L D E N C O A L C O.
W O O D W A R D C O L L I E R Y