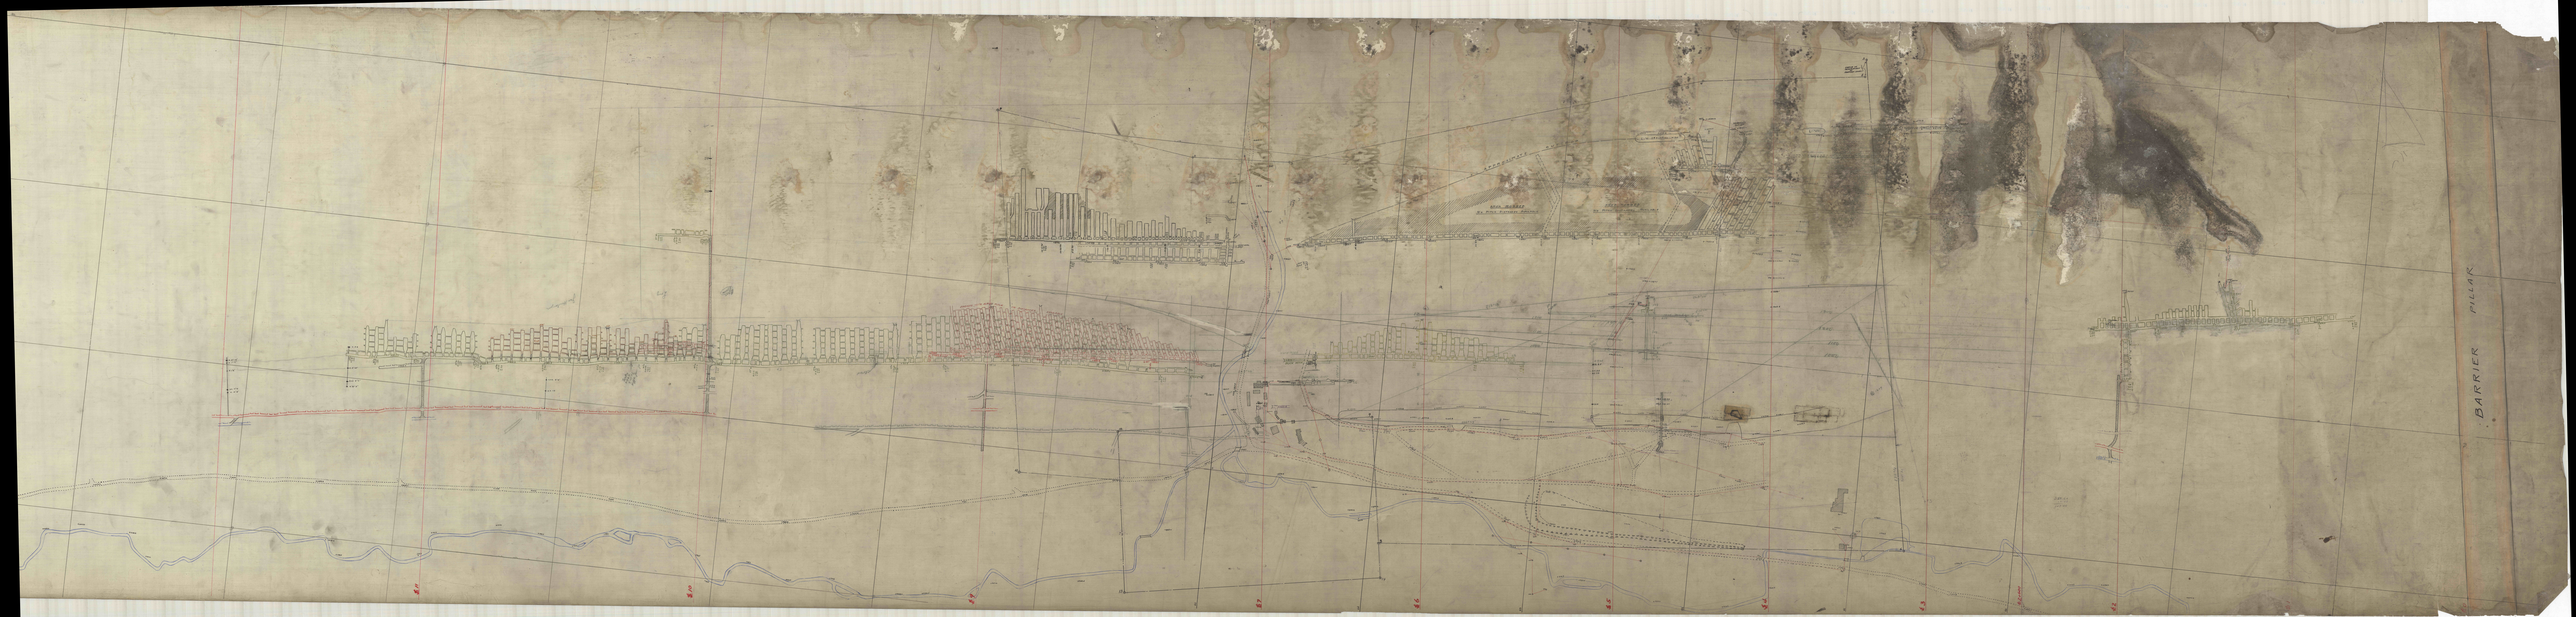

BARRIER PILLAR