


1000
1100
1200

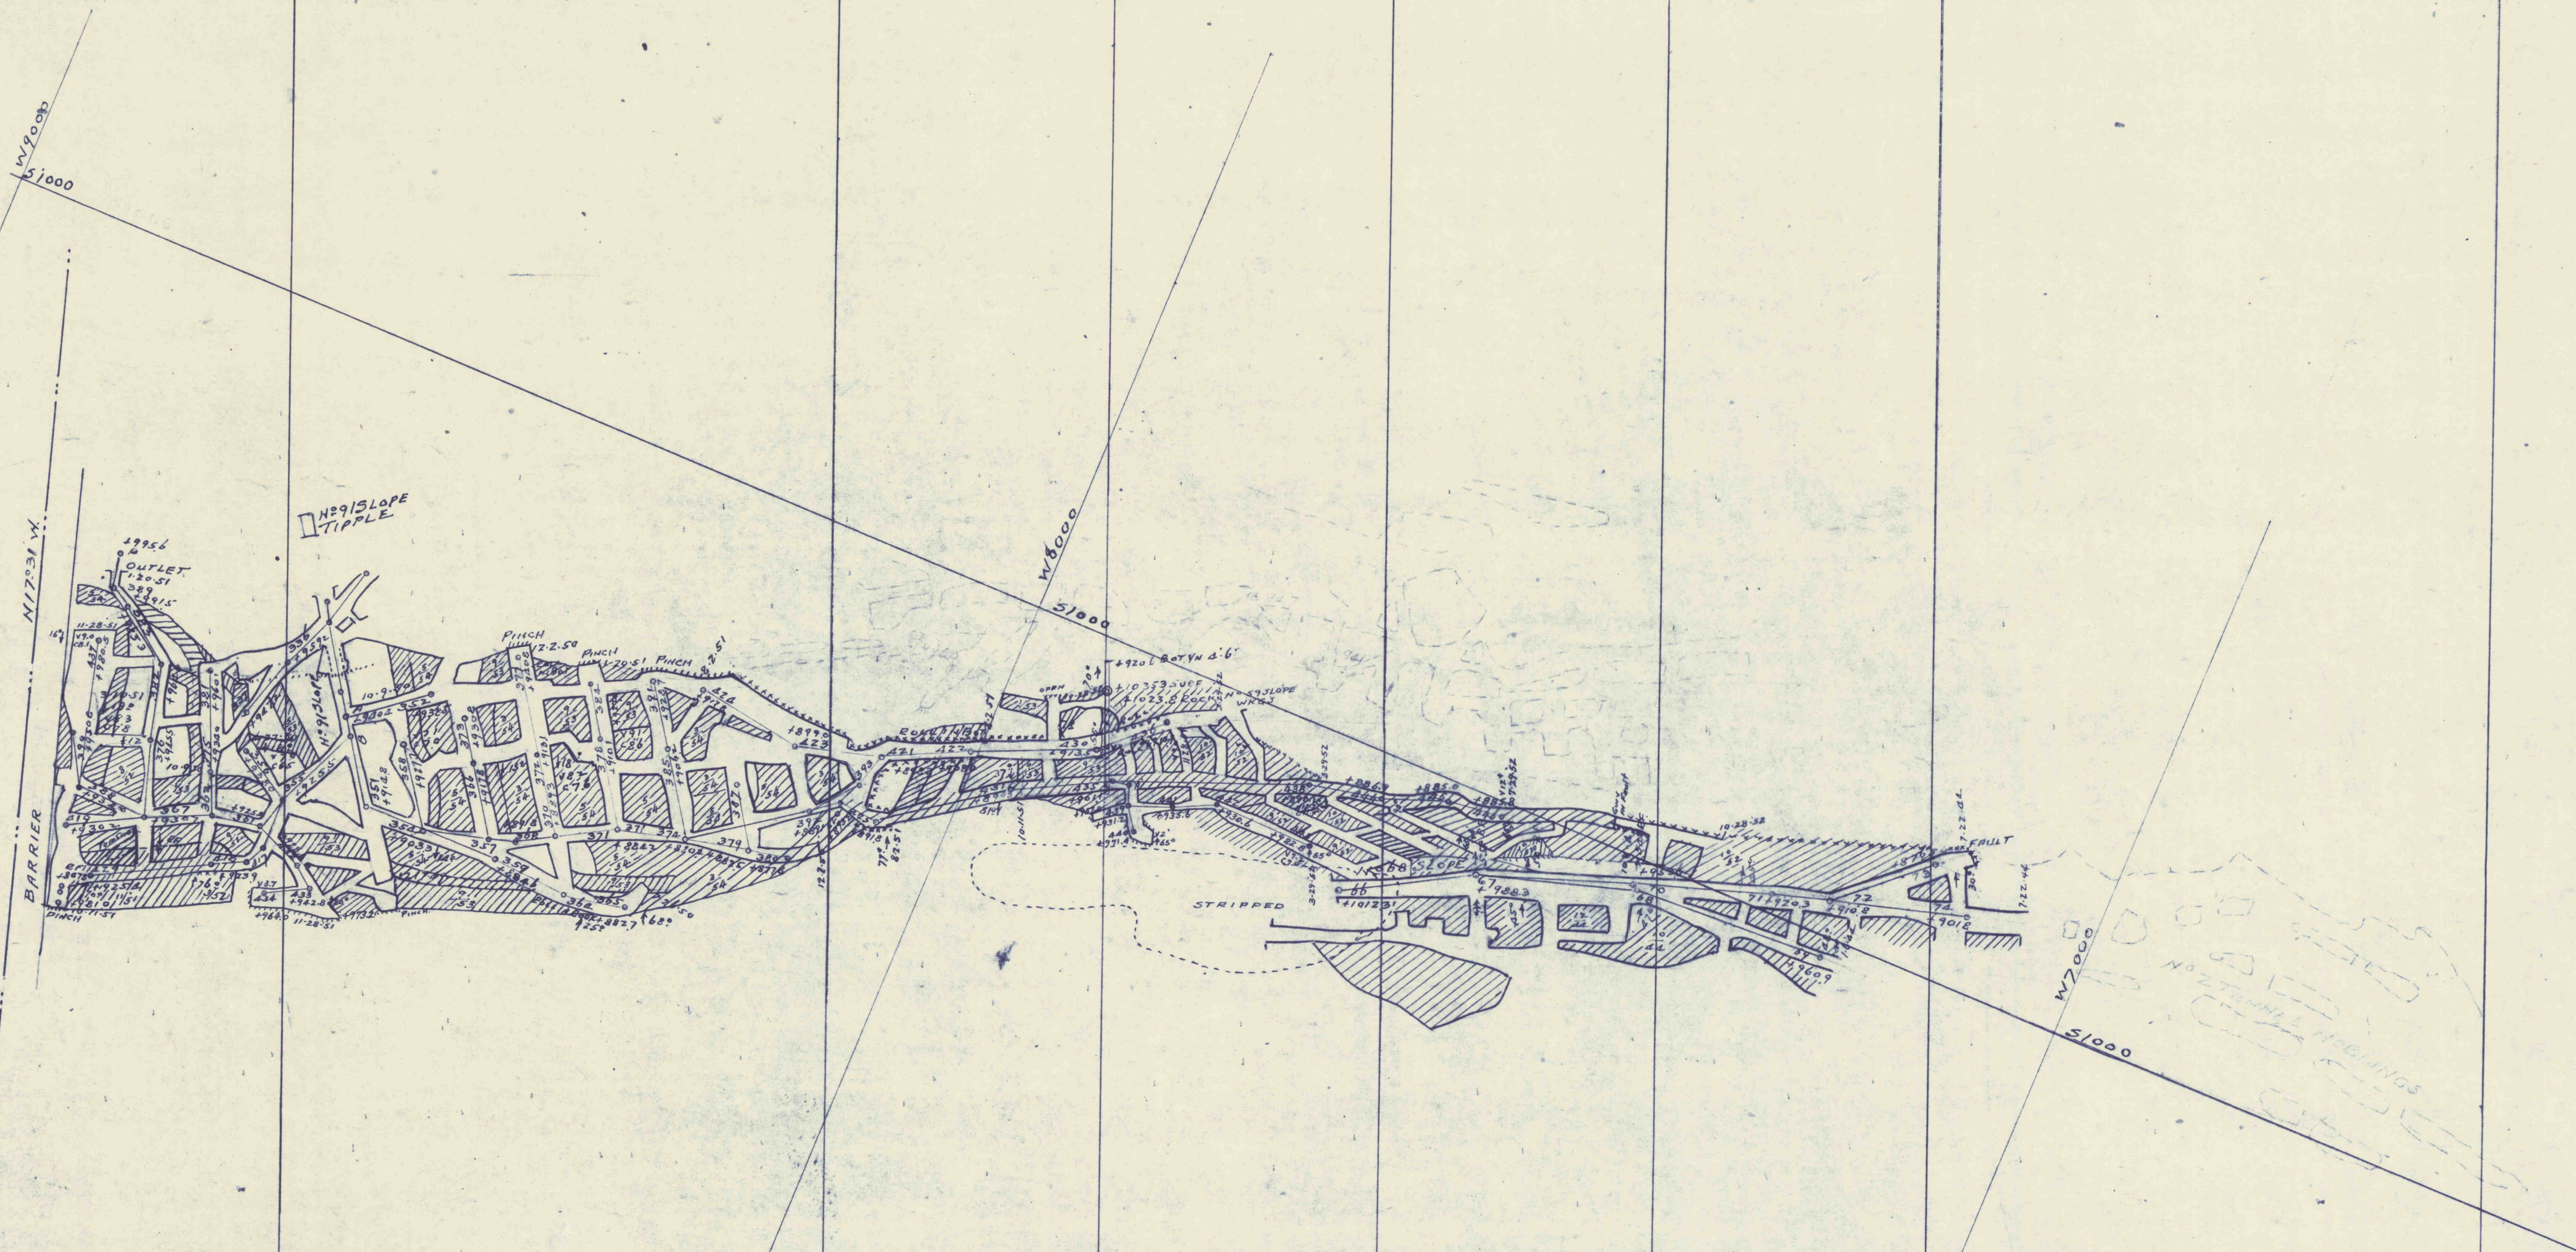

10.91 SLOPE
LEE






