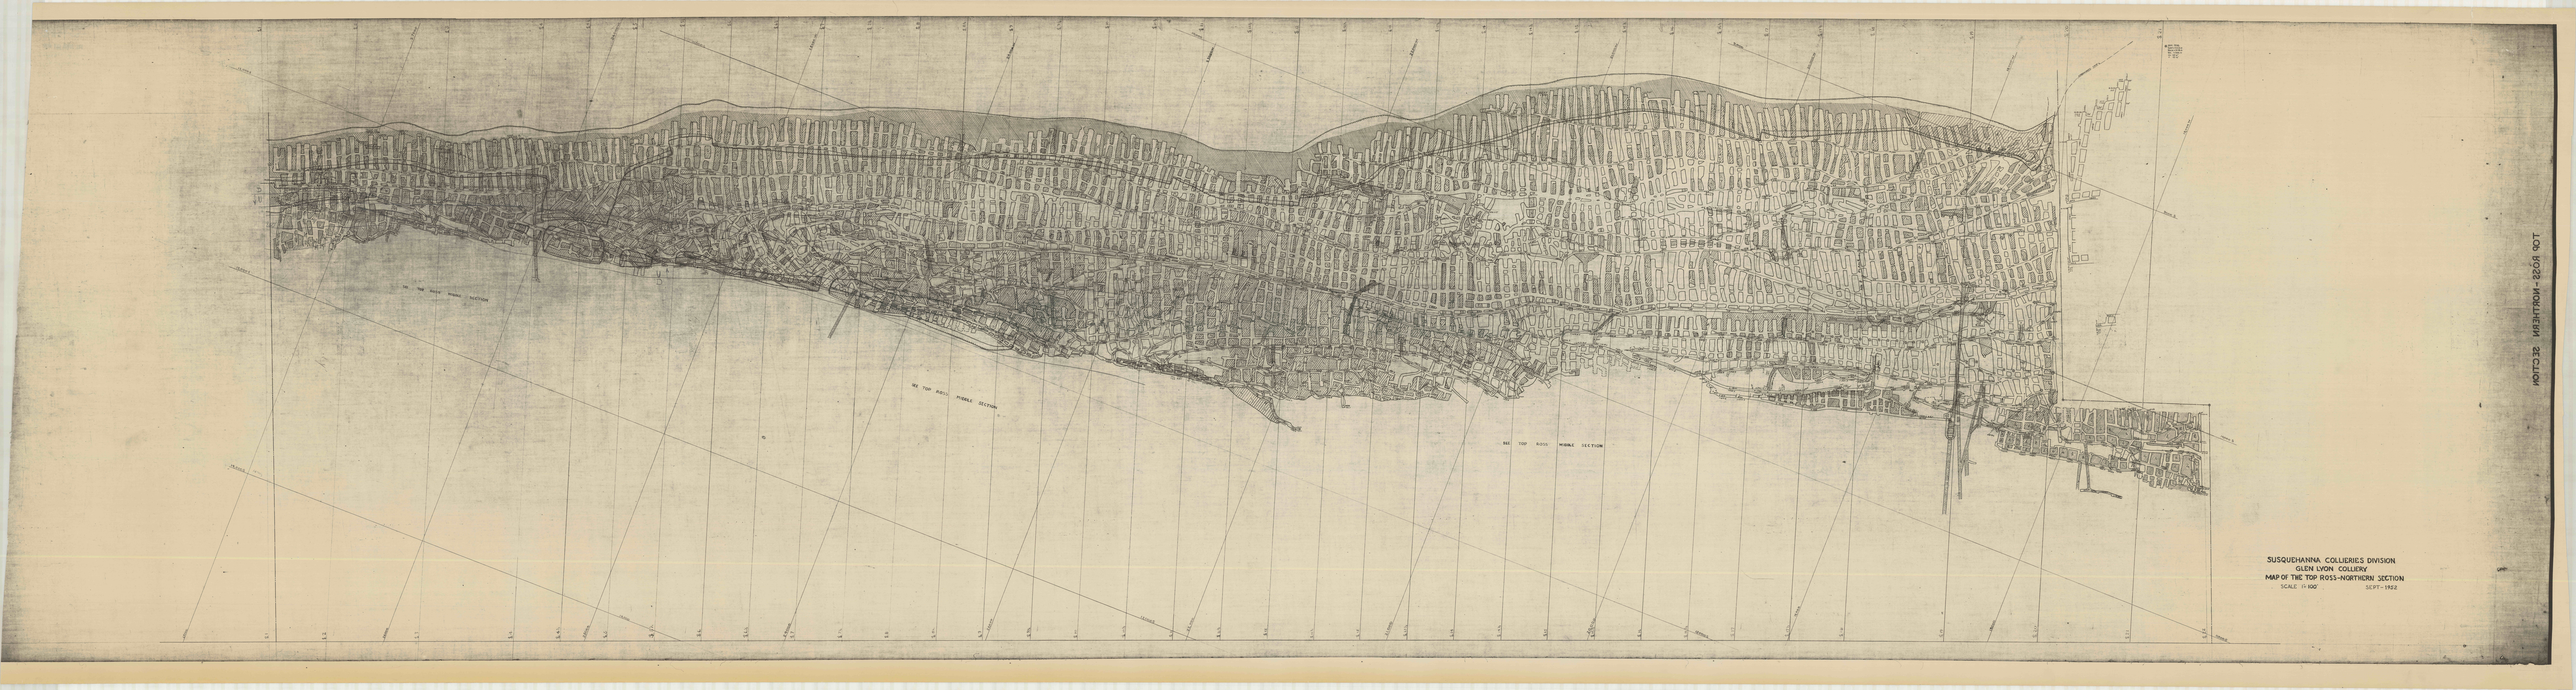


SUSQUEHANNA COLLIERIES DIVISION
GLEN LYON COLLIERY
MAP OF THE TOP ROSS-NORTHERN SECTION
SCALE 1"=100' SEPT. 1922