


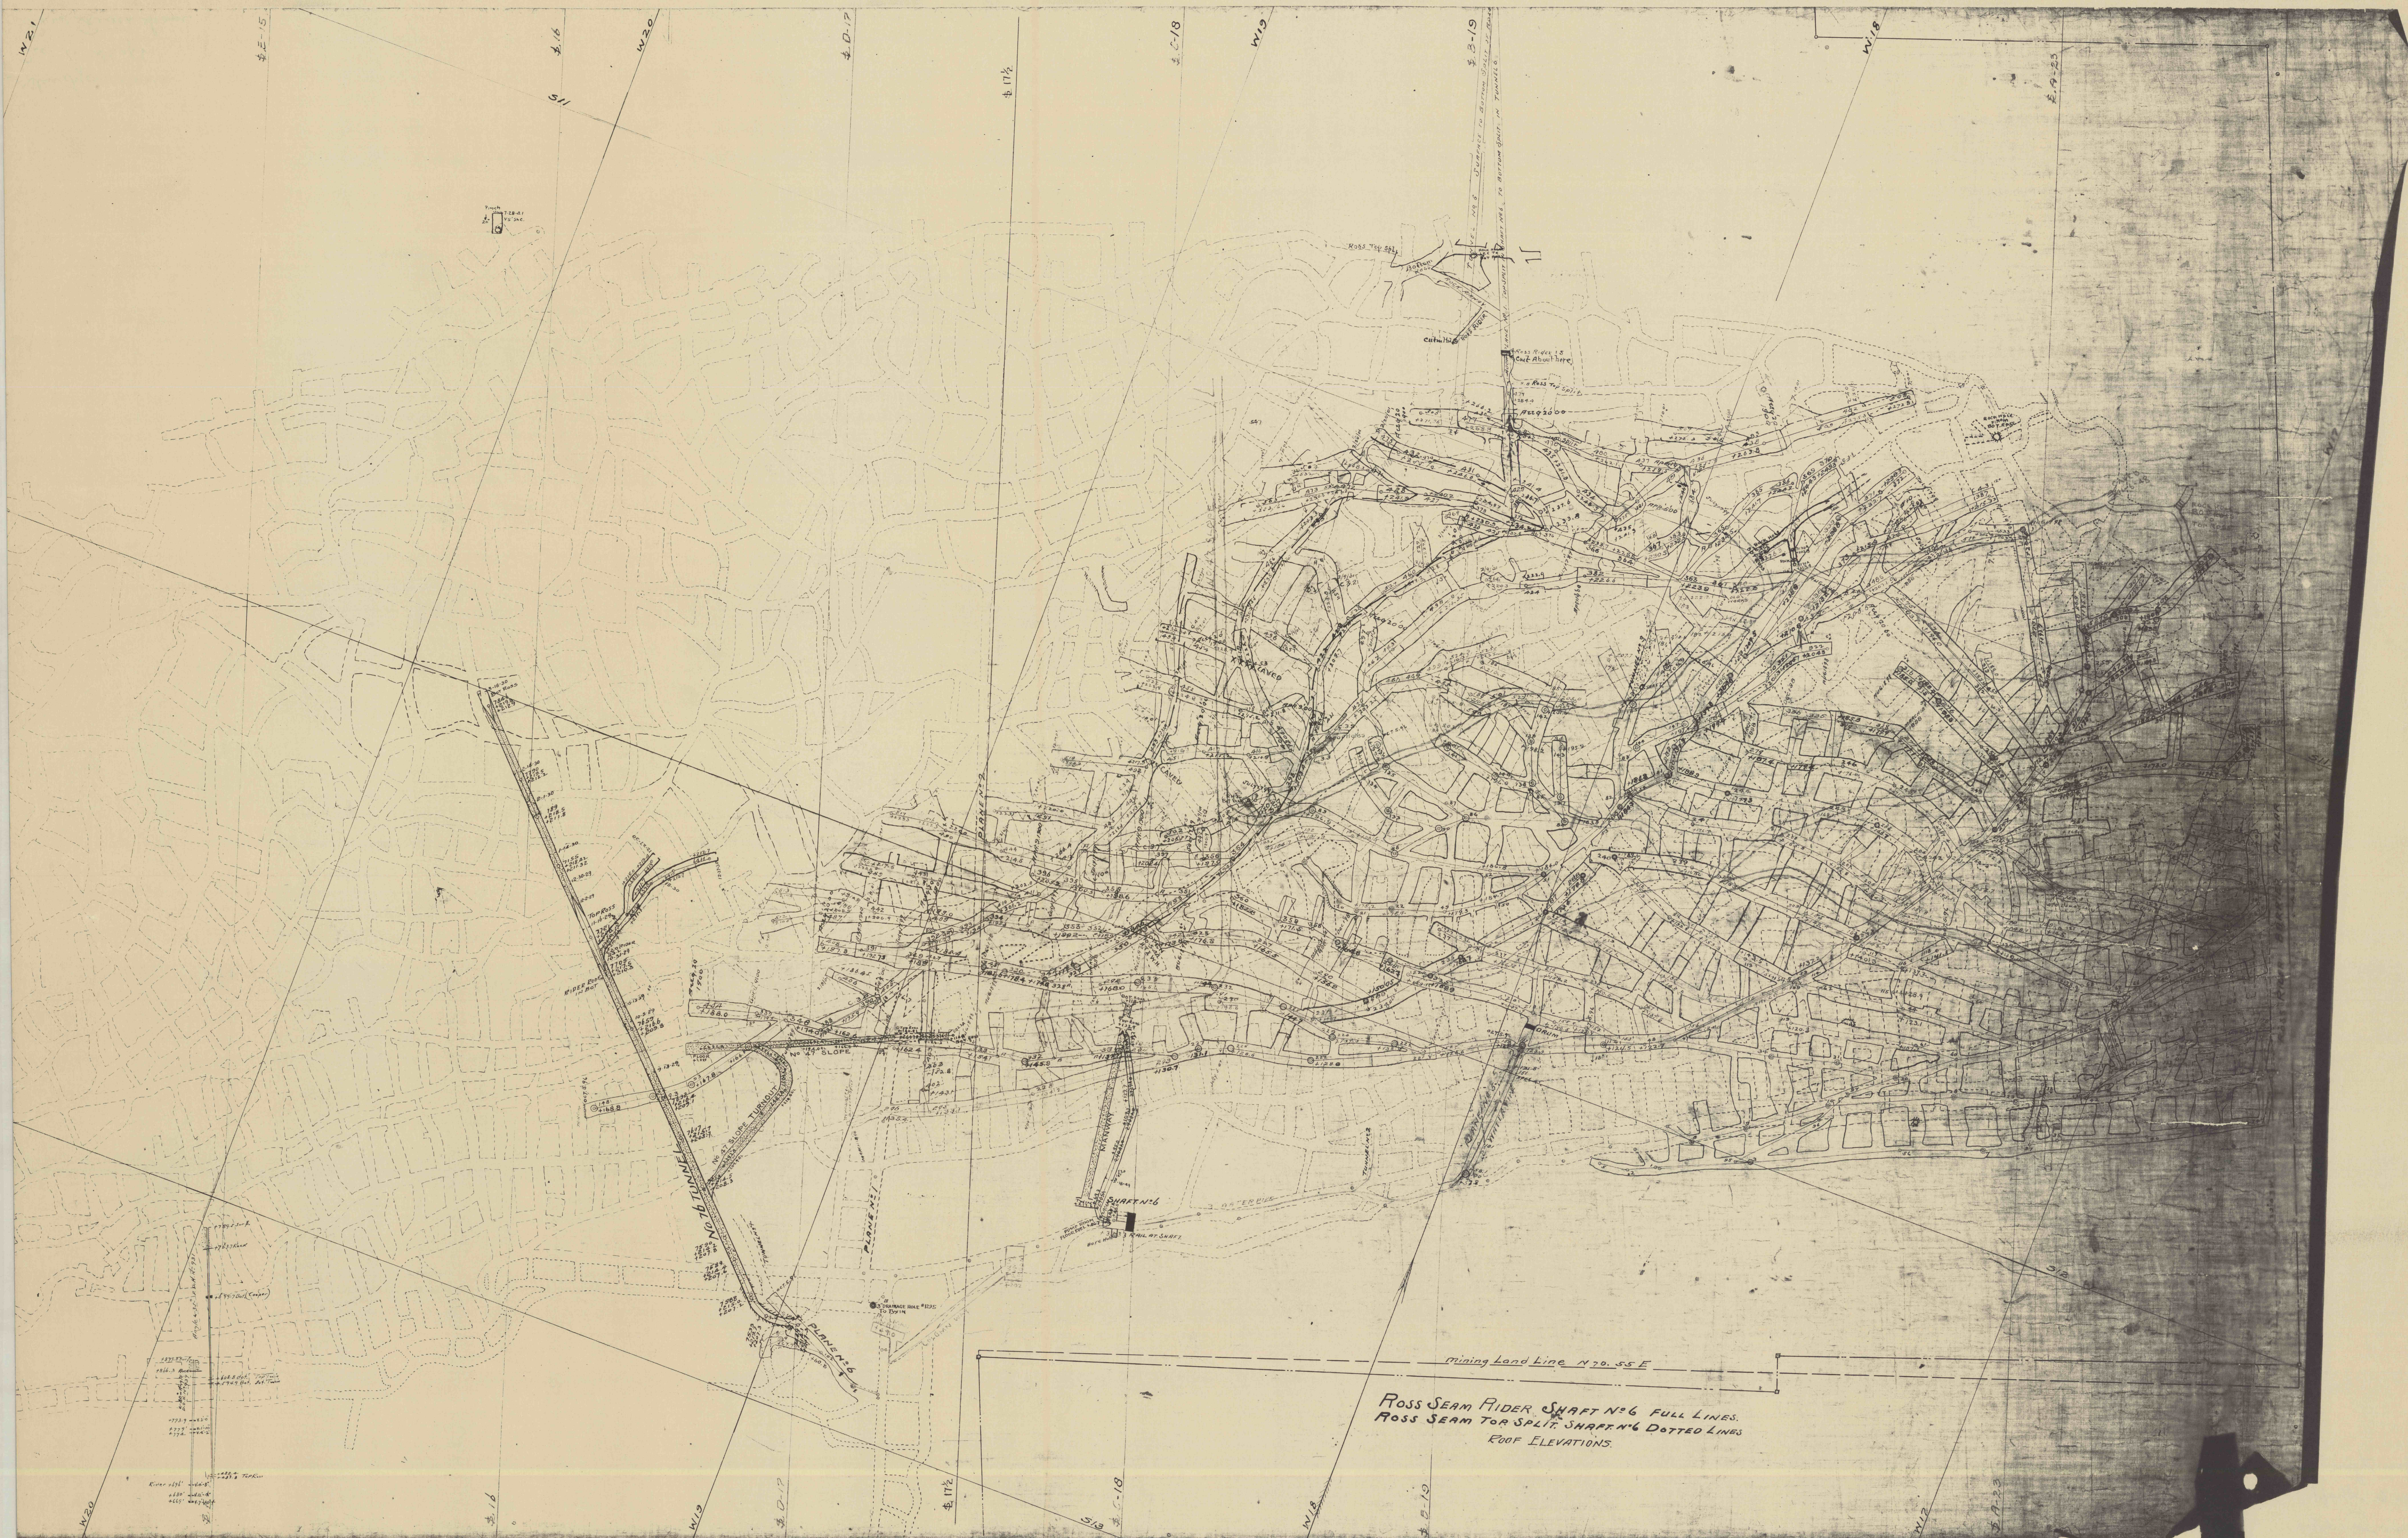

ROSS SEAM RIDER SHAFT N°6 FULL LINES.
ROSS SEAM TOR SPLIT SHAFT N°6 DOTTED LINES
ROOF ELEVATIONS.