


5

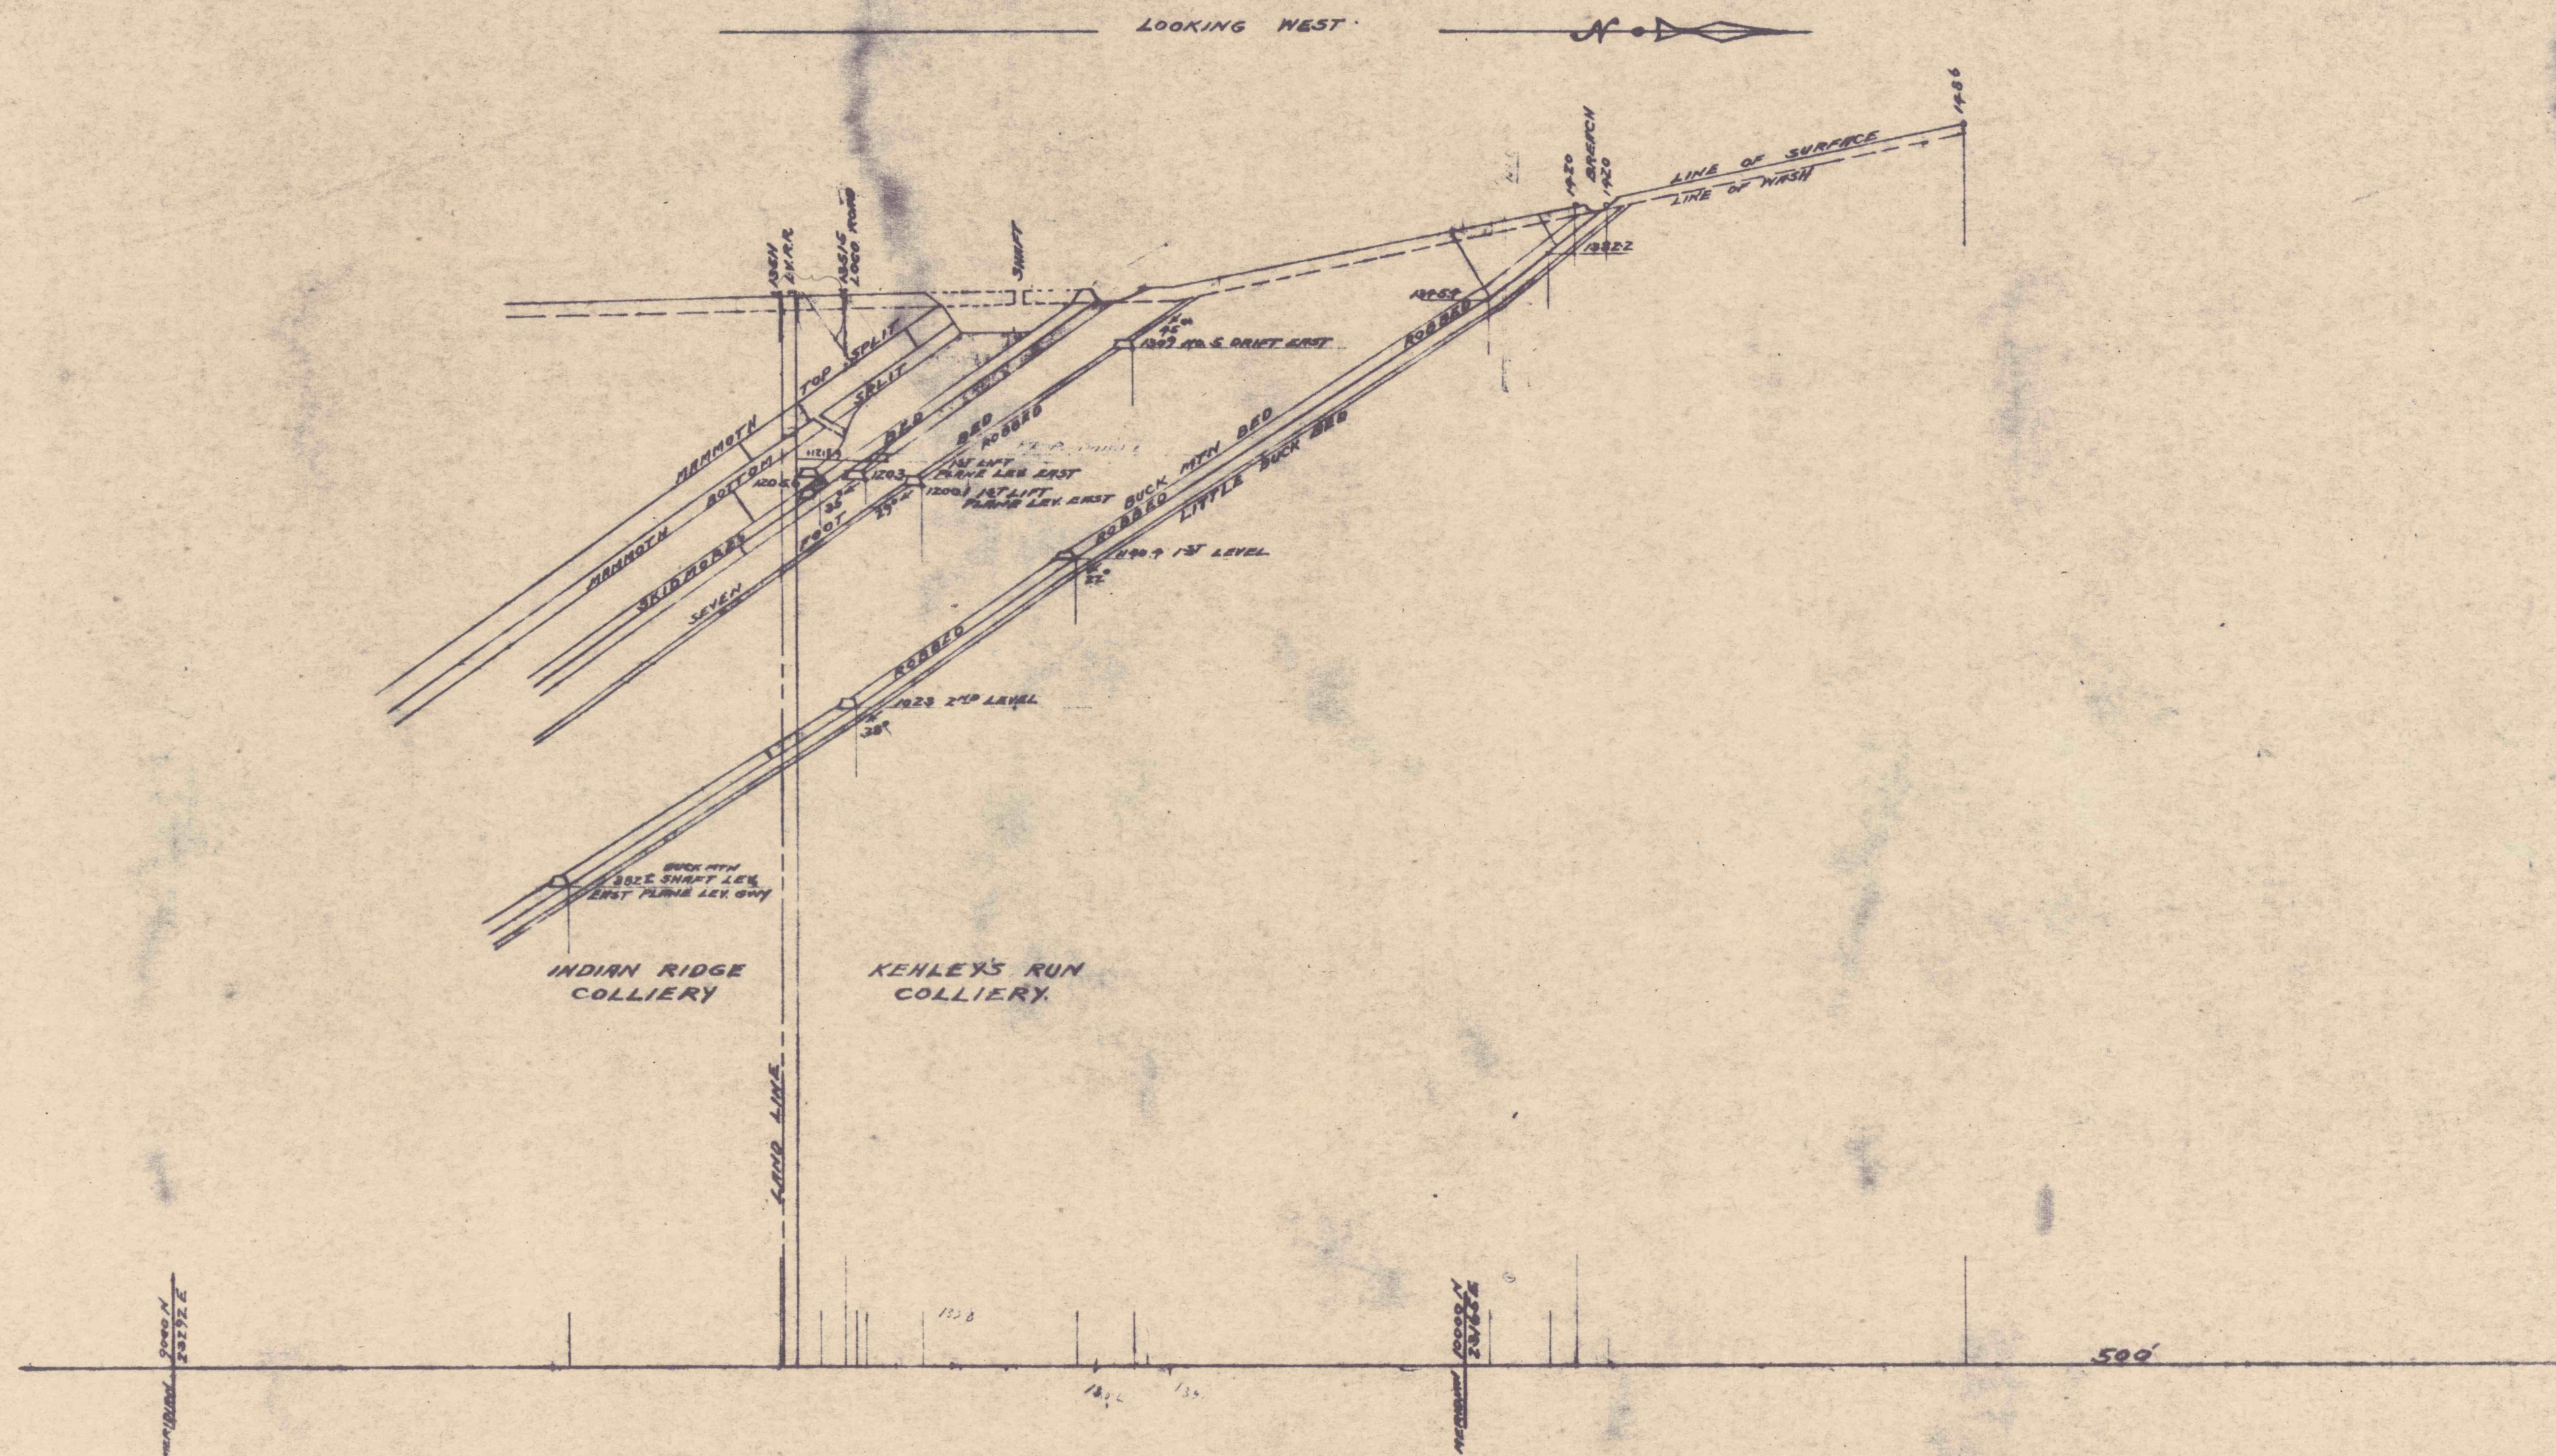

KEHLEY'S RUN COLLIERY.
CROSS SECTION THRO BREAST No. 31 ON FIRST LIFT PLANE LEVEL
EAST BOTTOM SPLIT GANGWAY.

SCALE 1" = 100'

FERRISVILLE, PENNA.

THOMAS COLLIERY COMPANY.
SHENANDOTHS, PA.

JUNE 2, 1917.

101-D